INSET 'A'	INSET 'B'	INSET 'C'	INSET 'D'	INSET 'E'	INSET 'F'

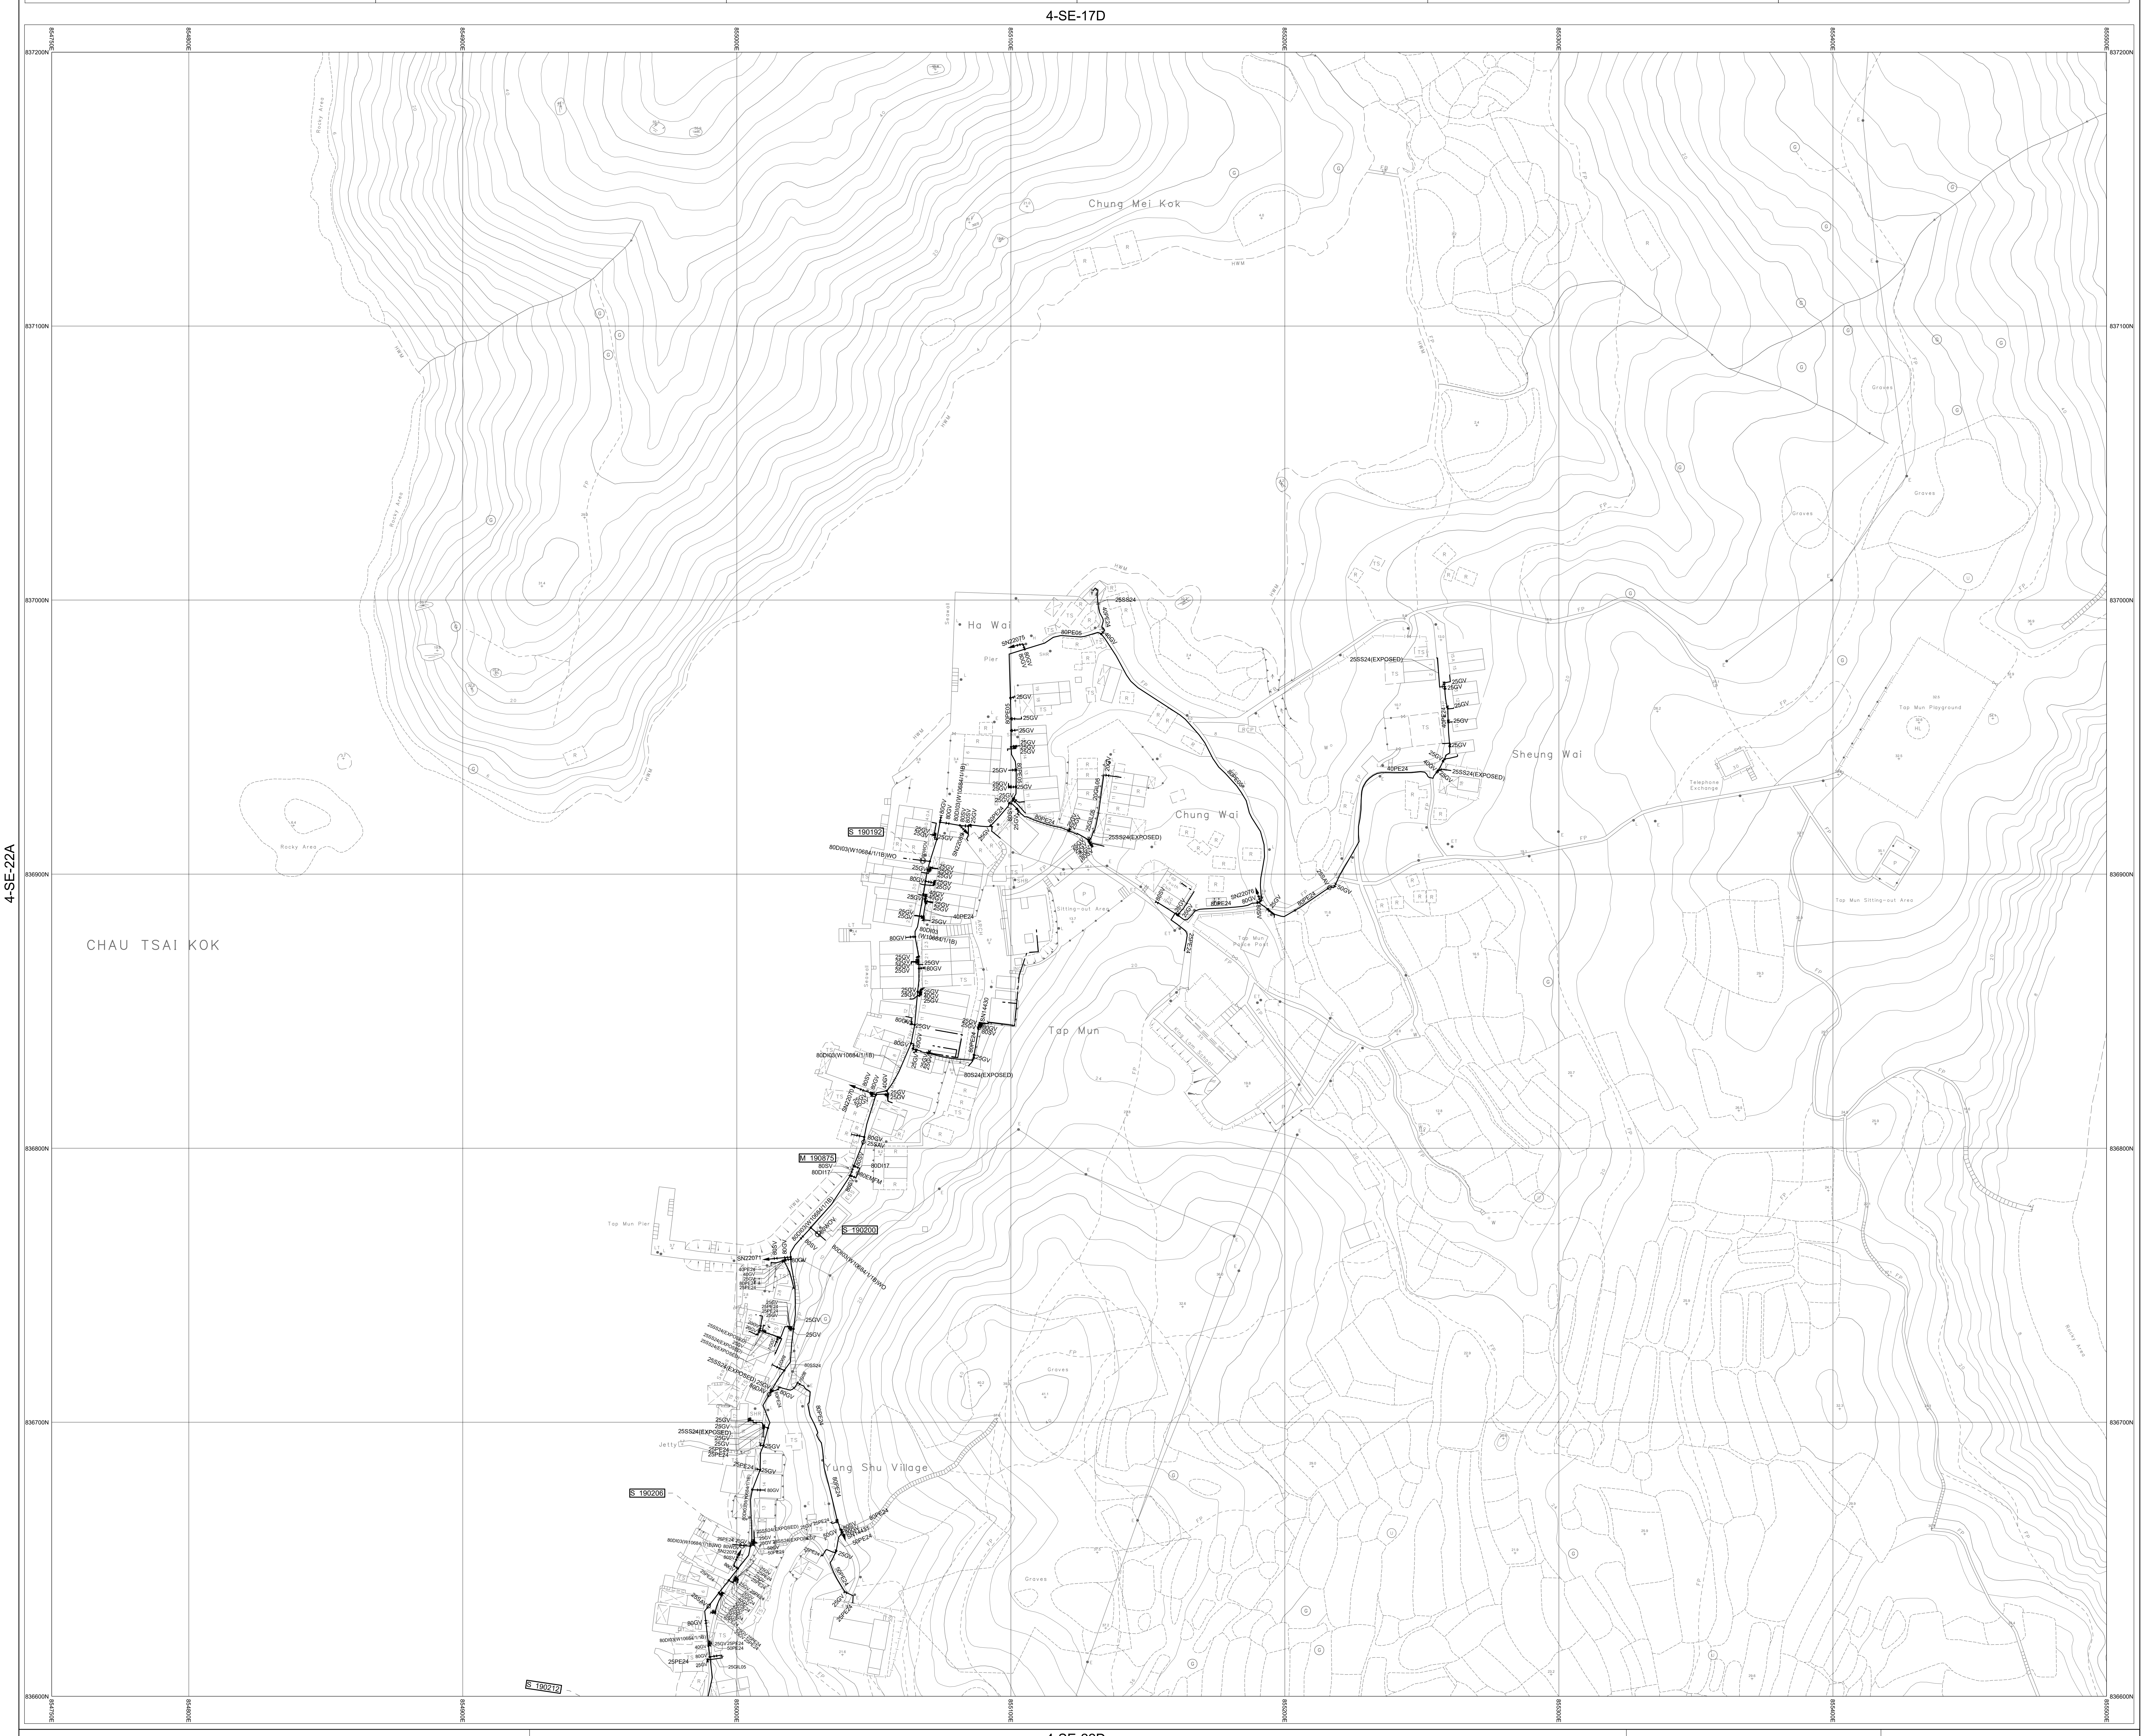
4-SE-17D
4-SE-22A
4-SE-23A
4-SE-22D
837200N
837100N
837000N
836900N
836800N
836700N
836600N
854750E
854800E
854900E
855000E
855100E
855200E
855300E
855400E
855500E
Chung Mei Kok
Ha Wai
Chung Wai
Sheung Wai
Tap Mun
Yung Shu Village
CHAU TSAI KOK
Tap Mun Pier
Jetty
Graves
Tap Mun Playground
Telephone Exchange
S 190192
M 190875
S 190200
S 190206
S 190212
25SS24(EXPOSED)
80PE24
25GV
80GV

NOTES:

1. FOR MAINS RECORDS SIGN CONVENTIONS AND DESIGNATIONS SEE SKETCH NO.3988.
2. DIMENSIONS OF MAINS ARE IN MILLIMETRES UNLESS OTHERWISE SPECIFIED.
3. ALL LEVELS ARE IN METRES ABOVE PRINCIPAL DATUM.

Basemap Date Updated On: 05/01/2026

SCALE 1:1 000

METRES 20 10 0 20 40 60 80 100 METRES

FRESH WATER MAINS RECORD PLAN

TAP MUN ISLAND

THIS IS A COMPUTER PRINTOUT,
NO SIGNATURE IS REQUIRED.

COPYRIGHT RESERVED

DATE REVISED : 03/06/2026

DRAWING NO.

W67880/ 4-SE-22B

SIGNED
C.H. NG
CE/MSE
DATE: 19/07/2001

Water Supplies Department
HONG KONG

© The Government of the Hong Kong SAR, Map reproduced with permission of the Director of Lands