INSET 'A'

INSET 'B'

INSET 'C'

INSET 'D'

INSET 'E'

INSET 'F'

7-SE-20A

7-SE-19D

7-SE-20D

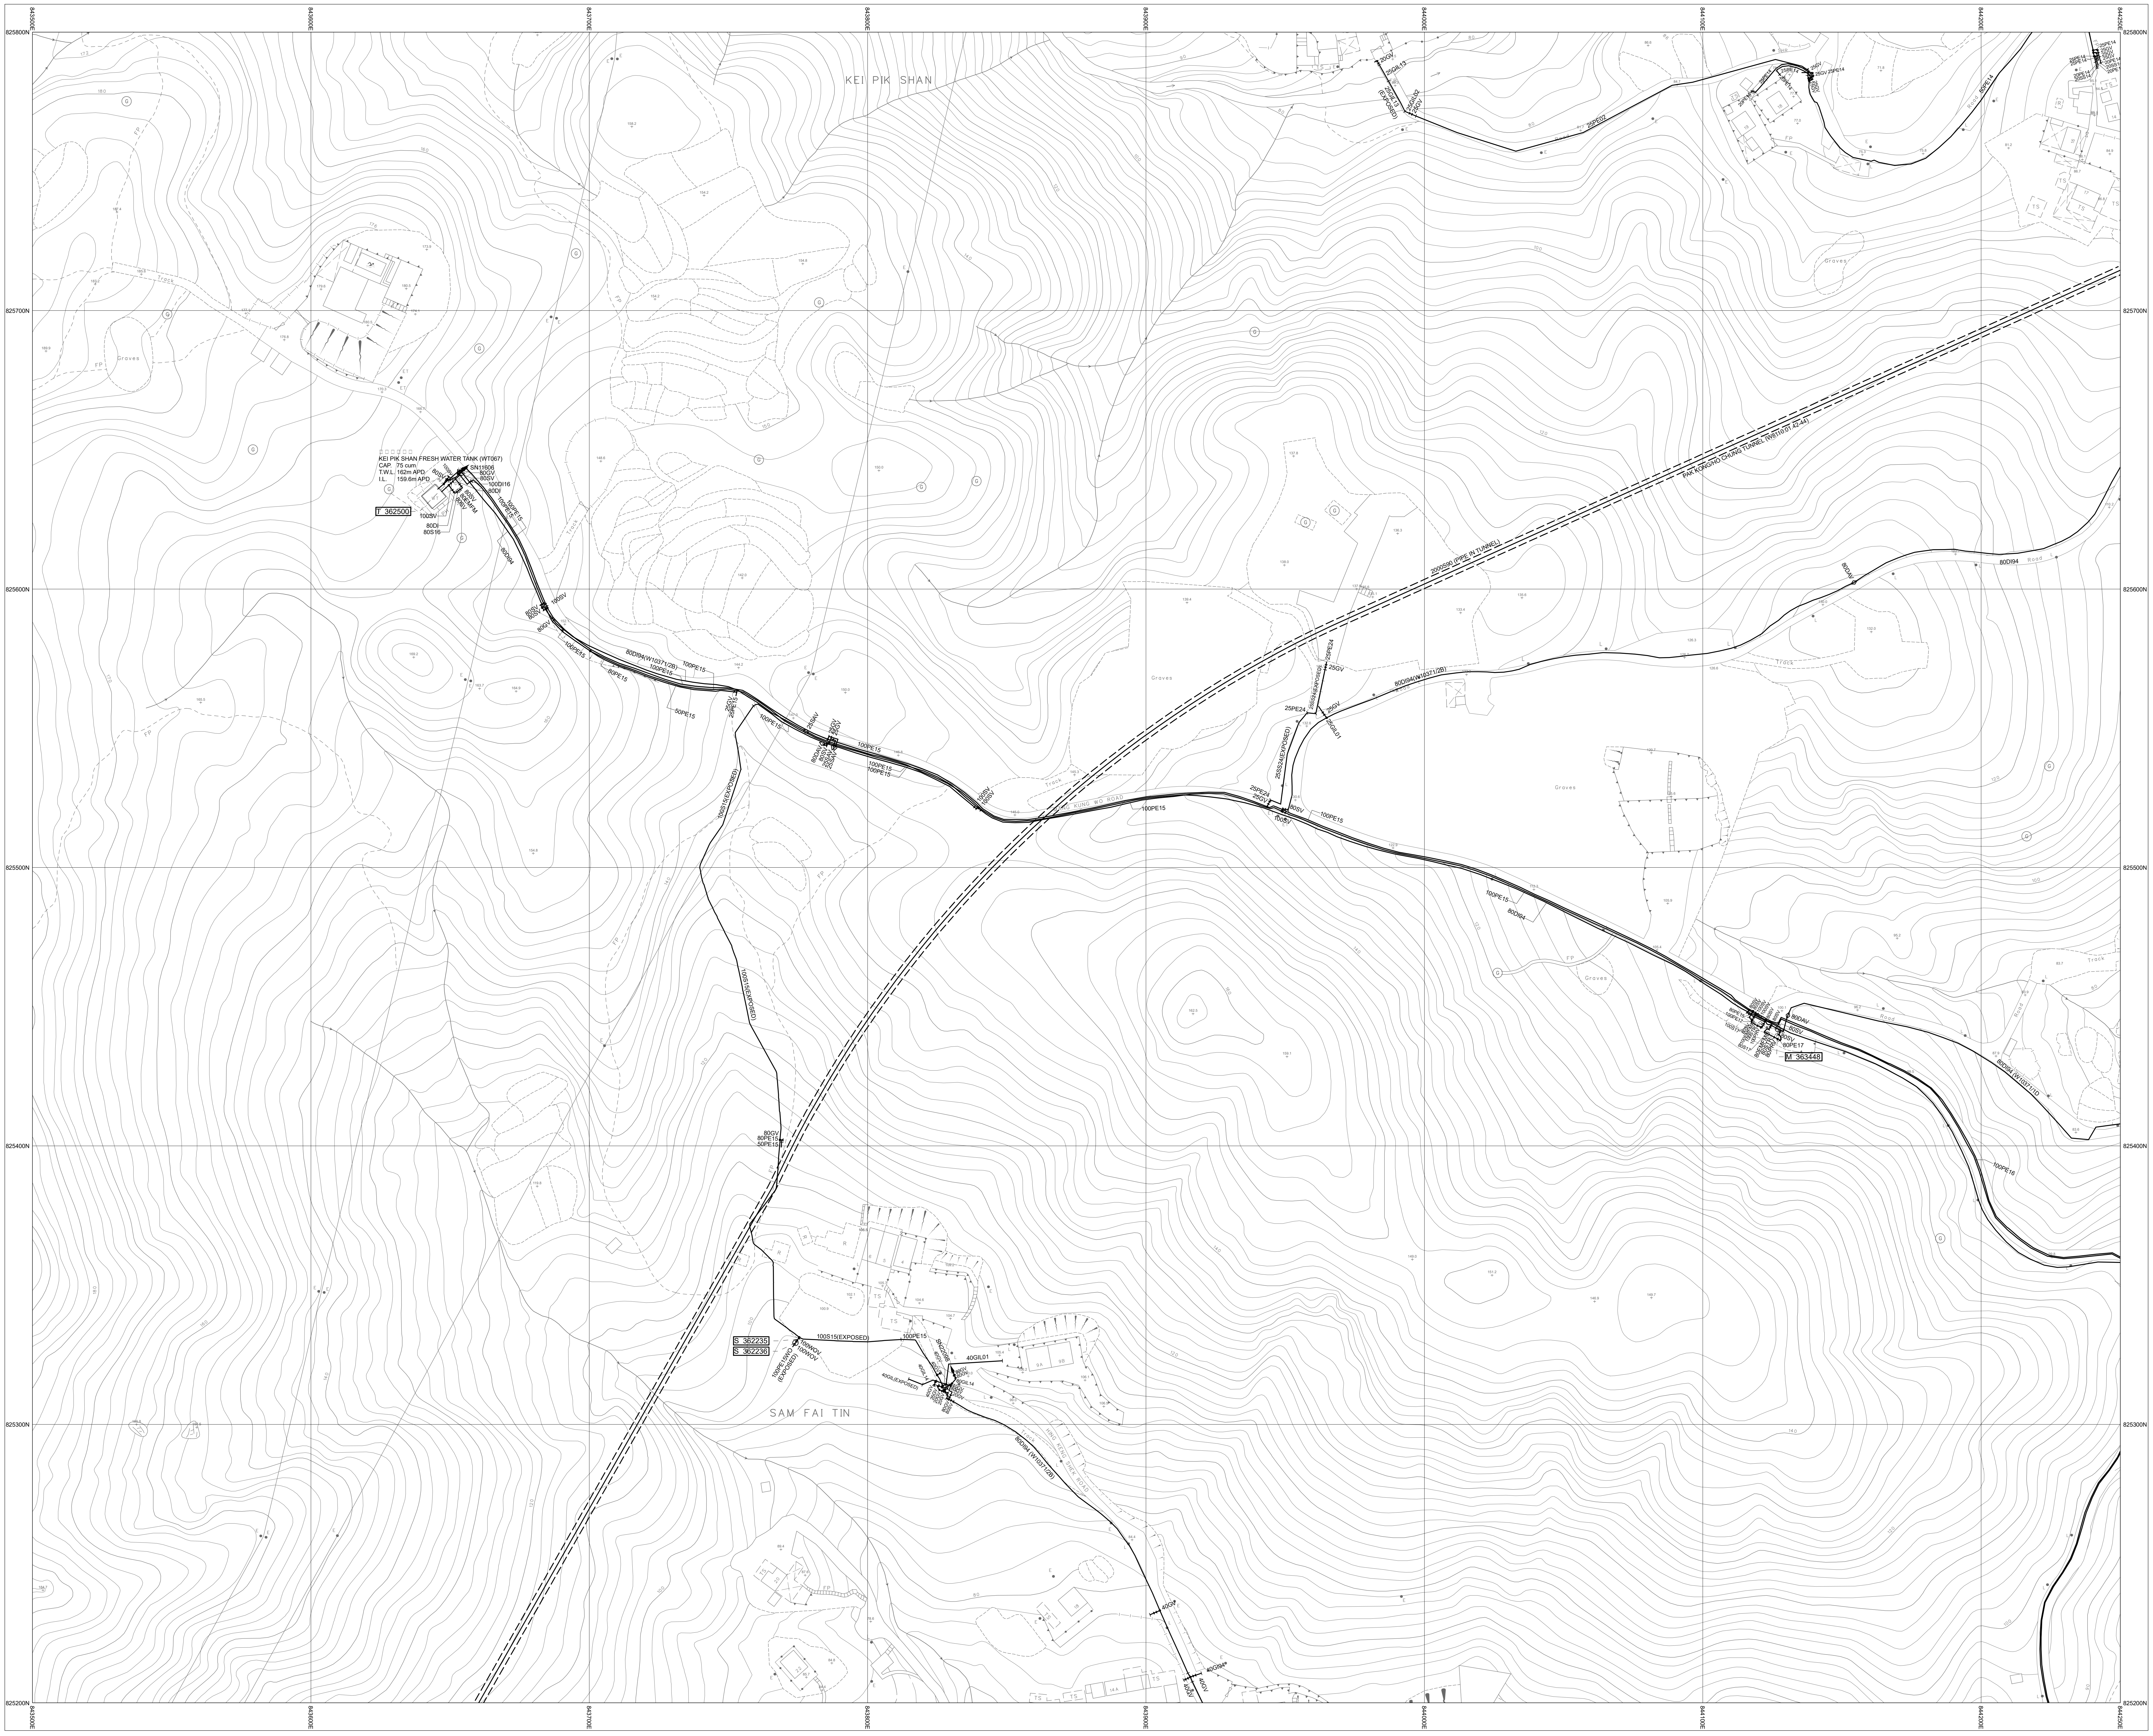
KEI PIK SHAN
SAM FAI TIN
KEI PIK SHAN FRESH WATER TANK (WT067)
CAP. 75 cum
T.W.L. 162m APD
I.L. 159.6m APD
SN11606
T 362500
S 362235
S 362236
M 363448
SN22098
100S15(EXPOSED)
100PE15
80DI94 (W10371/2B)
80DAV
80PE17
40GIL01
Groves
Road
Track
825200N
825300N
825400N
825500N
825600N
825700N
825800N

7-SE-25A

NOTES:

1. FOR MAINS RECORDS SIGN CONVENTIONS AND DESIGNATIONS SEE SKETCH NO.3988.
2. DIMENSIONS OF MAINS ARE IN MILLIMETRES UNLESS OTHERWISE SPECIFIED.
3. ALL LEVELS ARE IN METRES ABOVE PRINCIPAL DATUM.

Basemap Date Updated On: 05/01/2026

SCALE 1:1 000

METRES 20 10 0 20 40 60 80 100 METRES

THIS IS A COMPUTER PRINTOUT,
NO SIGNATURE IS REQUIRED.

FRESH WATER MAINS RECORD PLAN

KEI PIK SHAN , SAM FAI TIN

COPYRIGHT RESERVED

DATE REVISED : 02/03/2026

DRAWING NO.

W67880/ 7-SE-20C

SIGNED
C.H. NG
CE/MSE
DATE: 13/05/1999

Water Supplies Department
HONG KONG

© The Government of the Hong Kong SAR, Map reproduced with permission of the Director of Lands