INSET 'A'	INSET 'B'	INSET 'C'	INSET 'D'	INSET 'E'	INSET 'F'

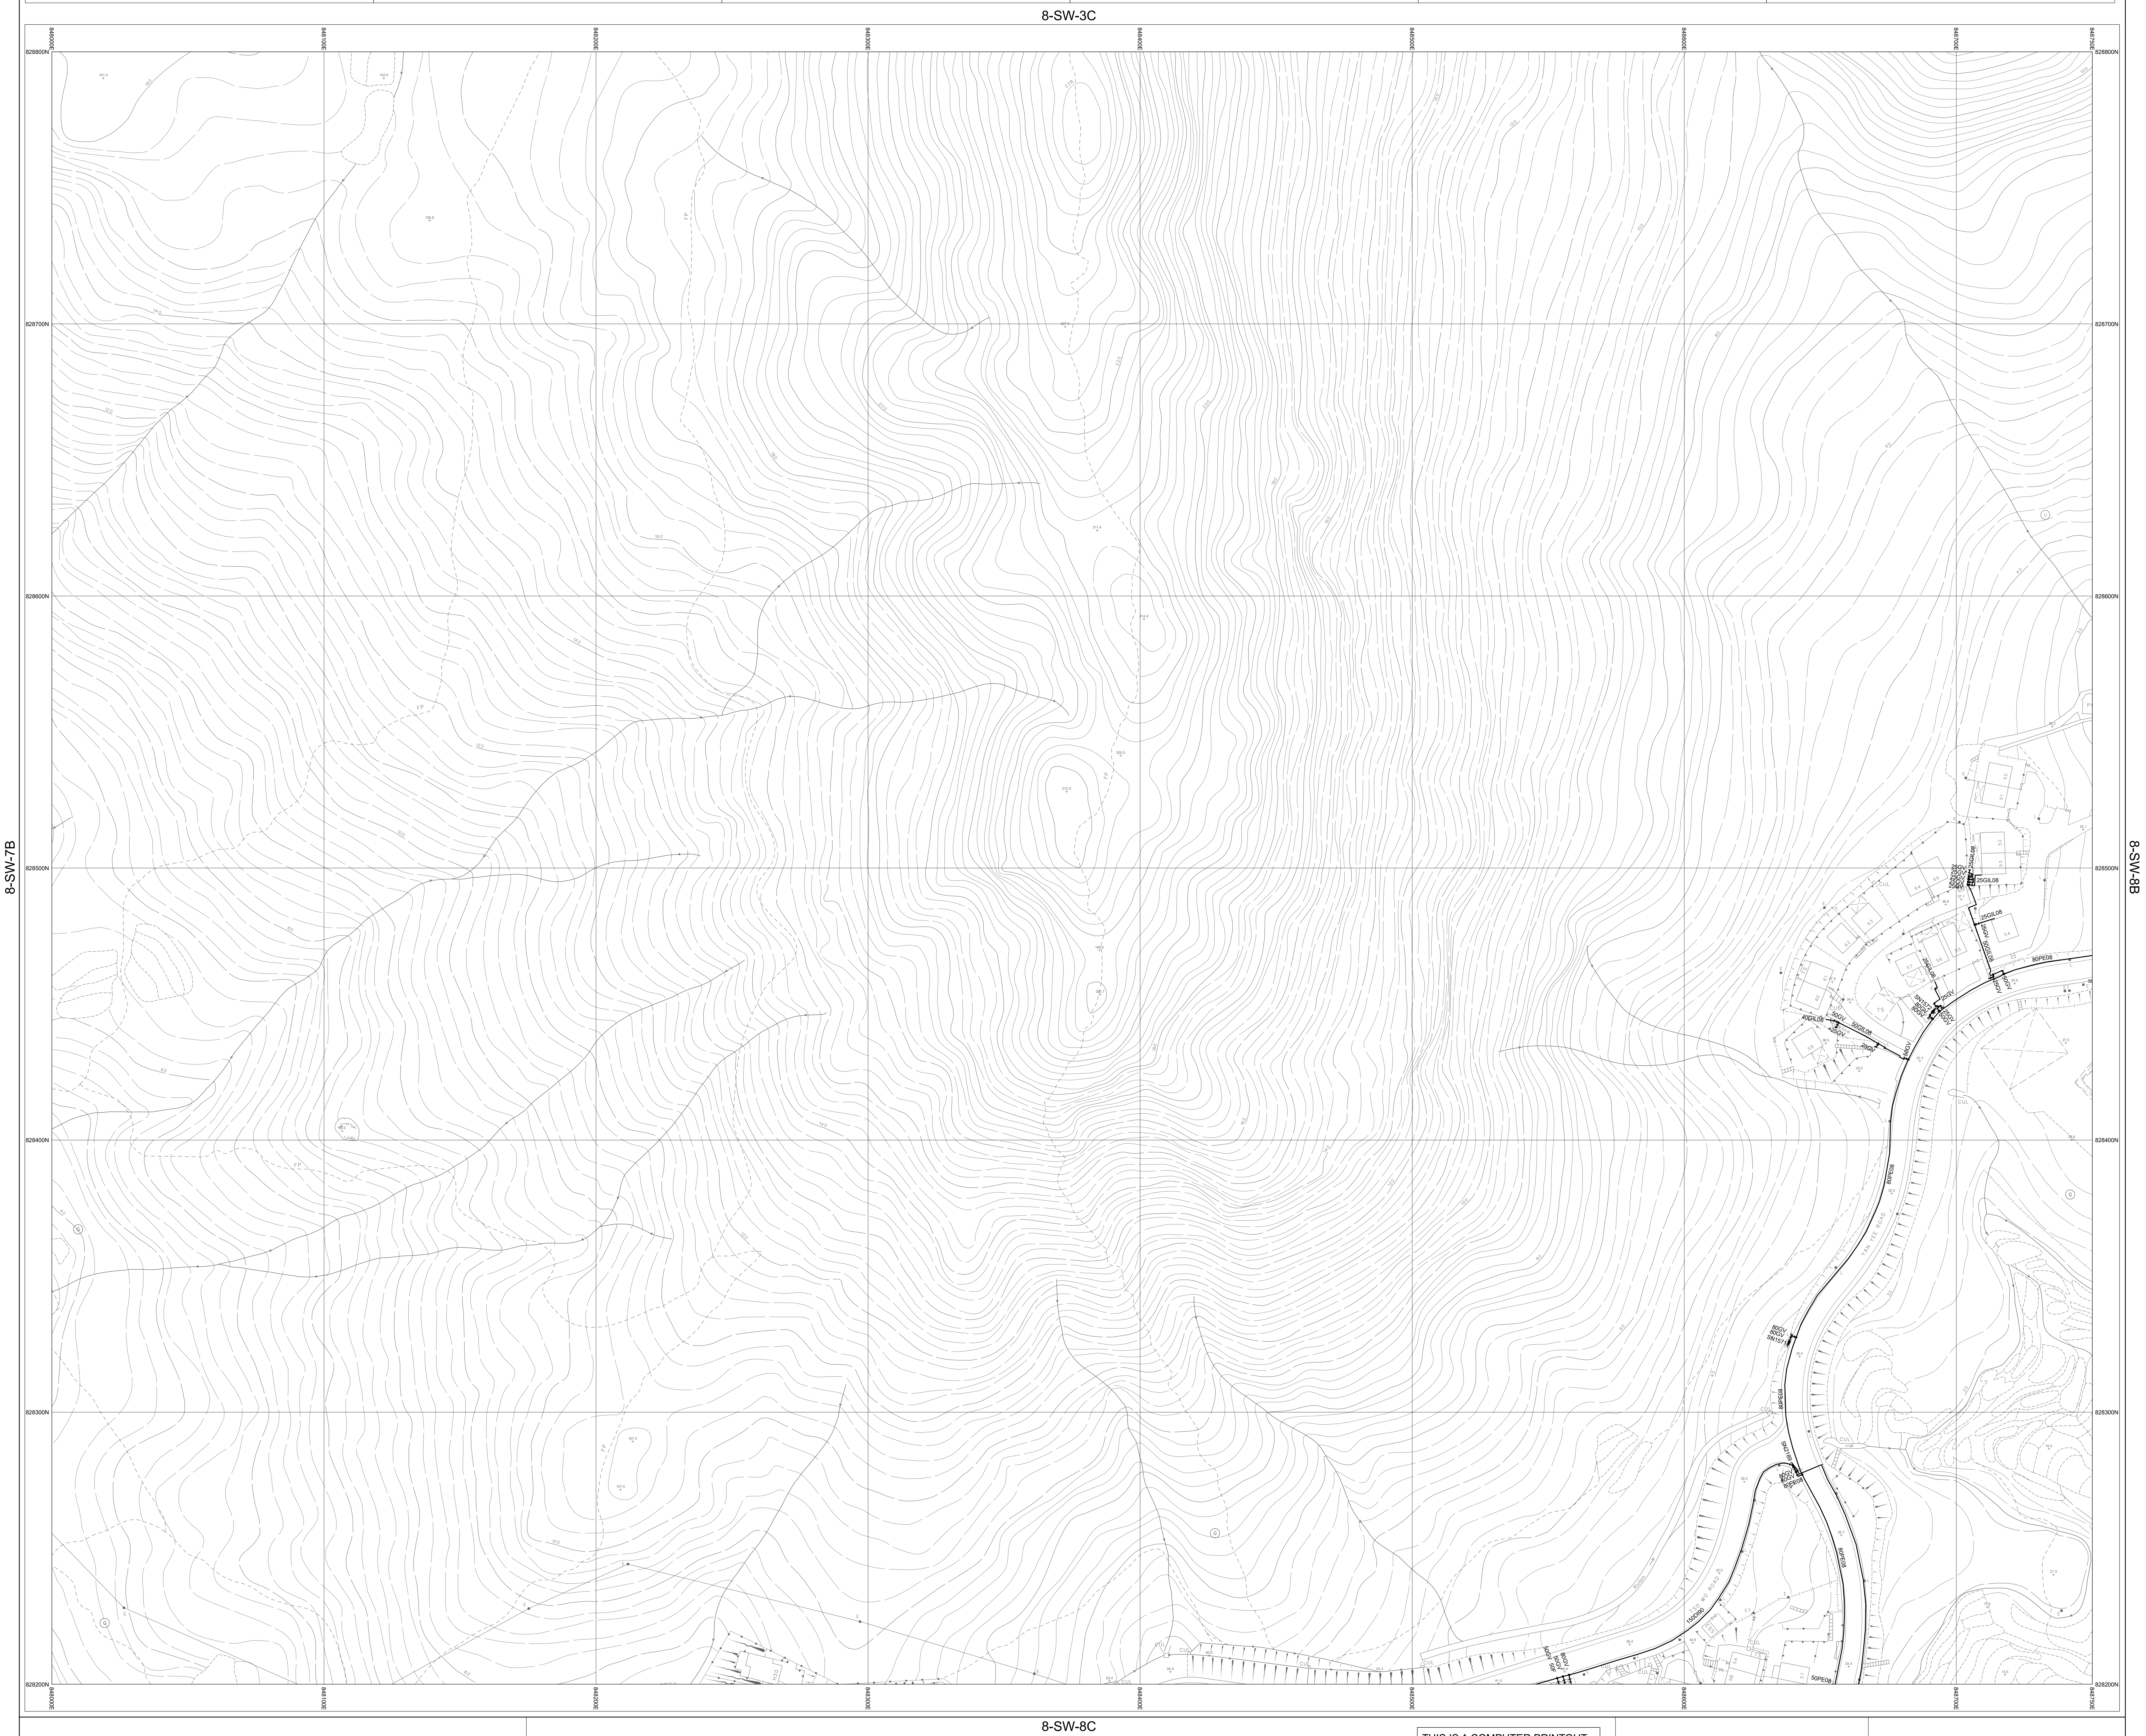
8-SW-3C
8-SW-7B
8-SW-8B
8-SW-8C
848000E
848100E
848200E
848300E
848400E
848500E
848600E
848700E
848750E
828800N
828700N
828600N
828500N
828400N
828300N
828200N
25GV
25GIL08
50GIL08
80PE08
50GV
SN1572
80GV
CUL
TS
G

NOTES:

1. FOR MAINS RECORDS SIGN CONVENTIONS AND DESIGNATIONS SEE SKETCH NO.3988.
2. DIMENSIONS OF MAINS ARE IN MILLIMETRES UNLESS OTHERWISE SPECIFIED.
3. ALL LEVELS ARE IN METRES ABOVE PRINCIPAL DATUM.

Basemap Date Updated On: 23/12/2024

SCALE 1:1 000

METRES 20 10 0 20 40 60 80 100 METRES

THIS IS A COMPUTER PRINTOUT,
NO SIGNATURE IS REQUIRED.

FRESH WATER MAINS RECORD PLAN

YAN YEE ROAD, TAI MONG TSAI

COPYRIGHT RESERVED

DATE REVISED : 31/12/2024

DRAWING NO.

W67880/ 8-SW-8A

SIGNED

C.H. NG
CE/MSE

DATE: 13/05/1999

Water Supplies Department
HONG KONG

© The Government of the Hong Kong SAR, Map reproduced with permission of the Director of Lands