INSET 'A'	INSET 'B'	INSET 'C'	INSET 'D'	INSET 'E'	INSET 'F'

8-SW-15B

8-SW-15C

8-SE-11C

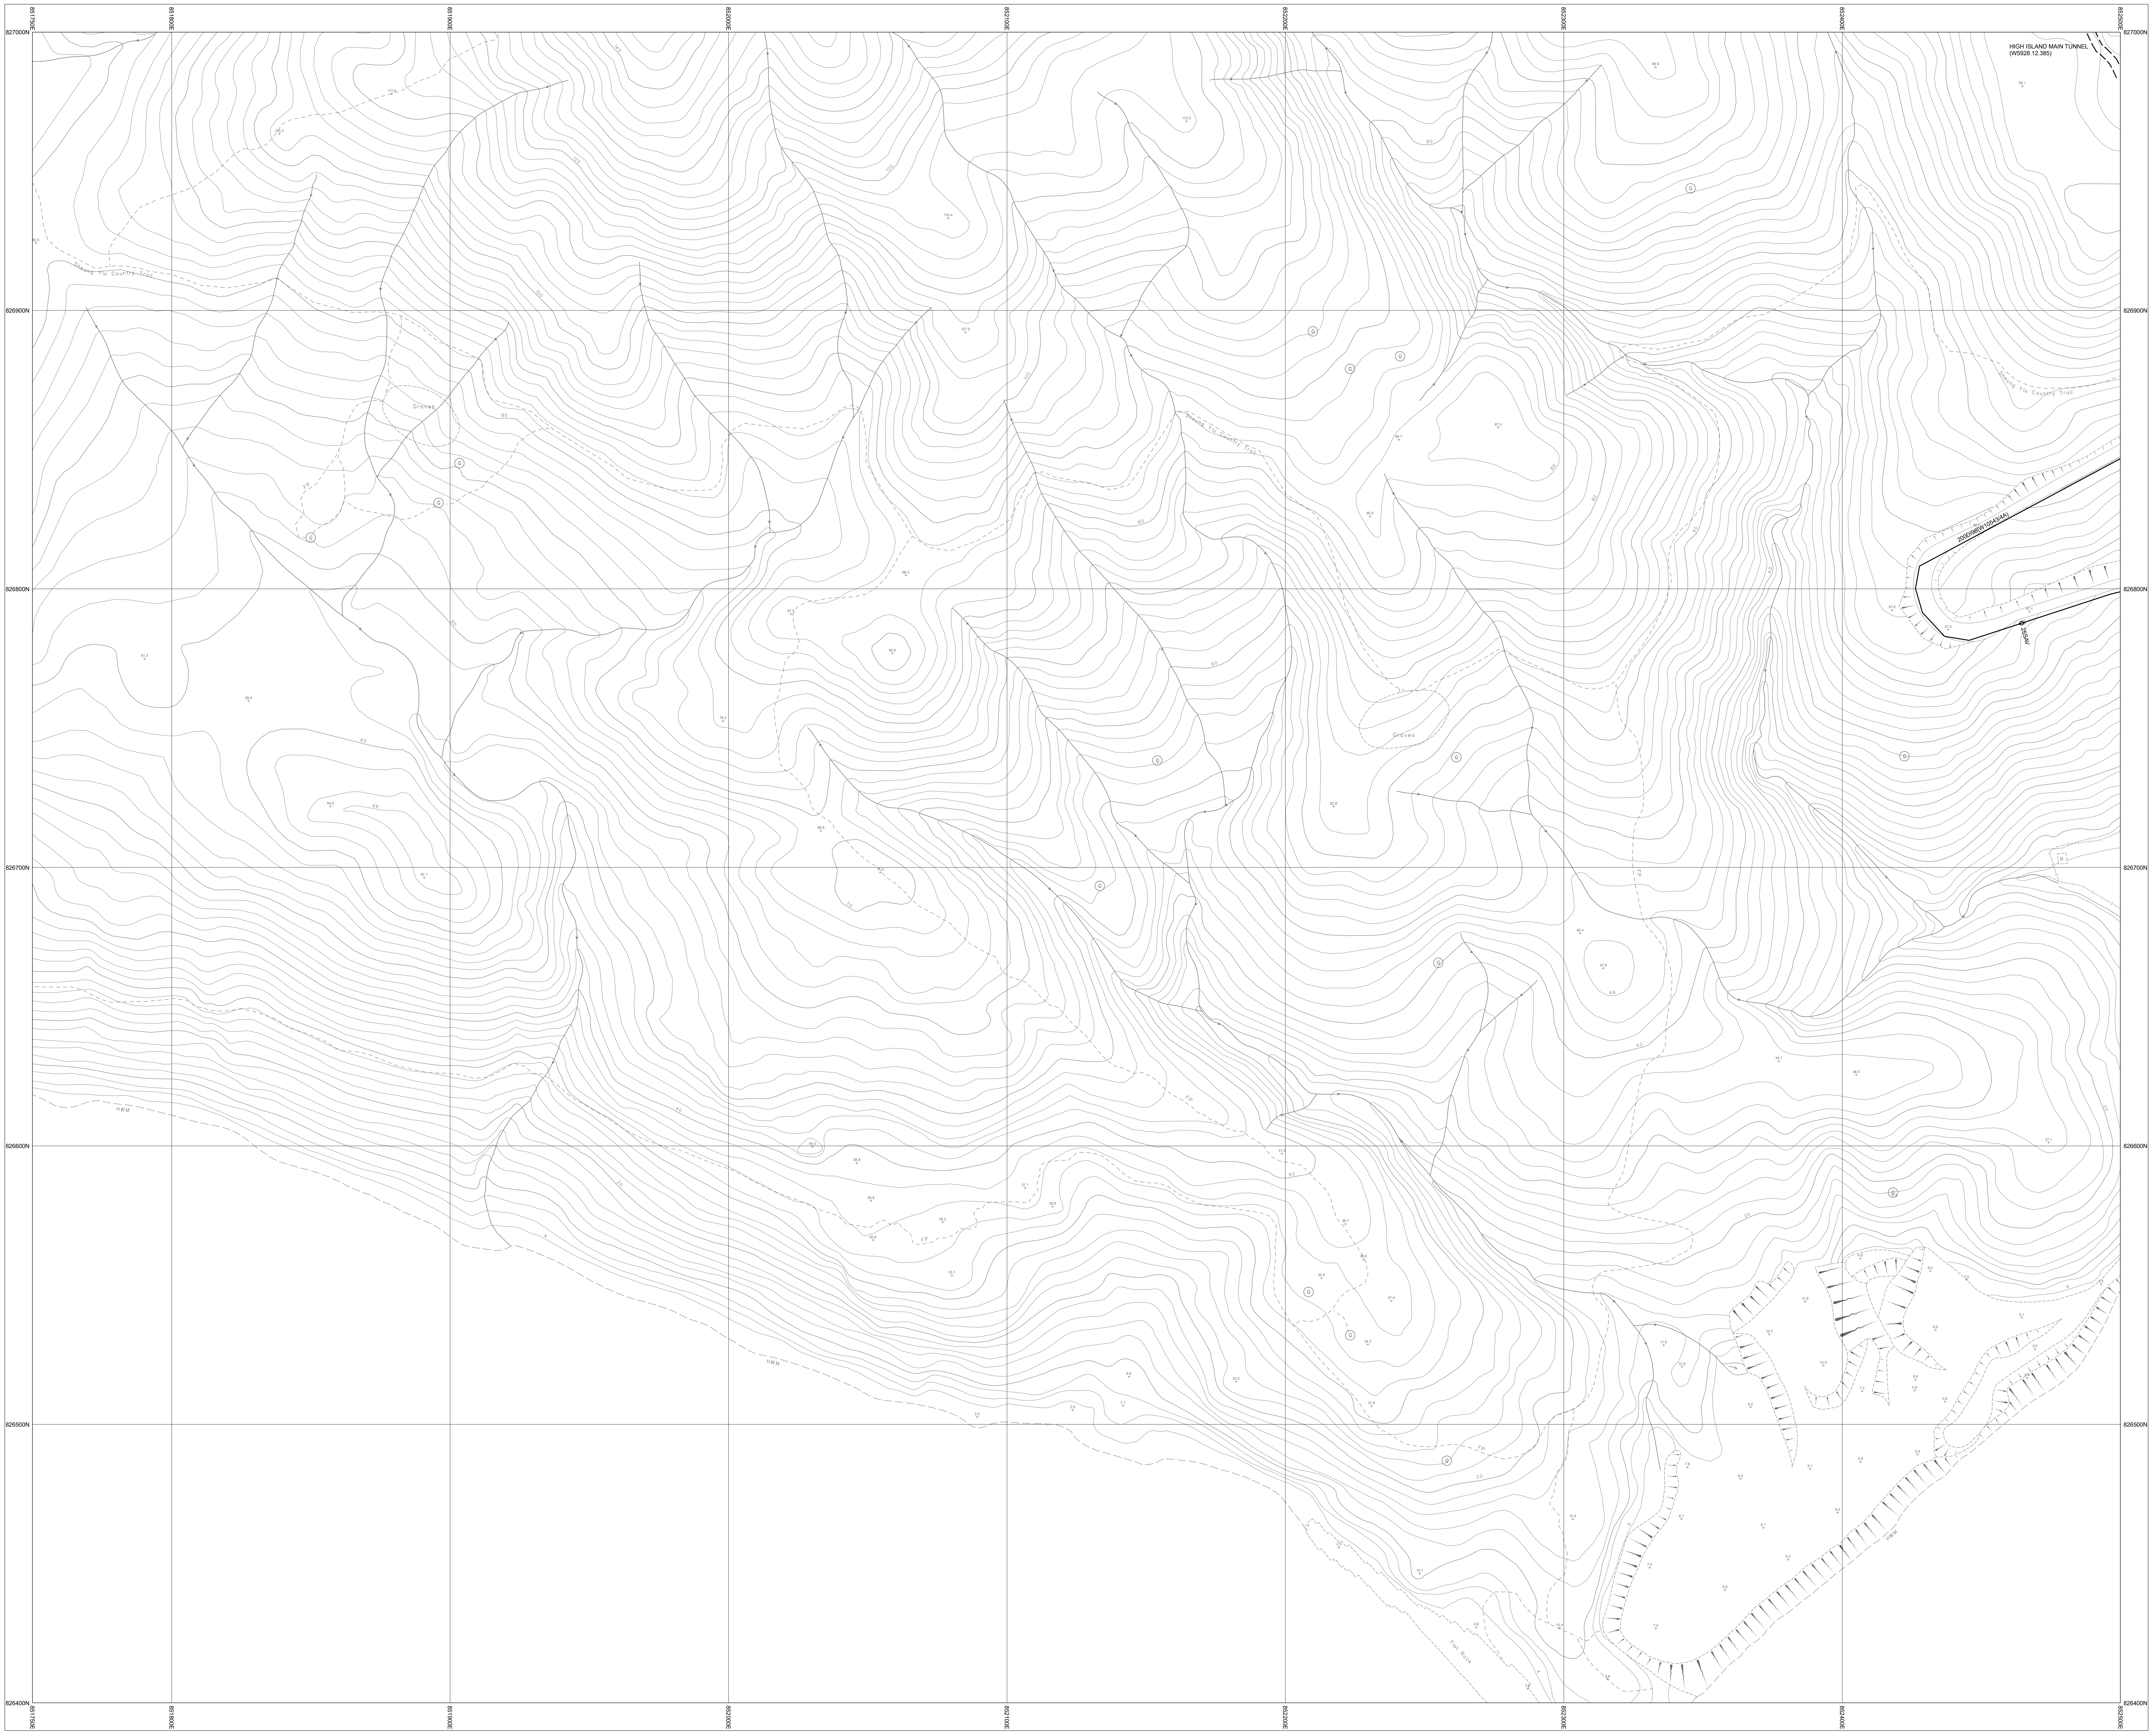
827000N
826900N
826800N
826700N
826600N
826500N
826400N
851750E
851800E
851900E
852000E
852100E
852200E
852300E
852400E
852500E
HIGH ISLAND MAIN TUNNEL
(W5928.12.385)
200DI98(W10543/4A)
25SAV
Sheung Yiu Country Trail
Graves
99.1
56.0
57.6
51.3
47.1

8-SW-20B

NOTES:
1. FOR MAINS RECORDS SIGN CONVENTIONS AND DESIGNATIONS SEE SKETCH NO.3988.
2. DIMENSIONS OF MAINS ARE IN MILLIMETRES UNLESS OTHERWISE SPECIFIED.
3. ALL LEVELS ARE IN METRES ABOVE PRINCIPAL DATUM.

Basemap Date Updated On: 23/12/2024

SCALE 1:1 000

METRES 20 10 0 20 40 60 80 100 METRES

THIS IS A COMPUTER PRINTOUT,
NO SIGNATURE IS REQUIRED.

FRESH WATER MAINS RECORD PLAN

WSD TUNNEL, NAM FUNG WAN

COPYRIGHT RESERVED

DATE REVISED : 31/12/2024

DRAWING NO.
W67880/ 8-SW-15D

SIGNED
C.H. NG
CE/MSE
DATE: 13/05/1999

Water Supplies Department
HONG KONG

© The Government of the Hong Kong SAR, Map reproduced with permission of the Director of Lands