INSET 'A'	INSET 'B'	INSET 'C'	INSET 'D'	INSET 'E'	INSET 'F'

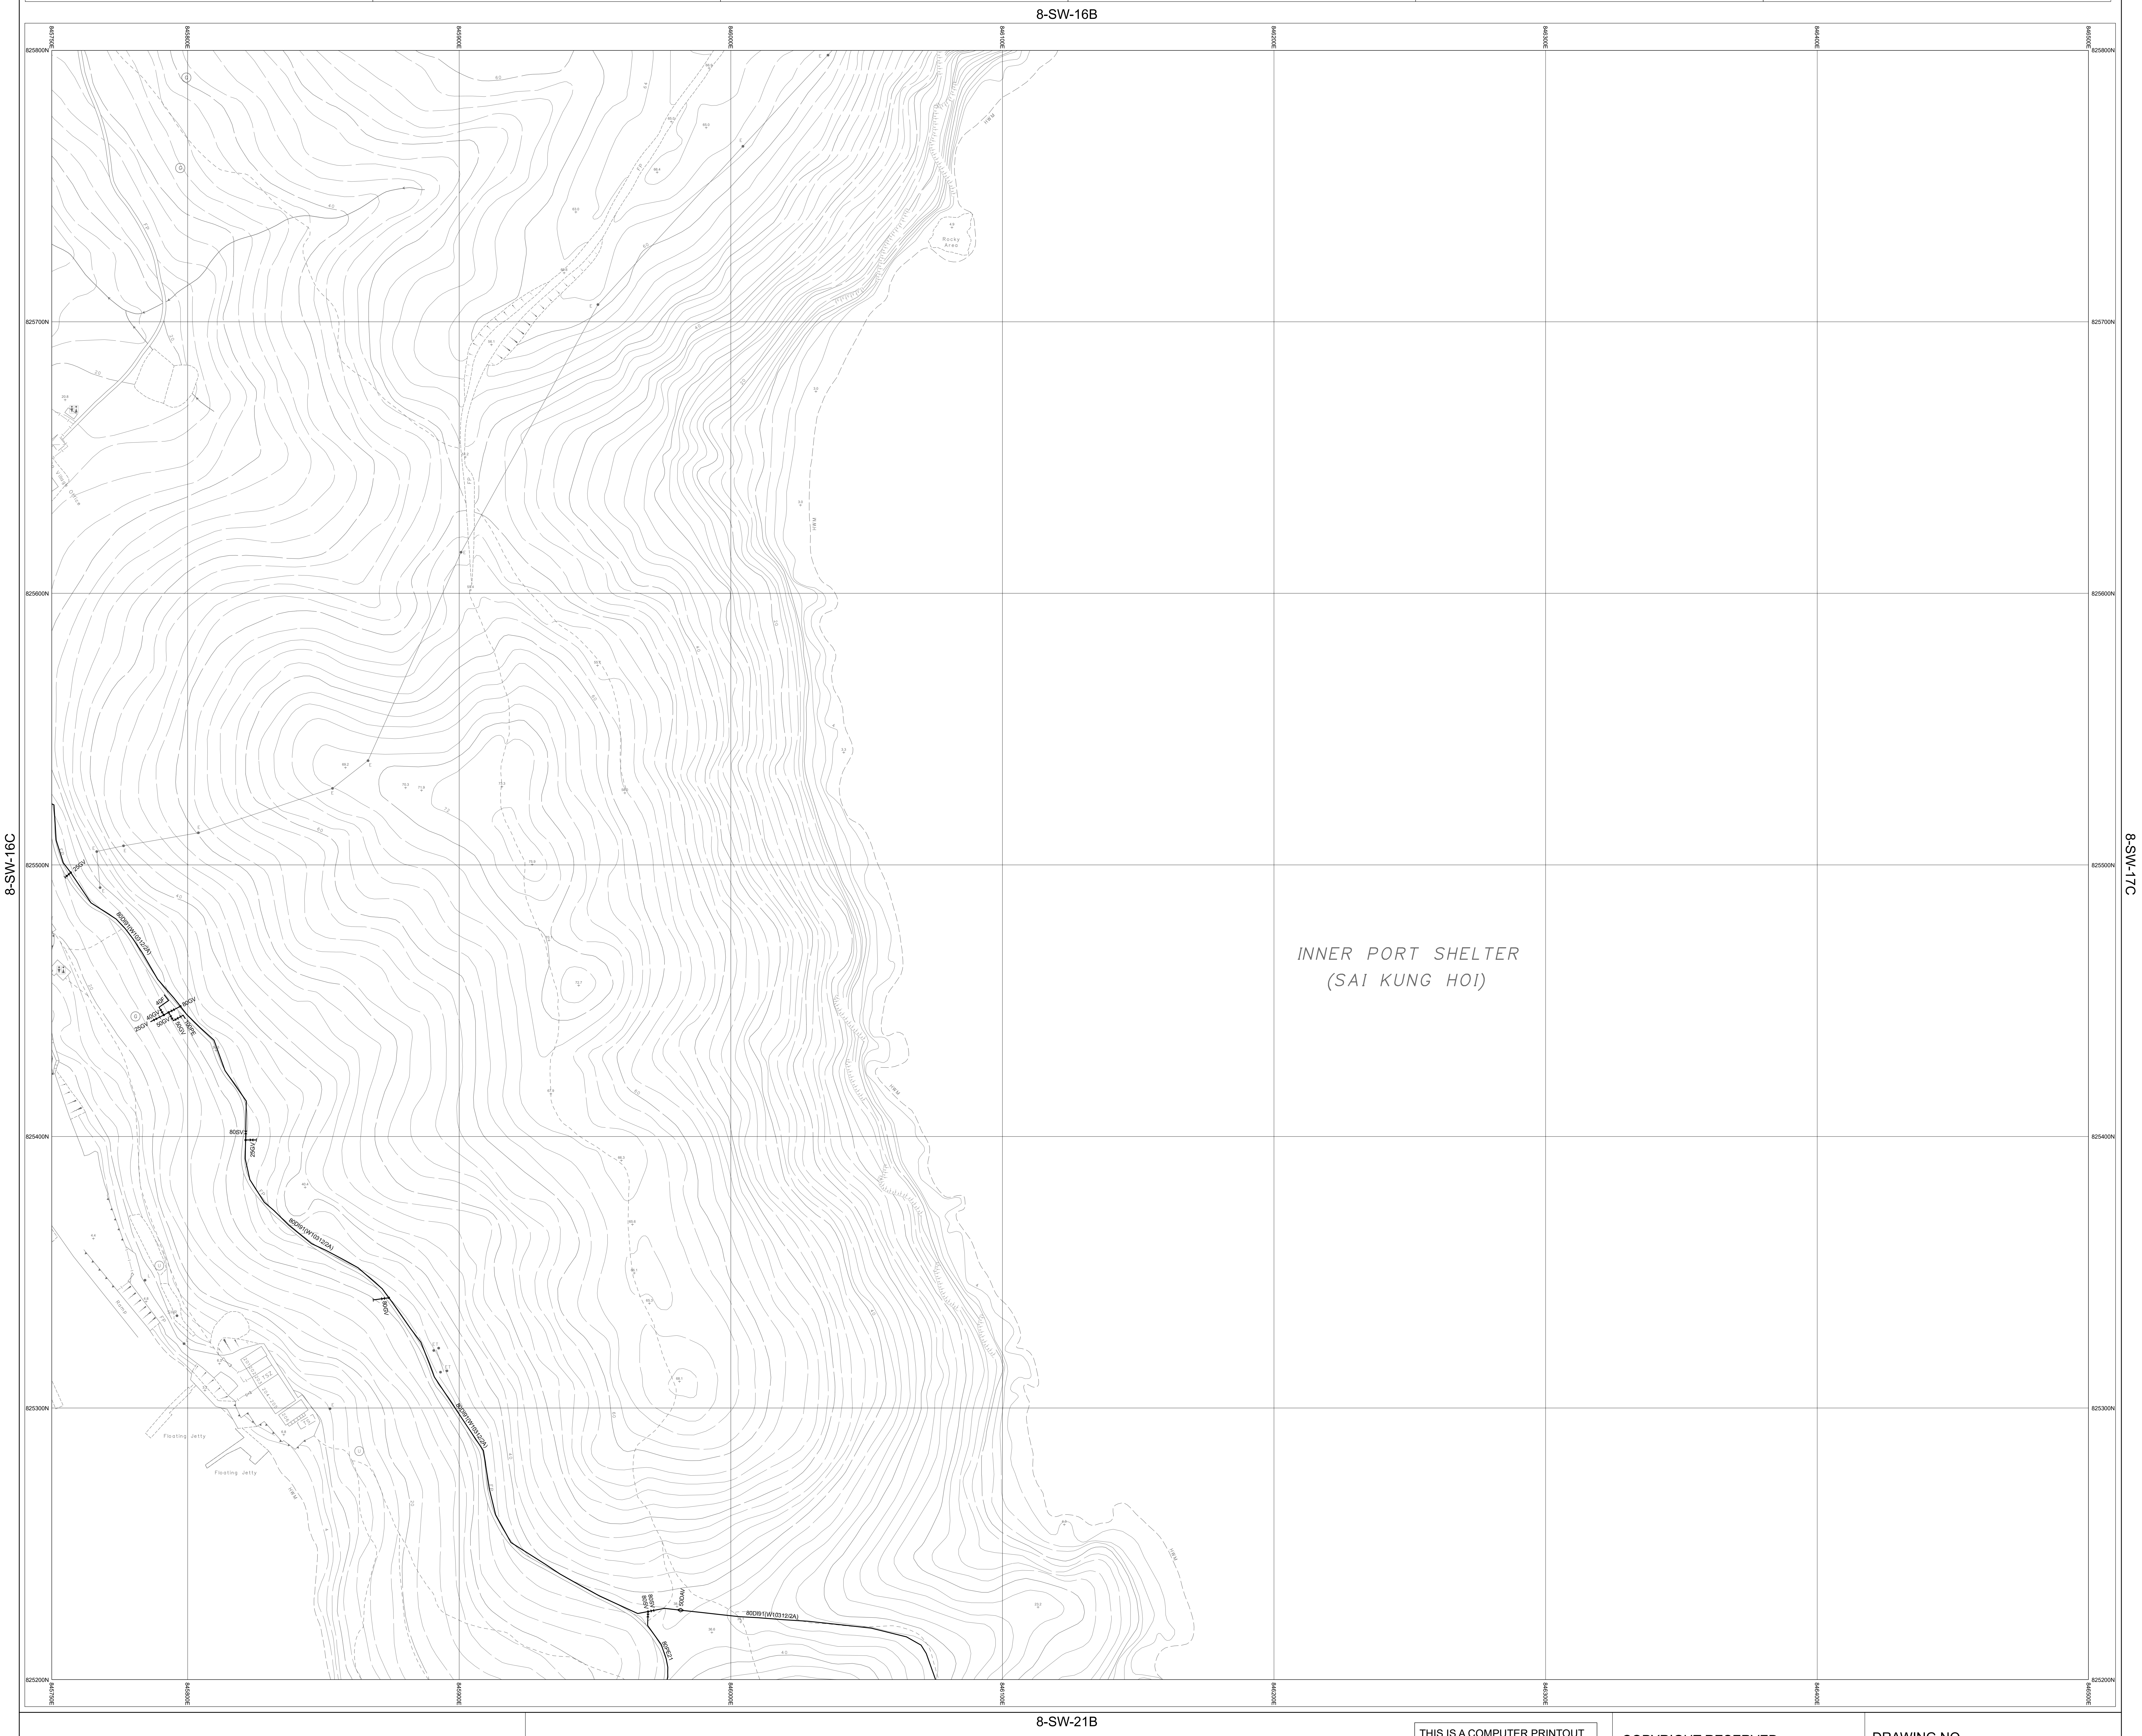
8-SW-16B
8-SW-16C
8-SW-17C
8-SW-21B
INNER PORT SHELTER
(SAI KUNG HOI)
825800N
825700N
825600N
825500N
825400N
825300N
825200N
845750E
845800E
845900E
846000E
846100E
25GV
80DI91(W10312/2A)
40F
40GV
80GV
25GV
50GV
50GV
100PE
80SV
25GV
80GV
80SV
80SV
50DA
80PE21
Floating Jetty
Floating Jetty
Ramp
HWM
Rocky Area

NOTES:
1. FOR MAINS RECORDS SIGN CONVENTIONS AND DESIGNATIONS SEE SKETCH NO.3988.
2. DIMENSIONS OF MAINS ARE IN MILLIMETRES UNLESS OTHERWISE SPECIFIED.
3. ALL LEVELS ARE IN METRES ABOVE PRINCIPAL DATUM.

Basemap Date Updated On: 23/12/2024

SCALE 1:1 000

METRES 20 10 0 20 40 60 80 100 METRES

THIS IS A COMPUTER PRINTOUT,
NO SIGNATURE IS REQUIRED.

FRESH WATER MAINS RECORD PLAN

SAI KUNG HOI

COPYRIGHT RESERVED

DATE REVISED : 05/03/2025

SIGNED
C.H. NG
CE/MSE
DATE: 13/05/1999

DRAWING NO.
W67880/ 8-SW-16D

Water Supplies Department
HONG KONG

© The Government of the Hong Kong SAR, Map reproduced with permission of the Director of Lands