INSET 'A'	INSET 'B'	INSET 'C'	INSET 'D'	INSET 'E'	INSET 'F'

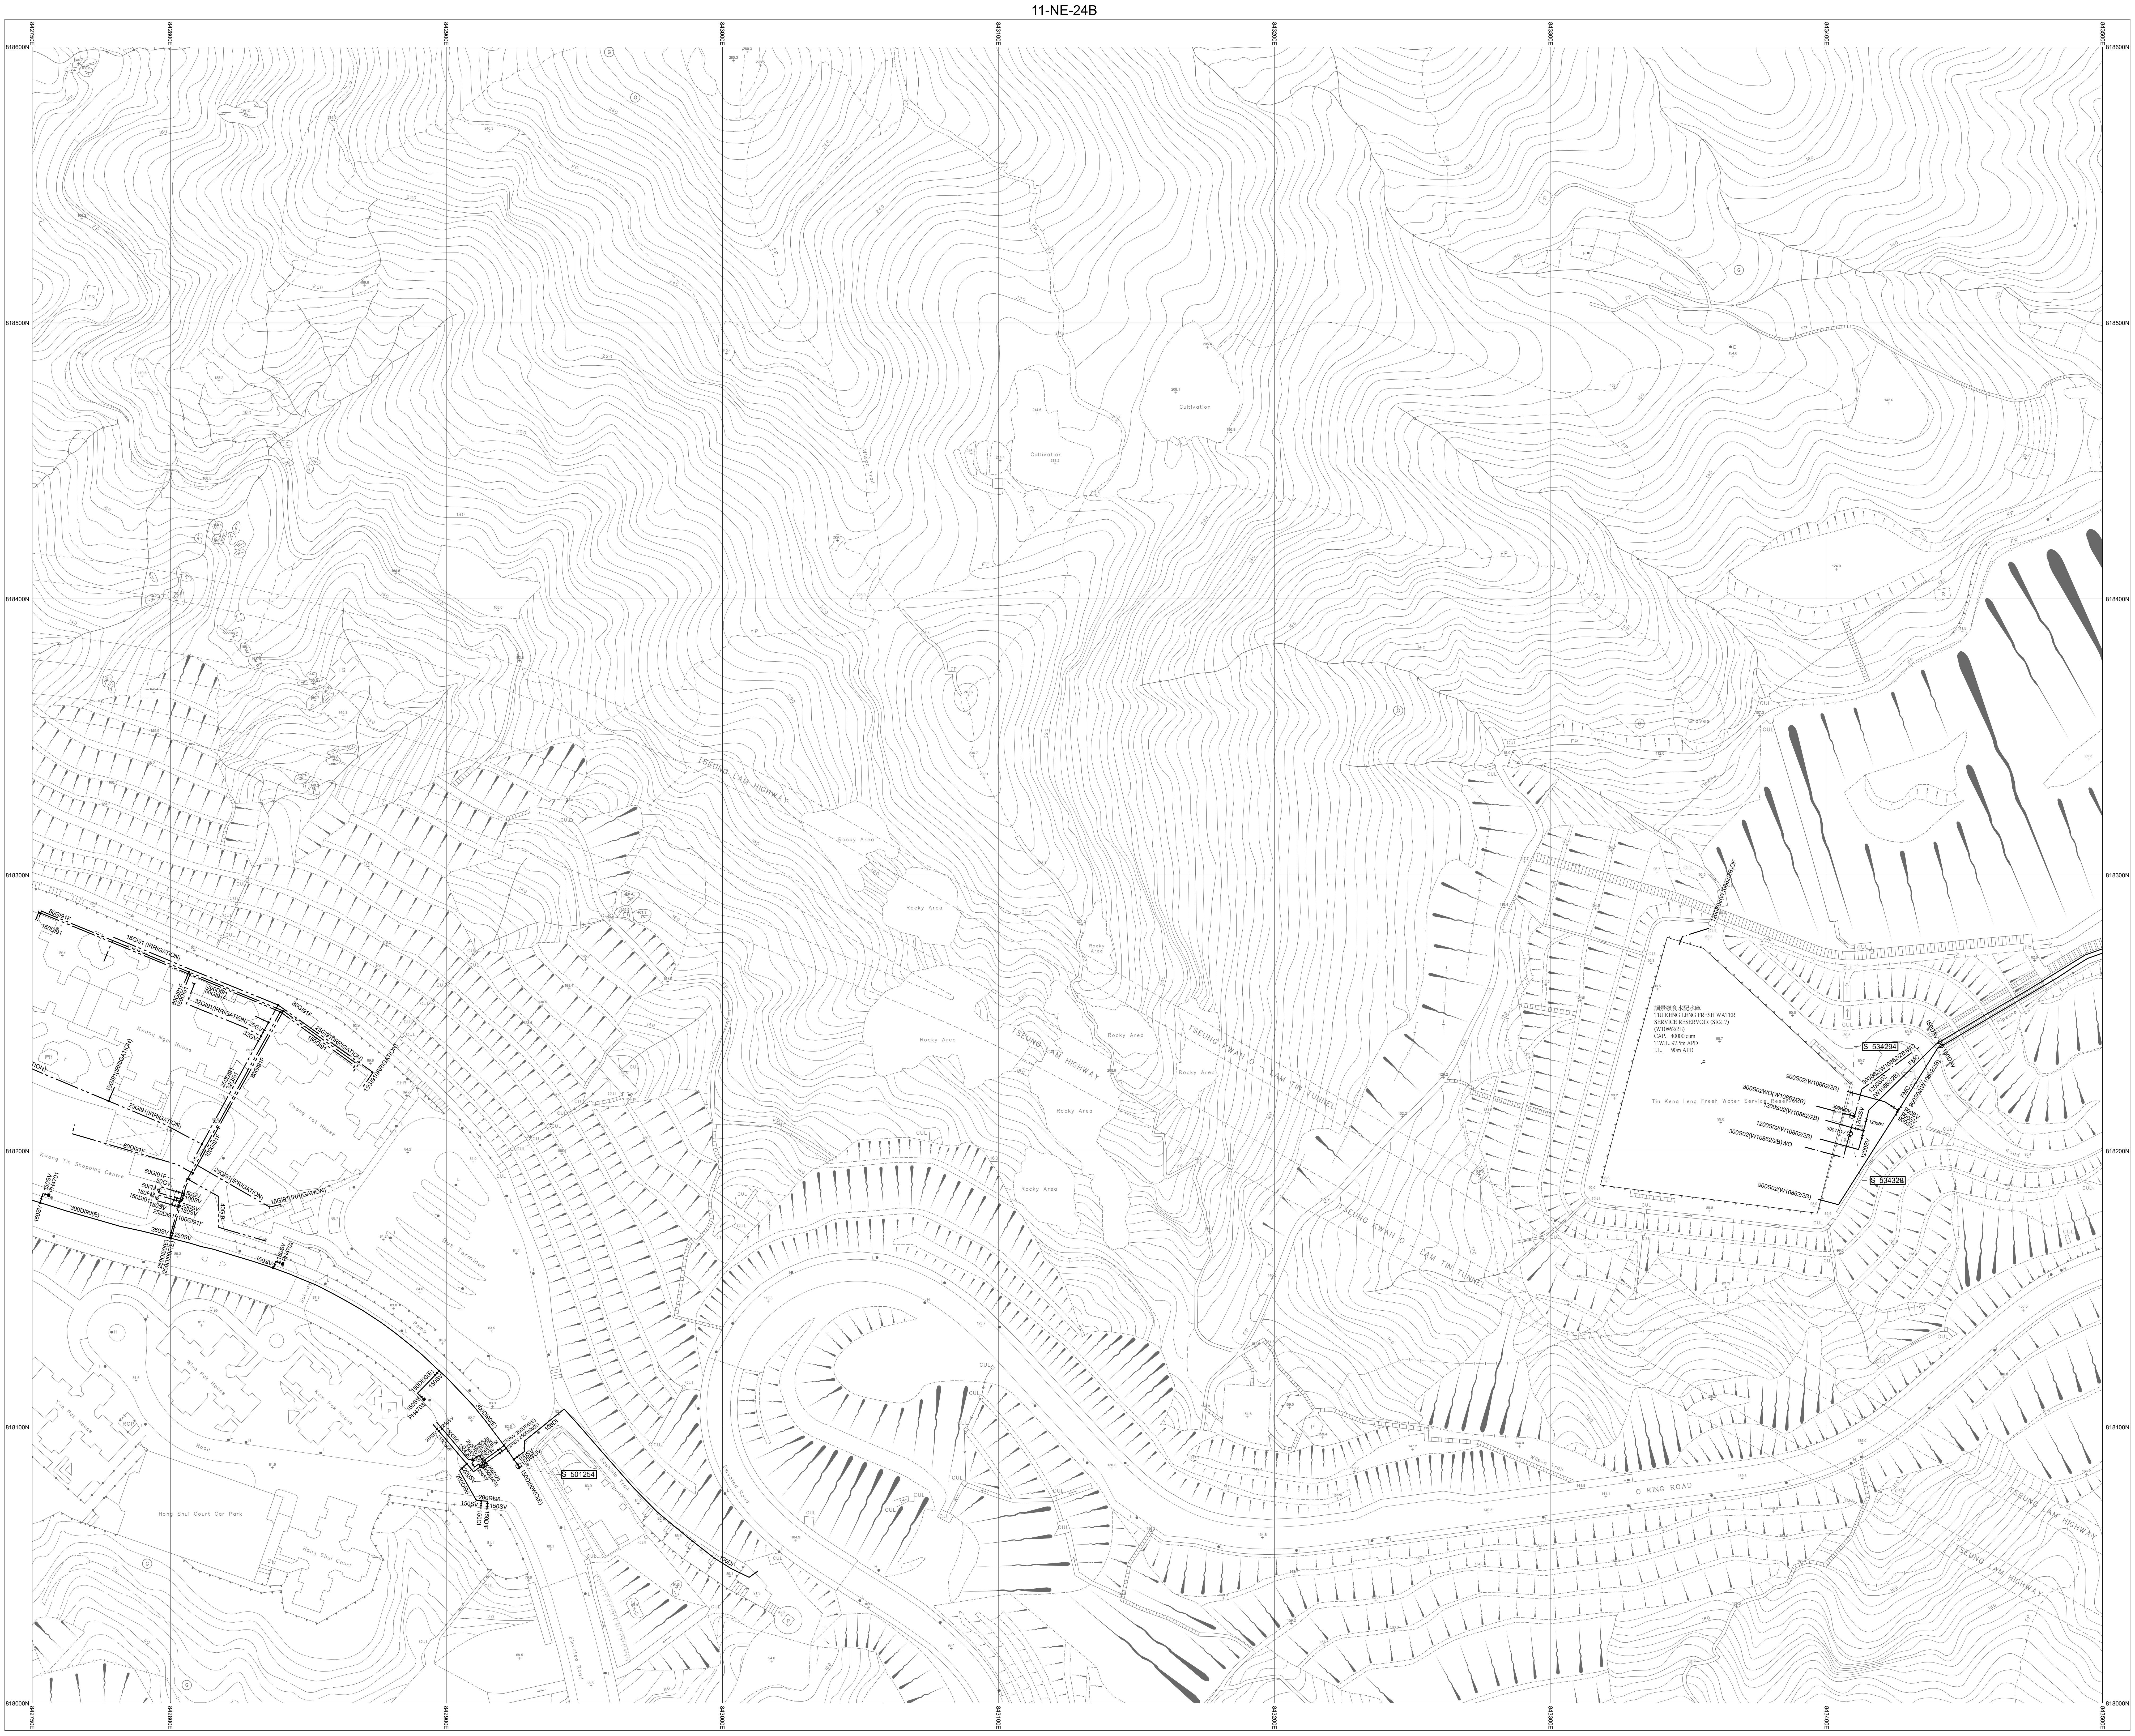
11-NE-24B
11-NE-24C
11-NE-25C
11-SE-4B
818600N
818500N
818400N
818300N
818200N
818100N
818000N
842750E
842800E
842900E
843000E
843100E
843200E
843300E
843400E
843500E
TSEUNG LAM HIGHWAY
TSEUNG KWAN O - LAM TIN TUNNEL
O KING ROAD
Rocky Area
Cultivation
Bus Terminus
Ramp
Bauhinia Trail
Elevated Road
Kwong Ming Court
Hong Shui Court
Hong Shui Court Car Park
Kwong Tin Shopping Centre
調景嶺食水配水庫
TIU KENG LENG FRESH WATER
SERVICE RESERVOIR (SR217)
(W10862/2B)
CAP. 40000 cum
T.W.L. 97.5m APD
I.L. 90m APD
Tiu Keng Leng Fresh Water Service Reservoir
S 534294
S 534328
S 501254
900S02(W10862/2B)
300S02WO(W10862/2B)
1200S02(W10862/2B)
300S02(W10862/2B)WO
300WOV
1200SV
1200BV
900BV
900SV
FMC
150DAV
PH4703
300DI90(E)
150DI90WO(E)
100DI
200DI96
200DI98
150SV
150DI
150DIF
CUL

NOTES:
1. FOR MAINS RECORDS SIGN CONVENTIONS AND DESIGNATIONS SEE SKETCH NO.3988.
2. DIMENSIONS OF MAINS ARE IN MILLIMETRES UNLESS OTHERWISE SPECIFIED.
3. ALL LEVELS ARE IN METRES ABOVE PRINCIPAL DATUM.

Basemap Date Updated On: 23/12/2024

SCALE 1:1 000

METRES 20 10 0 20 40 60 80 100 METRES

THIS IS A COMPUTER PRINTOUT,
NO SIGNATURE IS REQUIRED.

FRESH WATER MAINS RECORD PLAN

RENNIE'S MILL F.W. S/R. TIU KENG LENG

COPYRIGHT RESERVED

DATE REVISED : 31/12/2024

SIGNED
C.H. NG
CE/MSE
DATE: 10/06/1999

DRAWING NO.
W67880/ 11-NE-24D

Water Supplies Department
HONG KONG

© The Government of the Hong Kong SAR, Map reproduced with permission of the Director of Lands