INSET 'A'	INSET 'B'	INSET 'C'	INSET 'D'	INSET 'E'	INSET 'F'

11-NE-25D

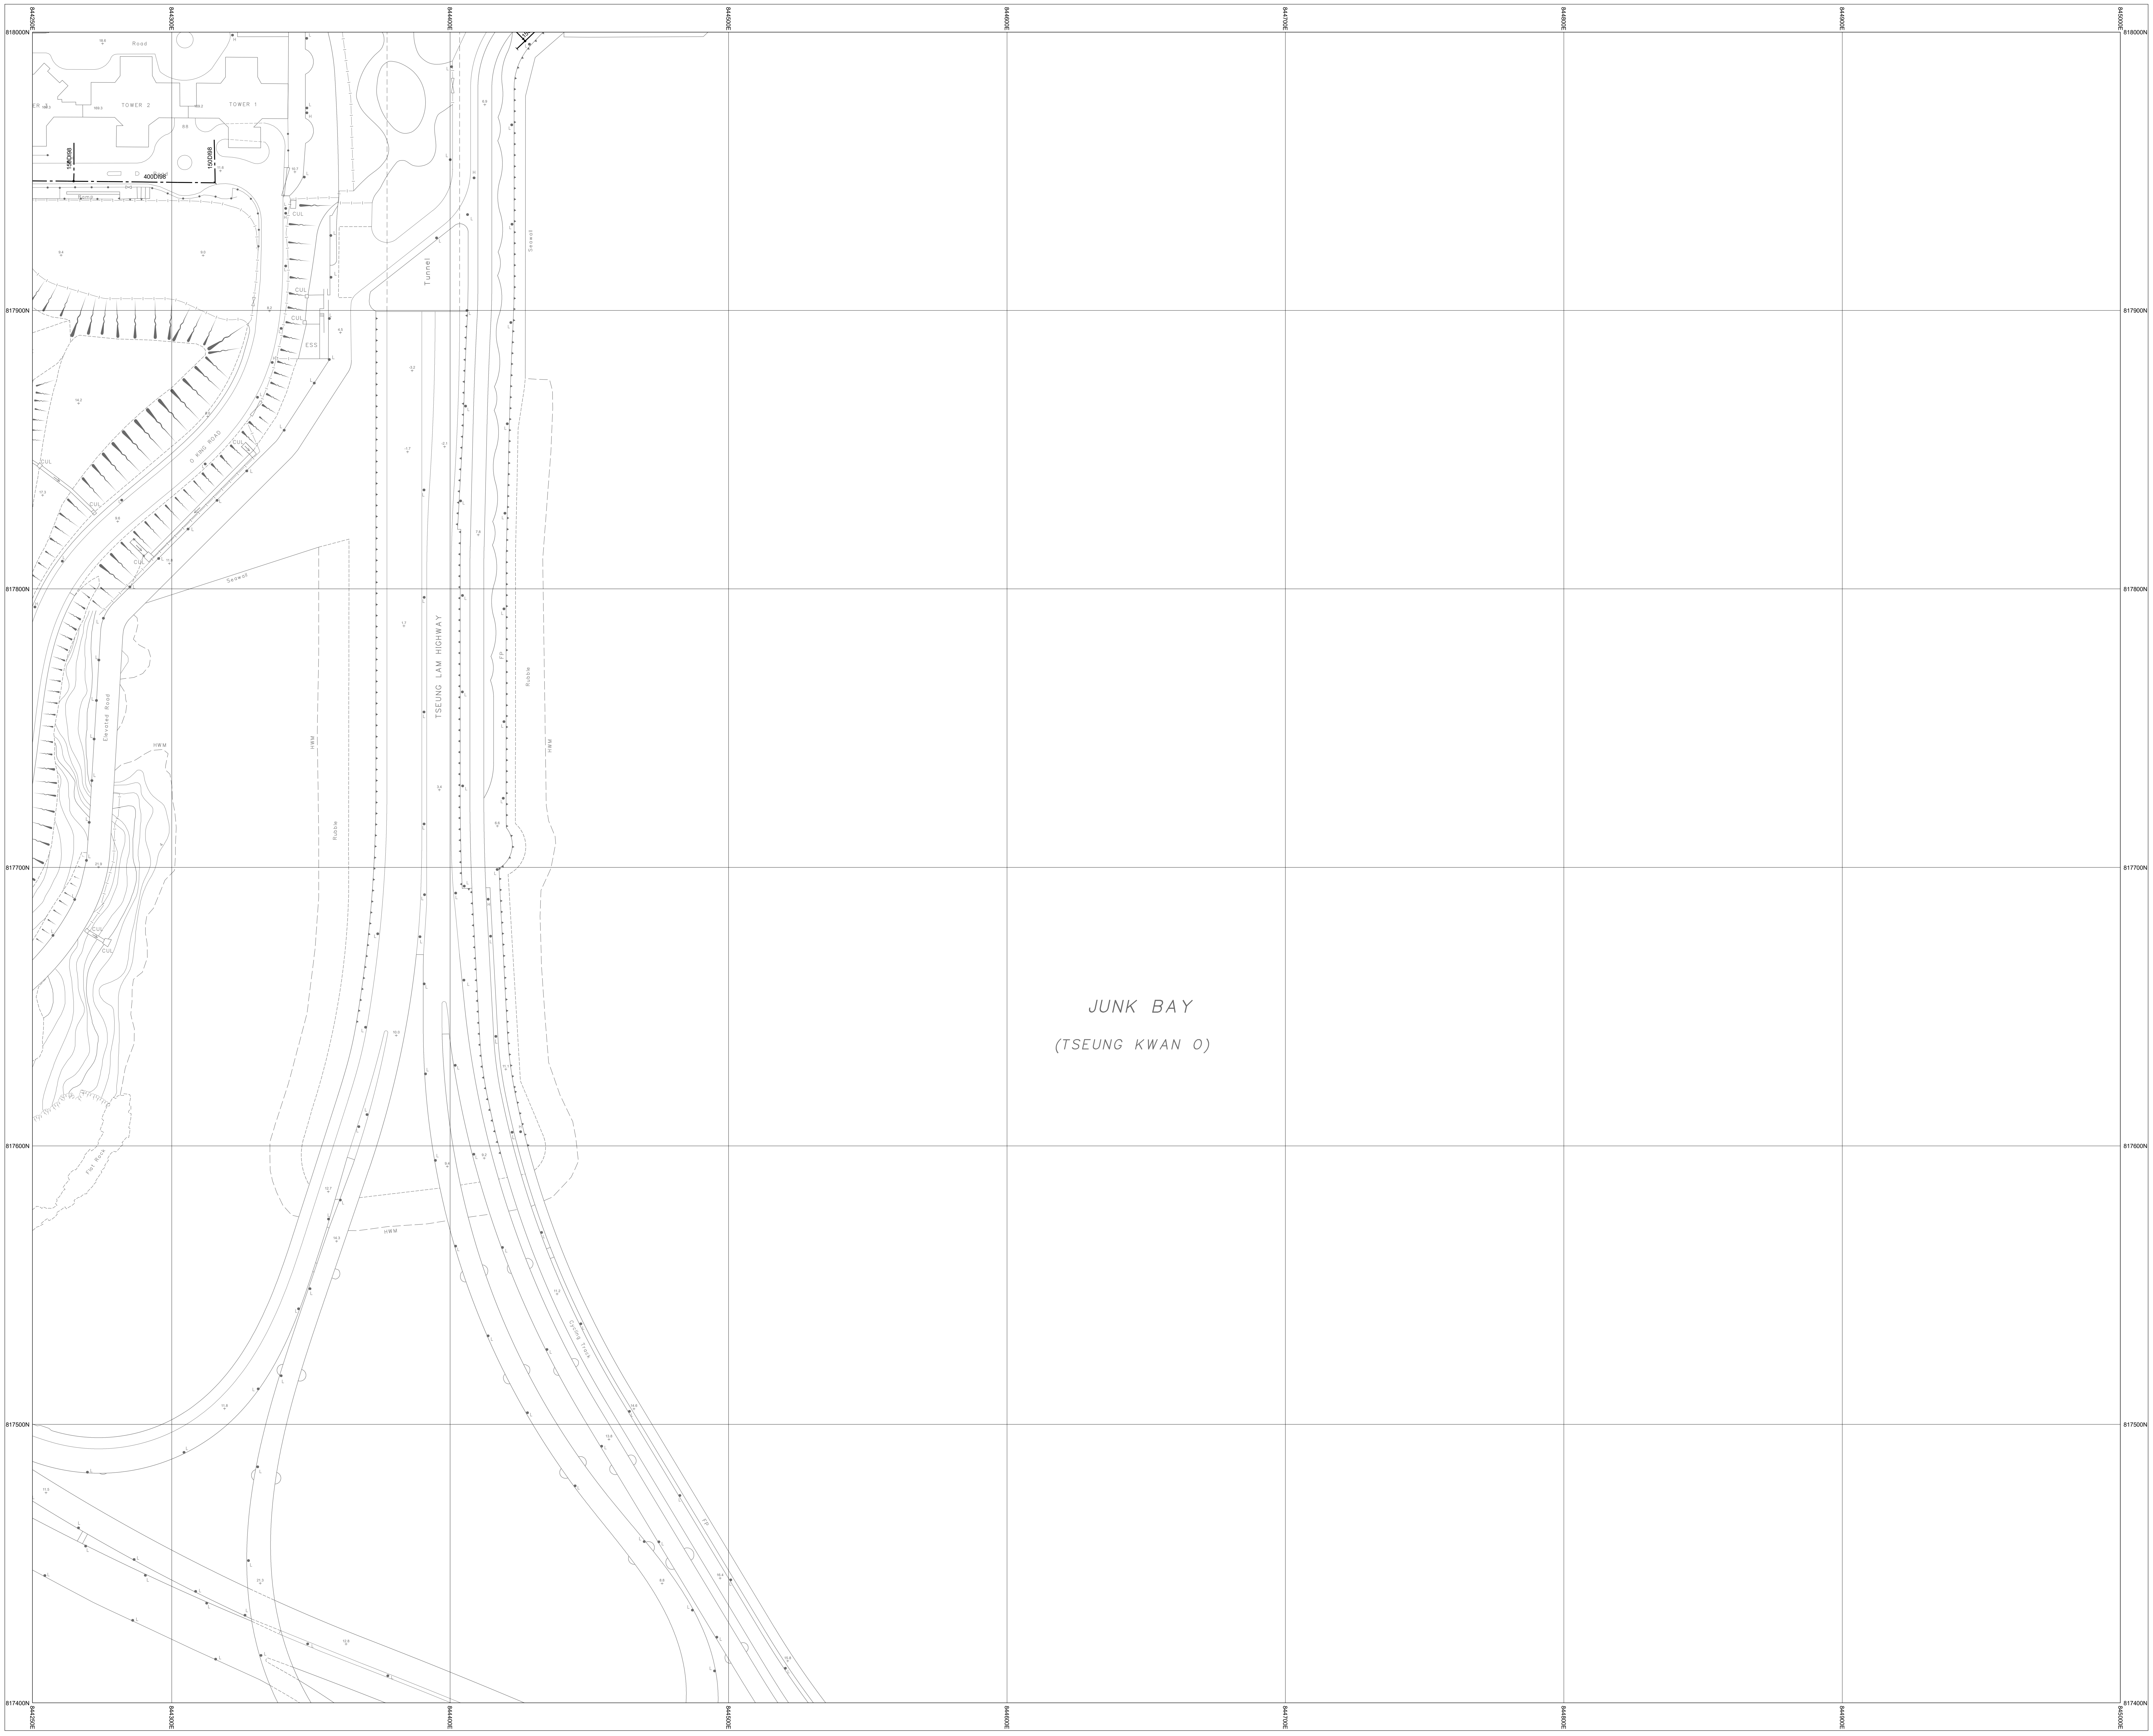
844250E
844300E
844400E
844500E
844600E
844700E
844800E
844900E
845000E
818000N
817900N
817800N
817700N
817600N
817500N
817400N
Road
TOWER 2
TOWER 1
88
150DI98
150DI98
400DI98
Ramp
CUL
ESS
O KING ROAD
Tunnel
Seawall
Seawall
TSEUNG LAM HIGHWAY
FP
Rubble
Rubble
HWM
HWM
HWM
JUNK BAY
(TSEUNG KWAN O)

11-SE-5A

12-SW-1A

11-SE-5D

NOTES:

1. FOR MAINS RECORDS SIGN CONVENTIONS AND DESIGNATIONS SEE SKETCH NO.3988.
2. DIMENSIONS OF MAINS ARE IN MILLIMETRES UNLESS OTHERWISE SPECIFIED.
3. ALL LEVELS ARE IN METRES ABOVE PRINCIPAL DATUM.

Basemap Date Updated On: 23/12/2024

SCALE 1:1 000

METRES 20 10 0 20 40 60 80 100 METRES

THIS IS A COMPUTER PRINTOUT,
NO SIGNATURE IS REQUIRED.

FRESH WATER MAINS RECORD PLAN

OCEAN SHORES, O KING ROAD

COPYRIGHT RESERVED

DATE REVISED : 31/12/2024

DRAWING NO.

W67880/ 11-SE-5B

SIGNED H.Y. YAU
CE/NTE

DATE: 20/04/2021

Water Supplies Department
HONG KONG

© The Government of the Hong Kong SAR, Map reproduced with permission of the Director of Lands