INSET 'A'

INSET 'B'

INSET 'C'

INSET 'D'

INSET 'E'

INSET 'F'

8-SE-22D

12-NE-2A

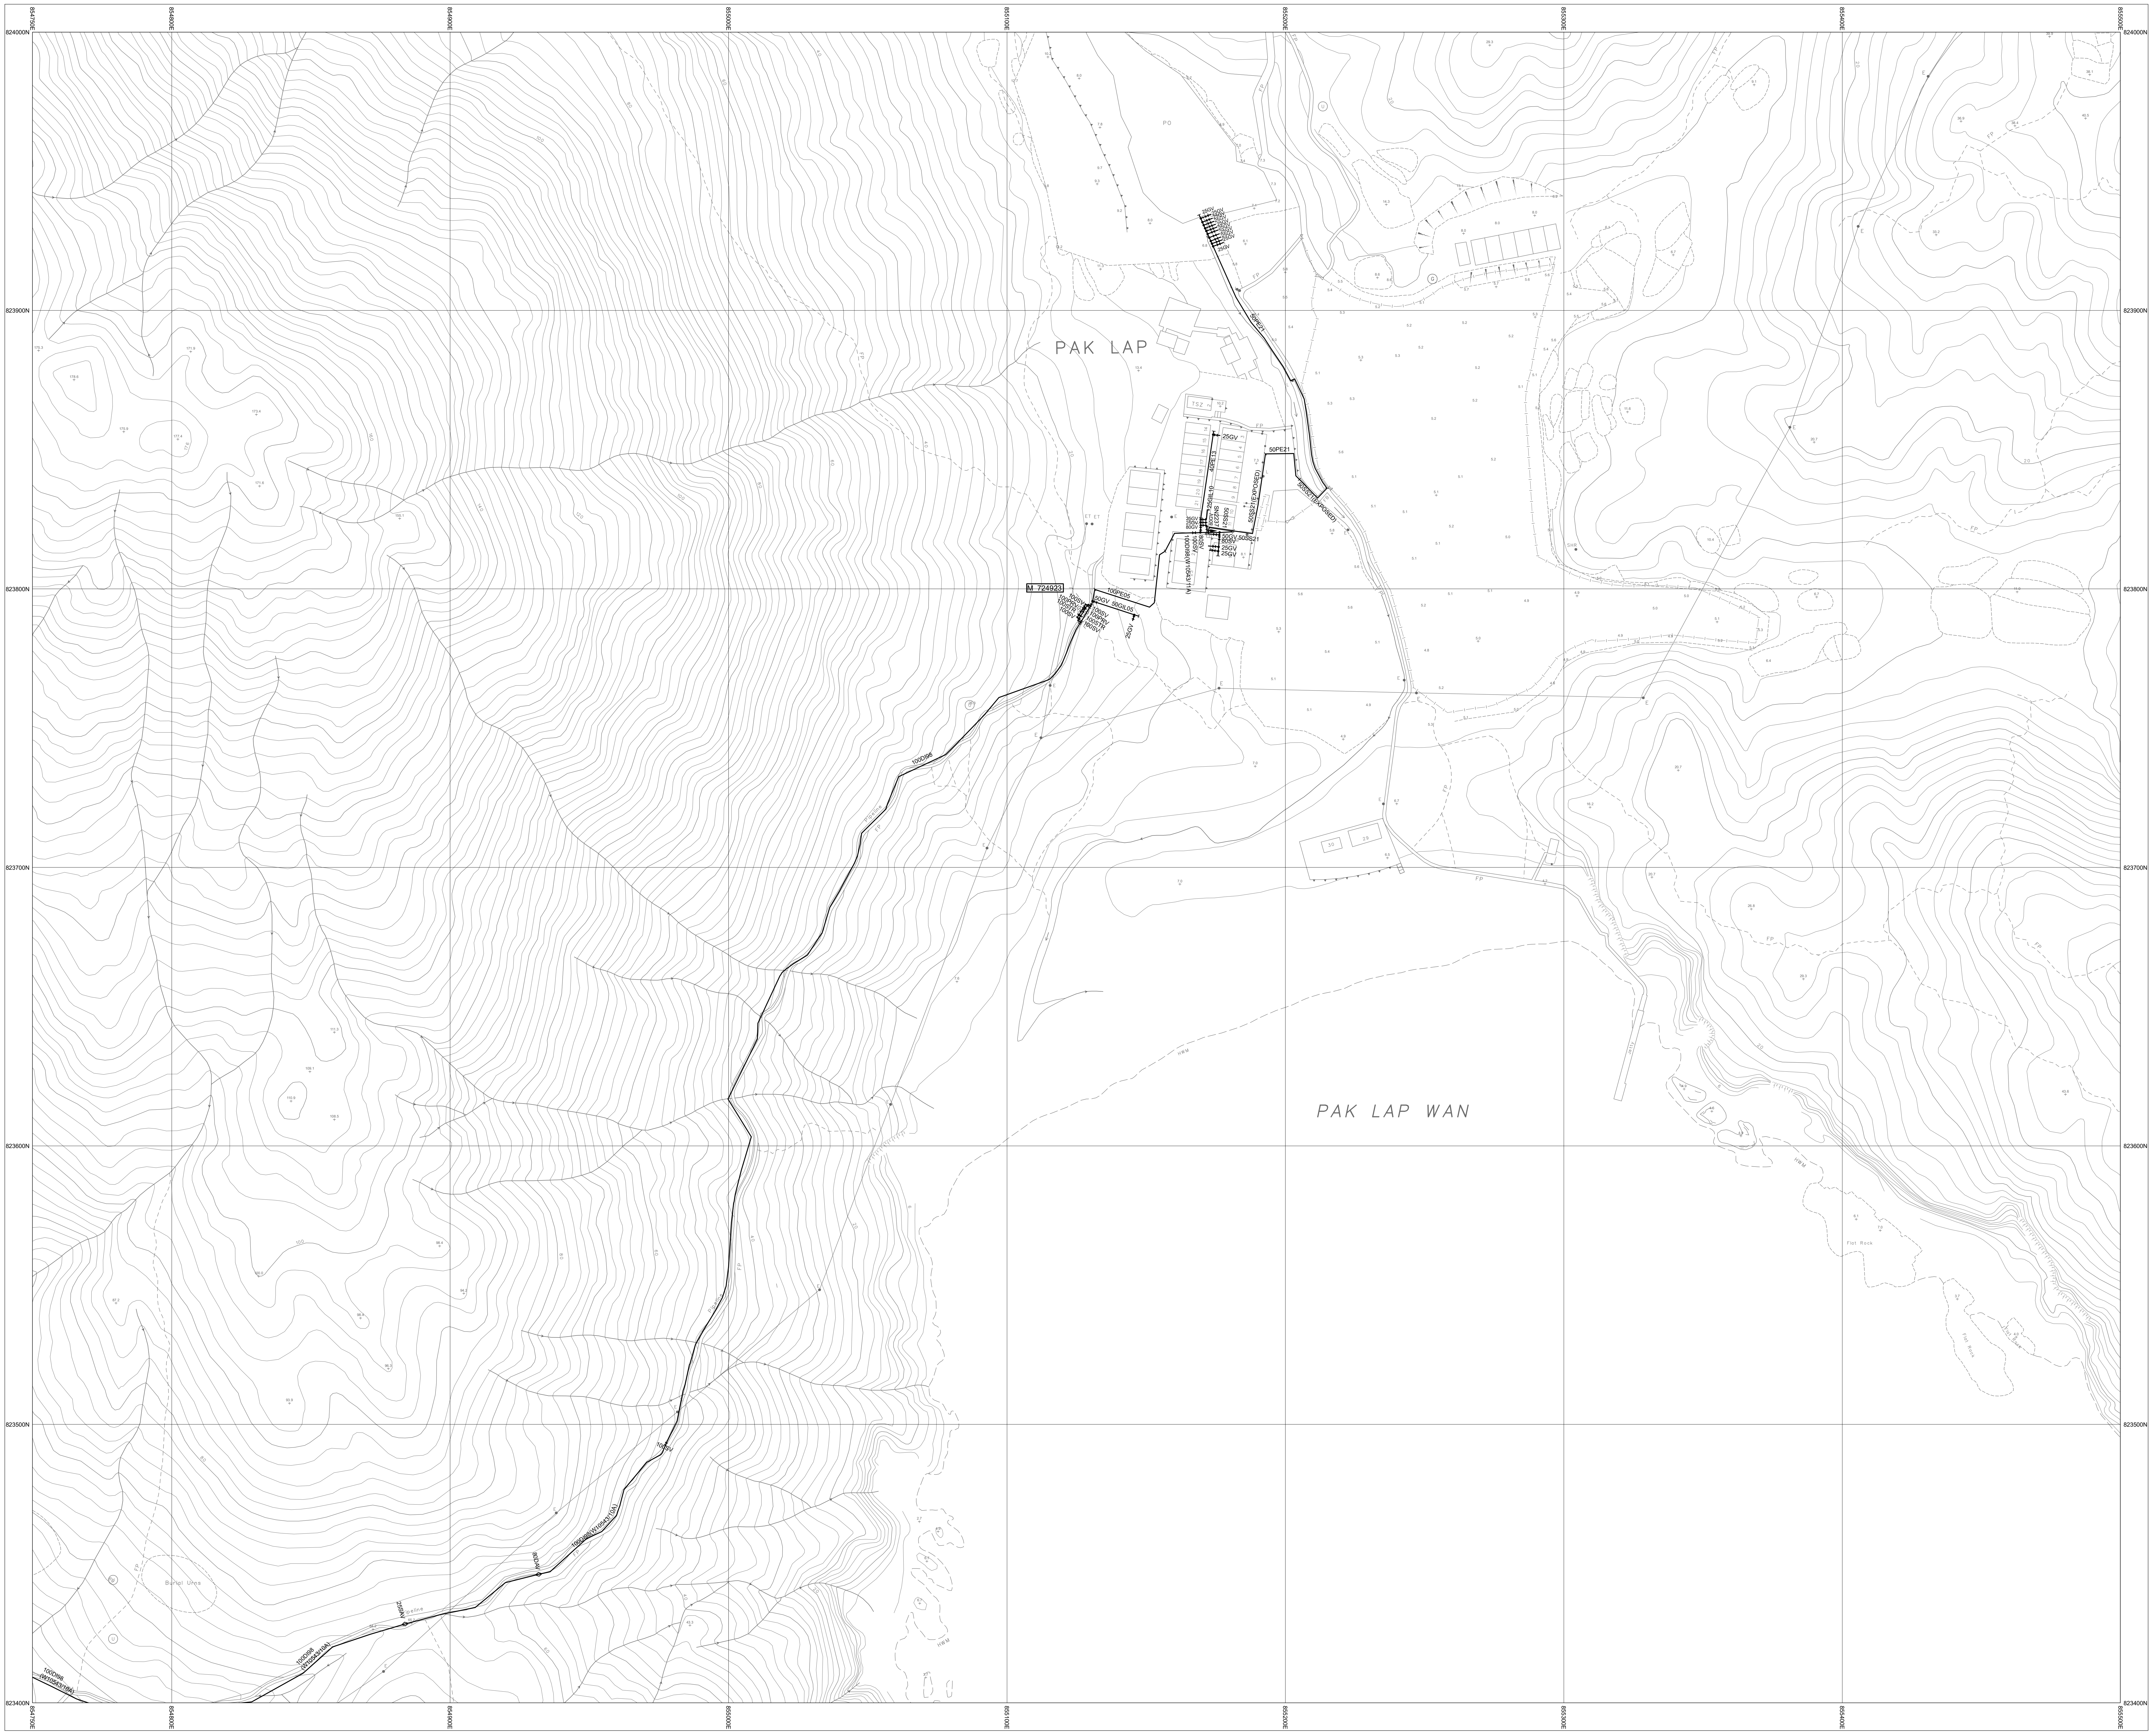

854750E
854800E
854900E
855000E
855100E
855200E
855300E
855400E
855500E
824000N
823900N
823800N
823700N
823600N
823500N
823400N
PAK LAP
PAK LAP WAN
PO
TSZ
FP
M 724923
100PE05
50GV
50GIL05
25GV
100SV
100PRV
100STR
100DI98(W10543/11A)
80SV
80GV
40PE13
25GIL10
SN2237
50SS21
50SS21(EXPOSED)
50PE21
100DI98(W10543/10A)
100SV
80DAV
25SAV
Pipeline
Burial Urns

12-NE-3A

12-NE-2D

NOTES:

1. FOR MAINS RECORDS SIGN CONVENTIONS AND DESIGNATIONS SEE SKETCH NO.3988.
2. DIMENSIONS OF MAINS ARE IN MILLIMETRES UNLESS OTHERWISE SPECIFIED.
3. ALL LEVELS ARE IN METRES ABOVE PRINCIPAL DATUM.

Basemap Date Updated On: 23/12/2024

SCALE 1:1 000

METRES 20 10 0 20 40 60 80 100 METRES

THIS IS A COMPUTER PRINTOUT,
NO SIGNATURE IS REQUIRED.

FRESH WATER MAINS RECORD PLAN

LEUNG SHUEN WAN CHAU, HIGH ISLAND

COPYRIGHT RESERVED

DATE REVISED : 31/12/2024

DRAWING NO.

W67880/ 12-NE-2B

SIGNED

C.H. NG
CE/MSE

DATE: 10/06/1999

Water Supplies Department
HONG KONG

© The Government of the Hong Kong SAR, Map reproduced with permission of the Director of Lands