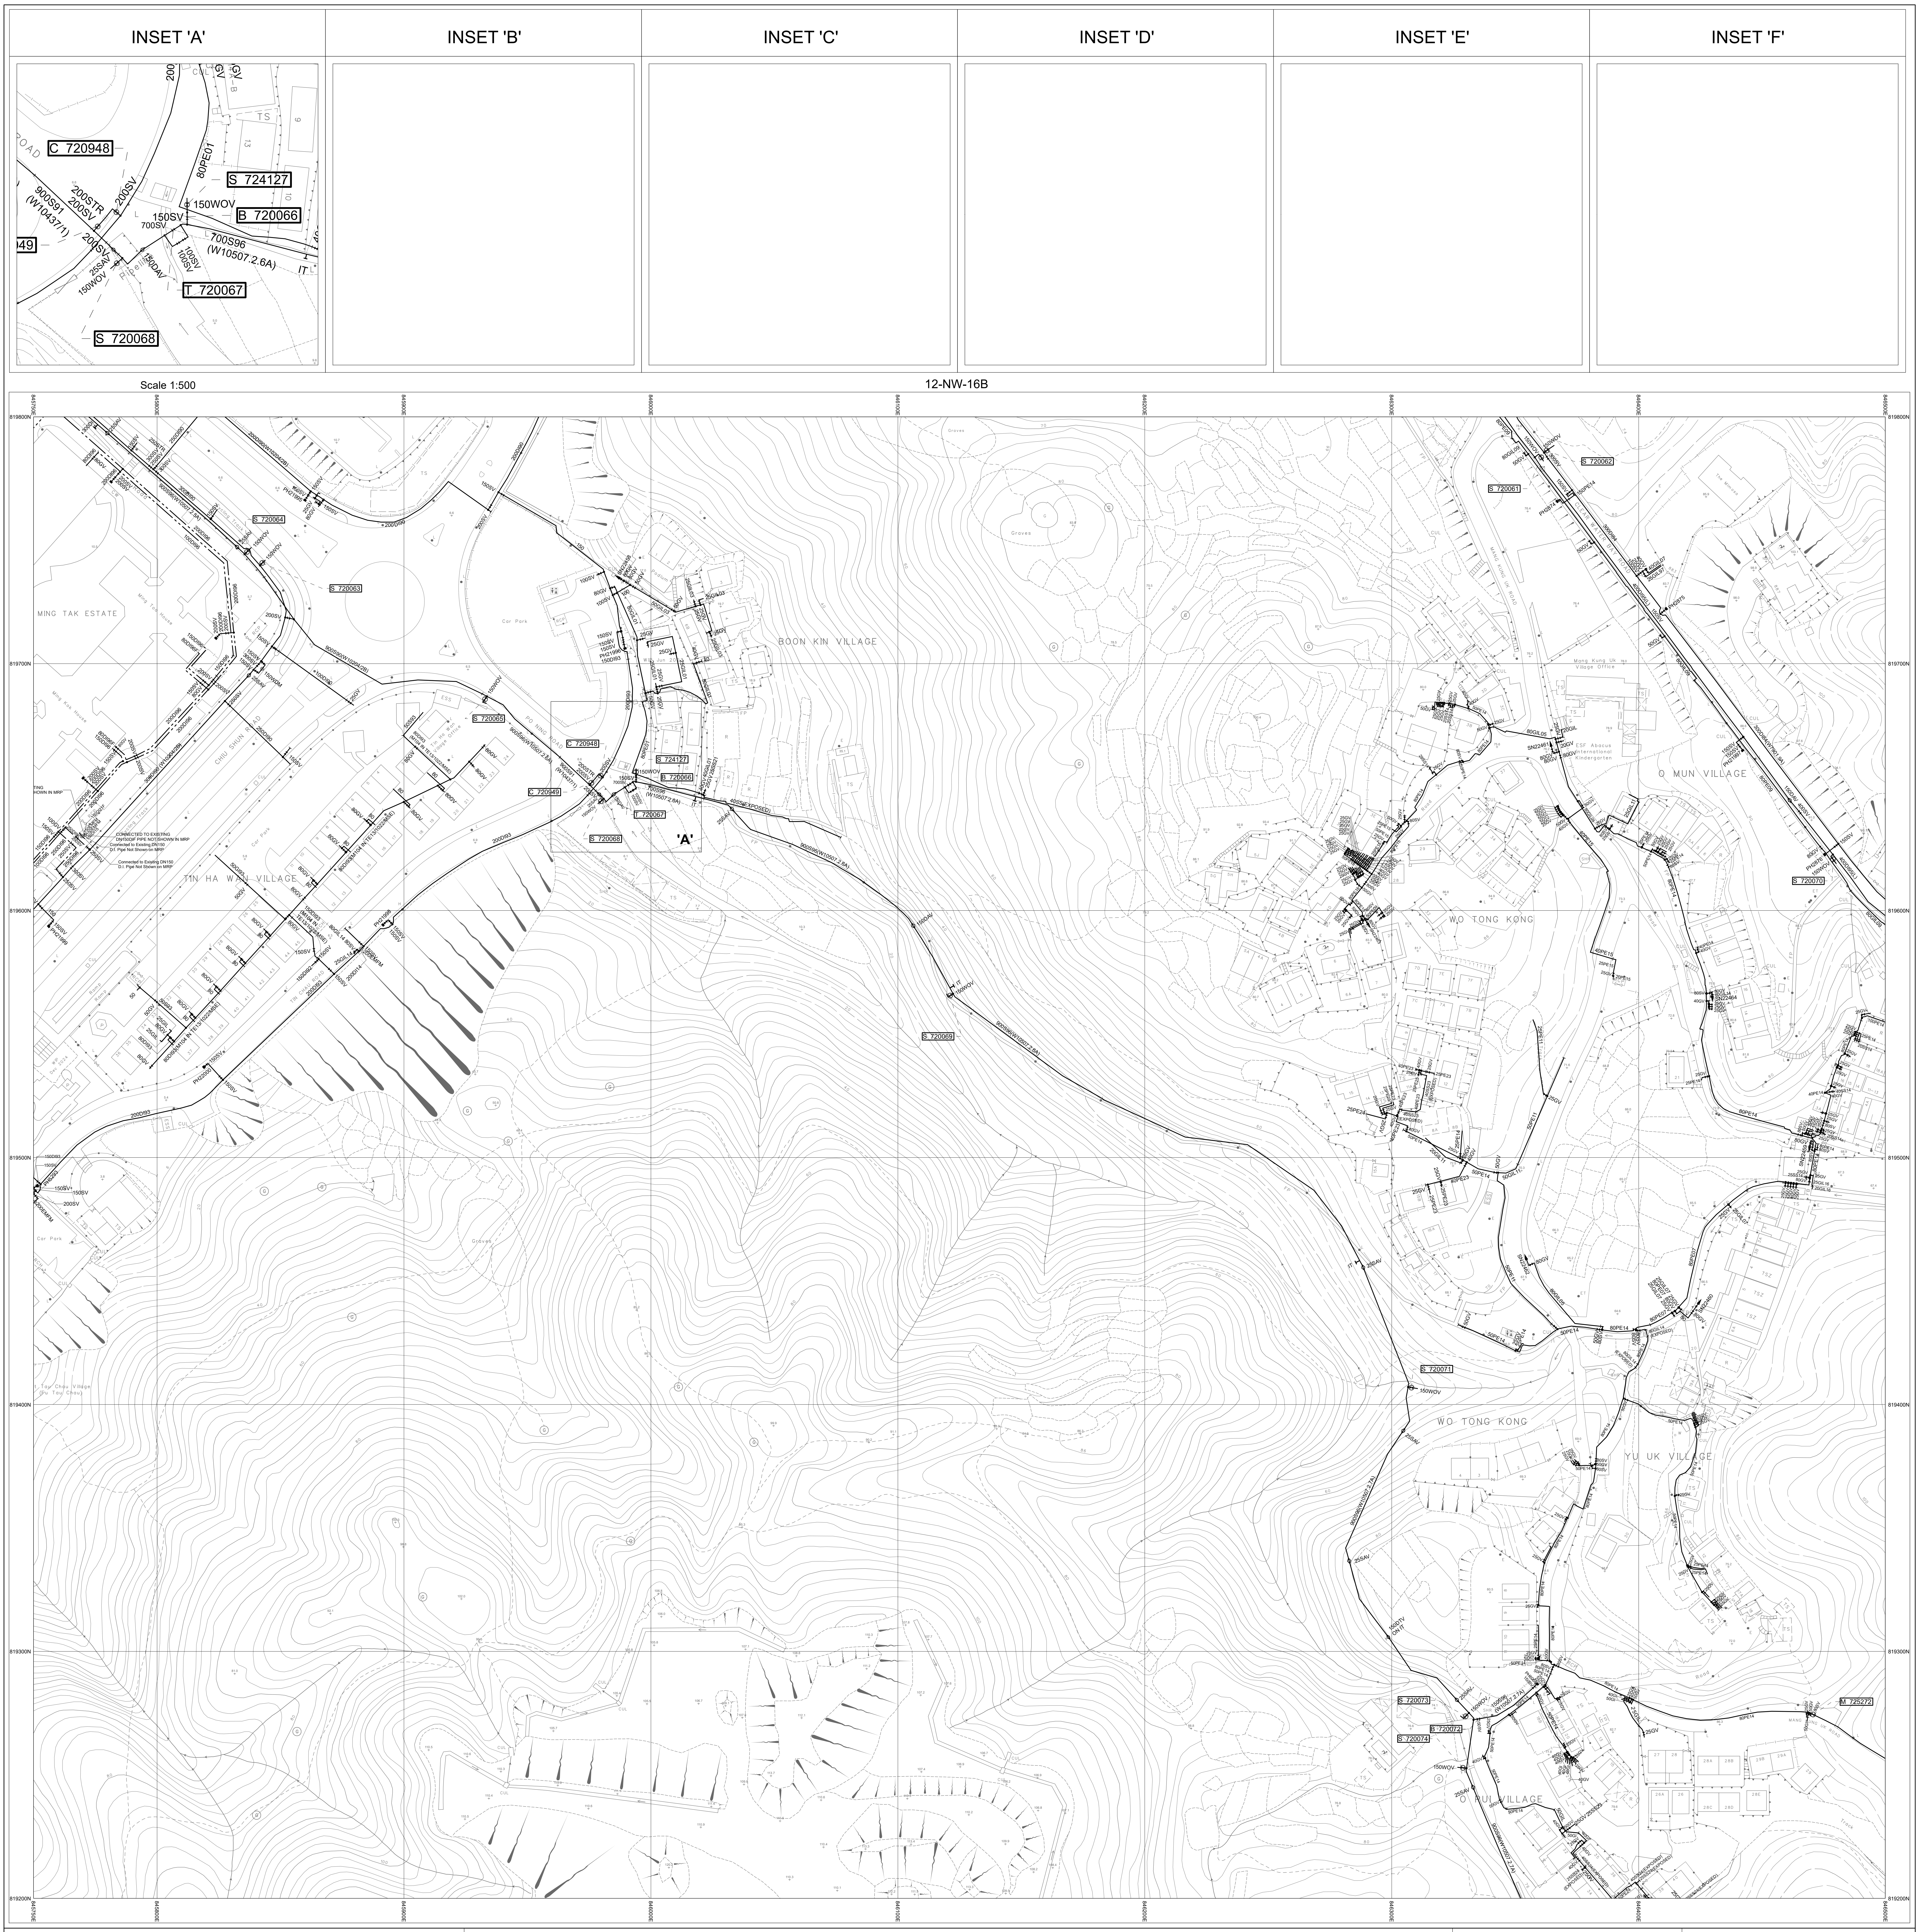
INSET 'A'
INSET 'B'
INSET 'C'
INSET 'D'
INSET 'E'
INSET 'F'
C 720948
S 724127
B 720066
T 720067
S 720068
200STR
200SV
900S91
(W10437/1)
150SV
150WOV
700SV
700S96
(W10507.2.6A)
80PE01
25SAV
150WOV
150DAV
100SV
Scale 1:500
12-NW-16B
12-NW-16C
12-NW-17C
12-NW-21B
MING TAK ESTATE
BOON KIN VILLAGE
TIN HA WAN VILLAGE
Tin Ha Wan Village Office
PO NING ROAD
Car Park
O MUN VILLAGE
WO TONG KONG
YU UK VILLAGE
O PUI VILLAGE
MANG KUNG UK ROAD
S 720064
S 720063
S 720065
C 720949
S 720069
S 720062
S 720061
S 720070
S 720071
S 720073
B 720072
S 720074
M 725272
'A'
819600N
819500N
819400N
819300N
819200N

NOTES:

1. FOR MAINS RECORDS SIGN CONVENTIONS AND DESIGNATIONS SEE SKETCH NO.3988.
2. DIMENSIONS OF MAINS ARE IN MILLIMETRES UNLESS OTHERWISE SPECIFIED.
3. ALL LEVELS ARE IN METRES ABOVE PRINCIPAL DATUM.

Basemap Date Updated On: 05/01/2026

SCALE 1:1 000

METRES 20 10 0 20 40 60 80 100 METRES

THIS IS A COMPUTER PRINTOUT,
NO SIGNATURE IS REQUIRED.

FRESH WATER MAINS RECORD PLAN

WO TONG KONG,TSEUNG KWAN O

COPYRIGHT RESERVED

DATE REVISED : 03/06/2026

DRAWING NO.

W67880/ 12-NW-16D

SIGNED C.H. NG
CE/MSE
DATE: 10/06/1999

Water Supplies Department
HONG KONG

© The Government of the Hong Kong SAR, Map reproduced with permission of the Director of Lands