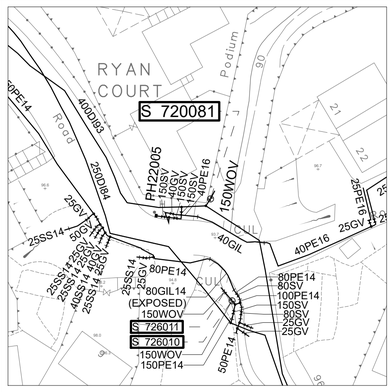
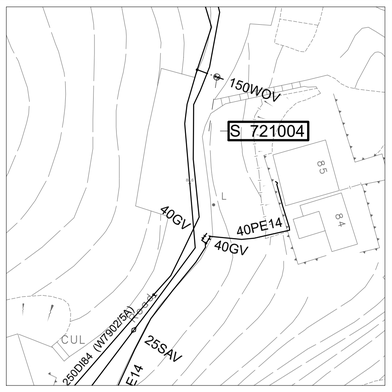
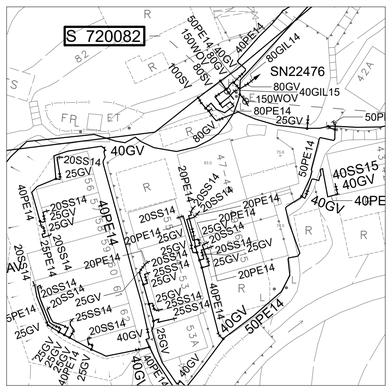
INSET 'A'



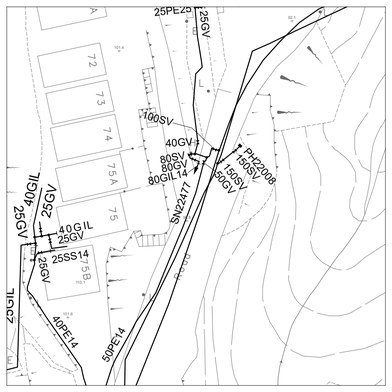

INSET 'B'




INSET 'C'



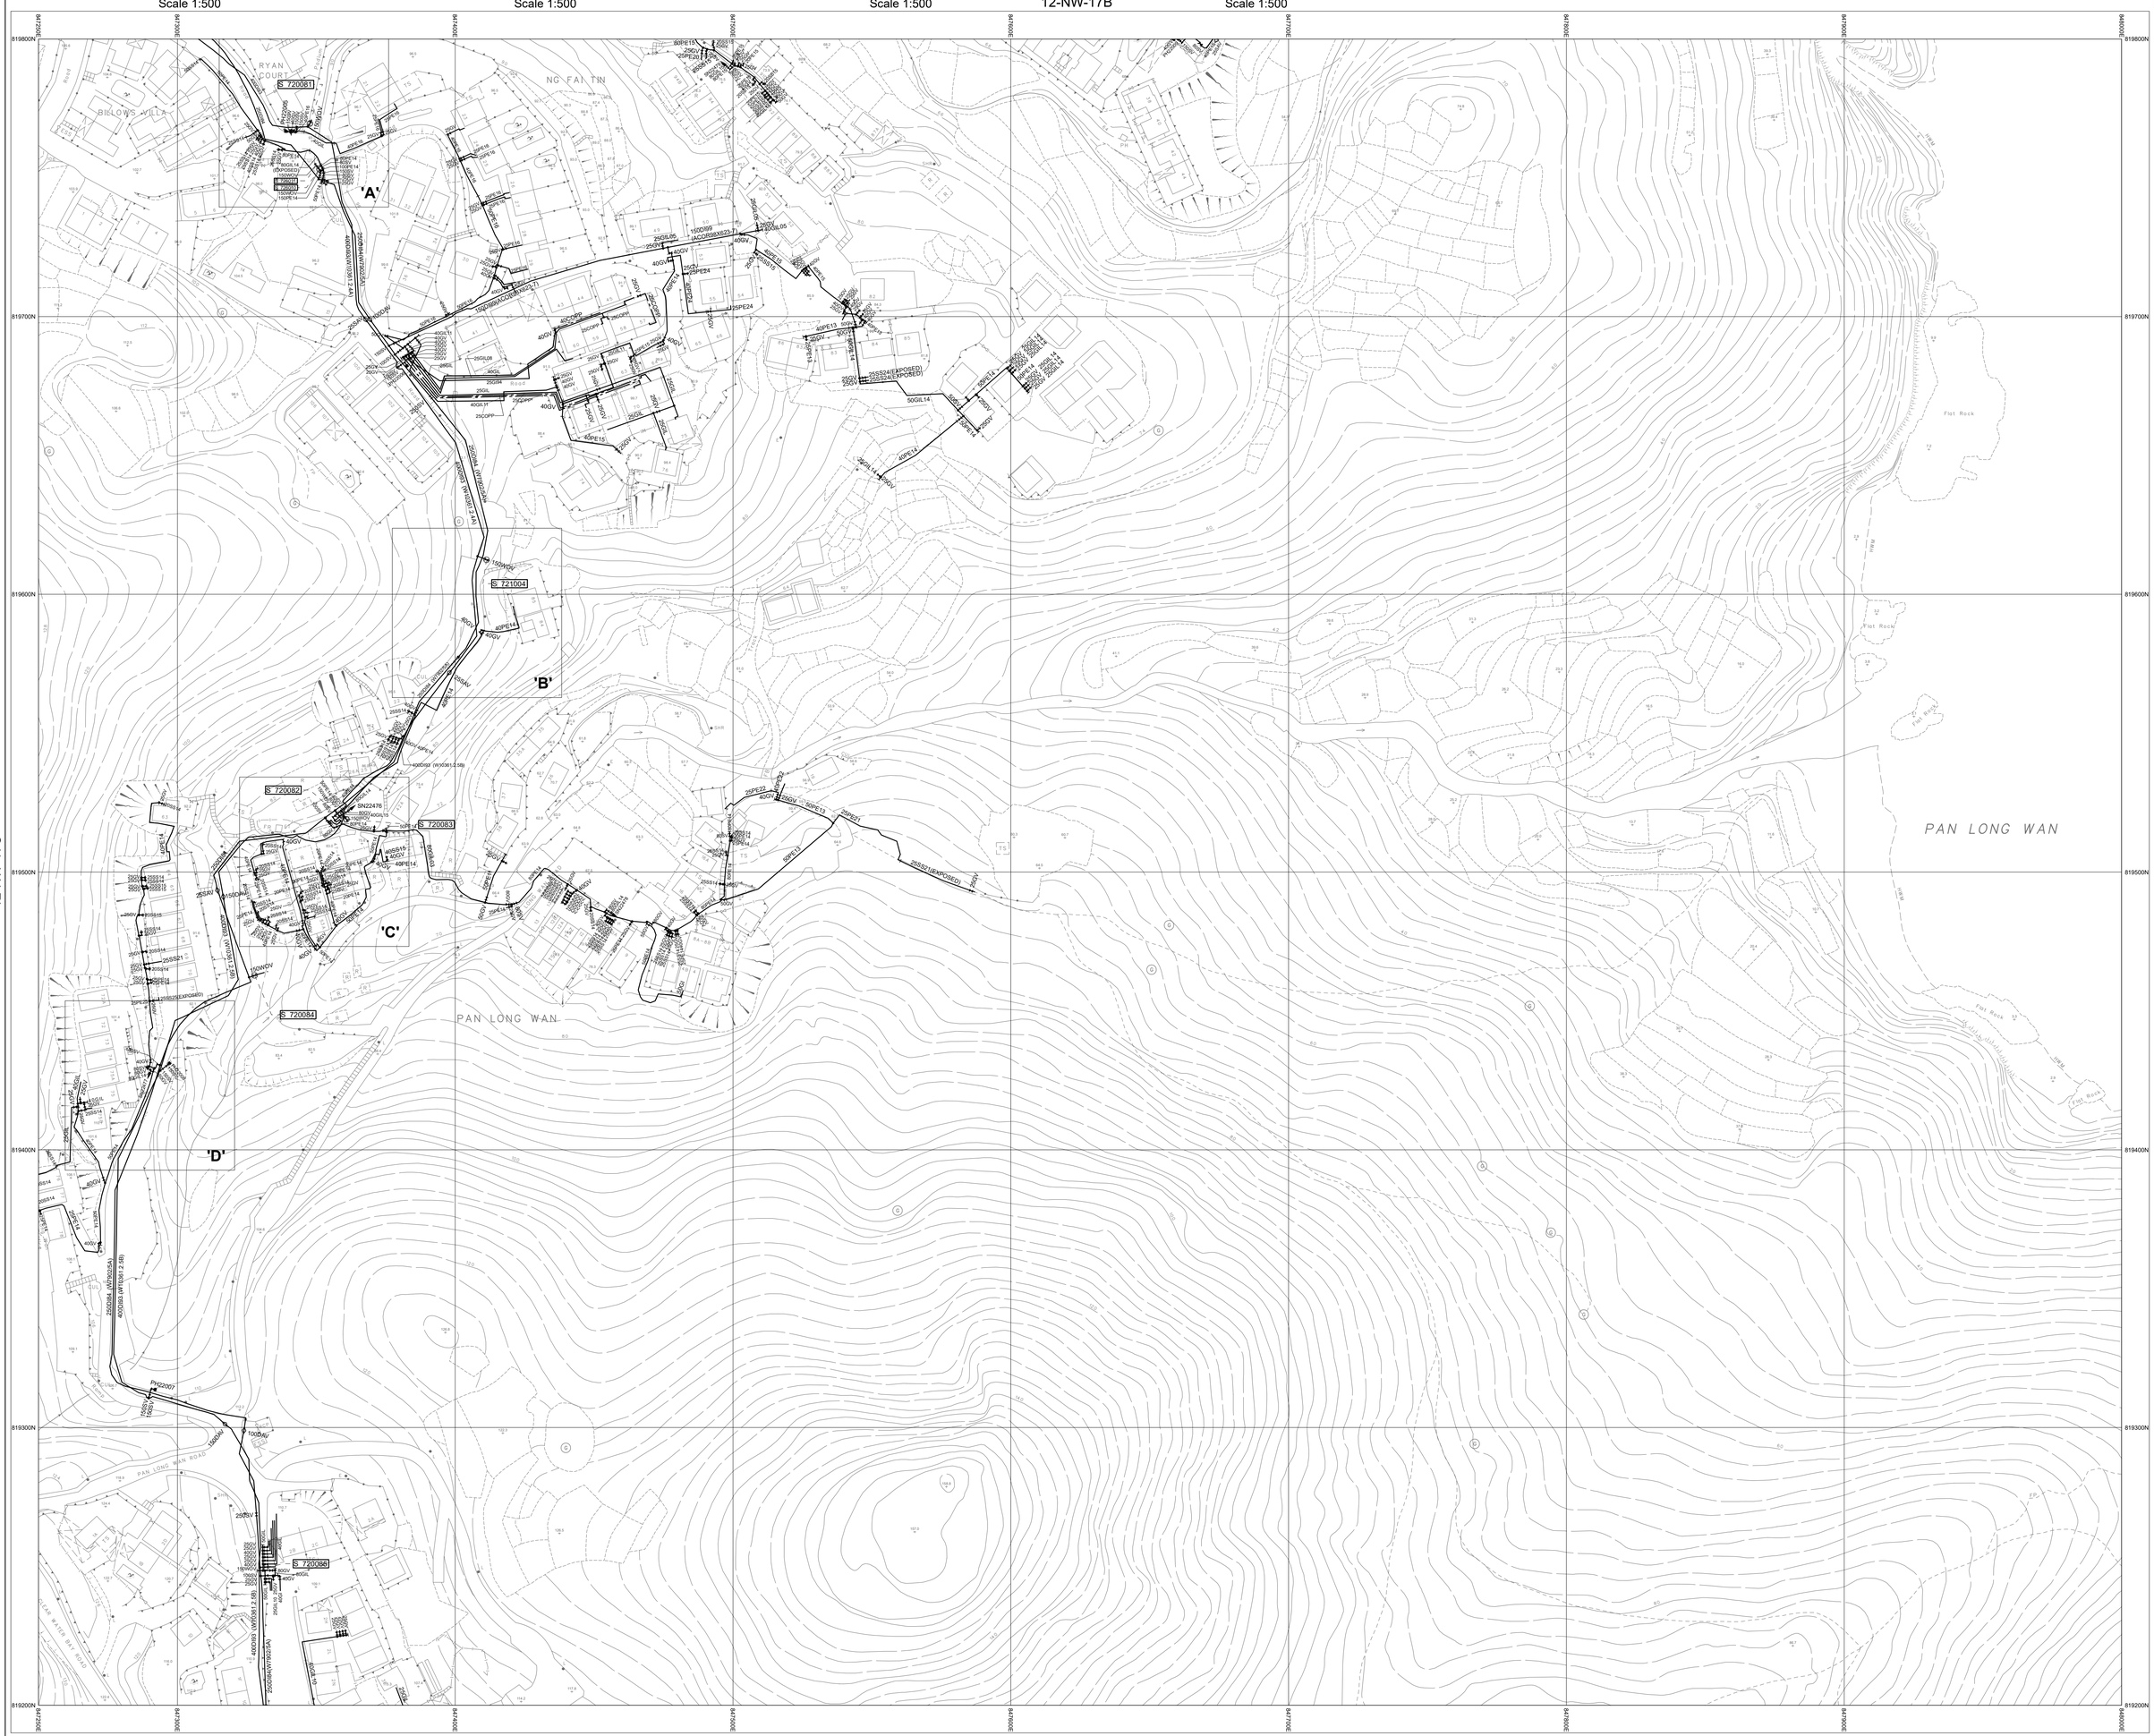

INSET 'D'




INSET 'E'

INSET 'F'

Scale 1:500 Scale 1:500 Scale 1:500 12-NW-17B Scale 1:500




12-NW-17C

12-NW-18C

12-NW-22B

NOTES:

1. FOR MAINS RECORDS SIGN CONVENTIONS AND DESIGNATIONS SEE SKETCH NO.3988.
2. DIMENSIONS OF MAINS ARE IN MILLIMETRES UNLESS OTHERWISE SPECIFIED.
3. ALL LEVELS ARE IN METRES ABOVE PRINCIPAL DATUM.

Basemap Date Updated On: 05/01/2026

SCALE 1:1 000

METRES 20 10 0 20 40 60 80 100 METRES

THIS IS A COMPUTER PRINTOUT, NO SIGNATURE IS REQUIRED.

# FRESH WATER MAINS RECORD PLAN

NG FAI TIN, PAN LONG WAN

COPYRIGHT RESERVED

DATE REVISED : 03/06/2026

DRAWING NO. W67880/ 12-NW-17D

SIGNED C.H. NG
CE/MSE
DATE: 10/06/1999

Water Supplies Department
HONG KONG

© The Government of the Hong Kong SAR, Map reproduced with permission of the Director of Lands