INSET 'A'

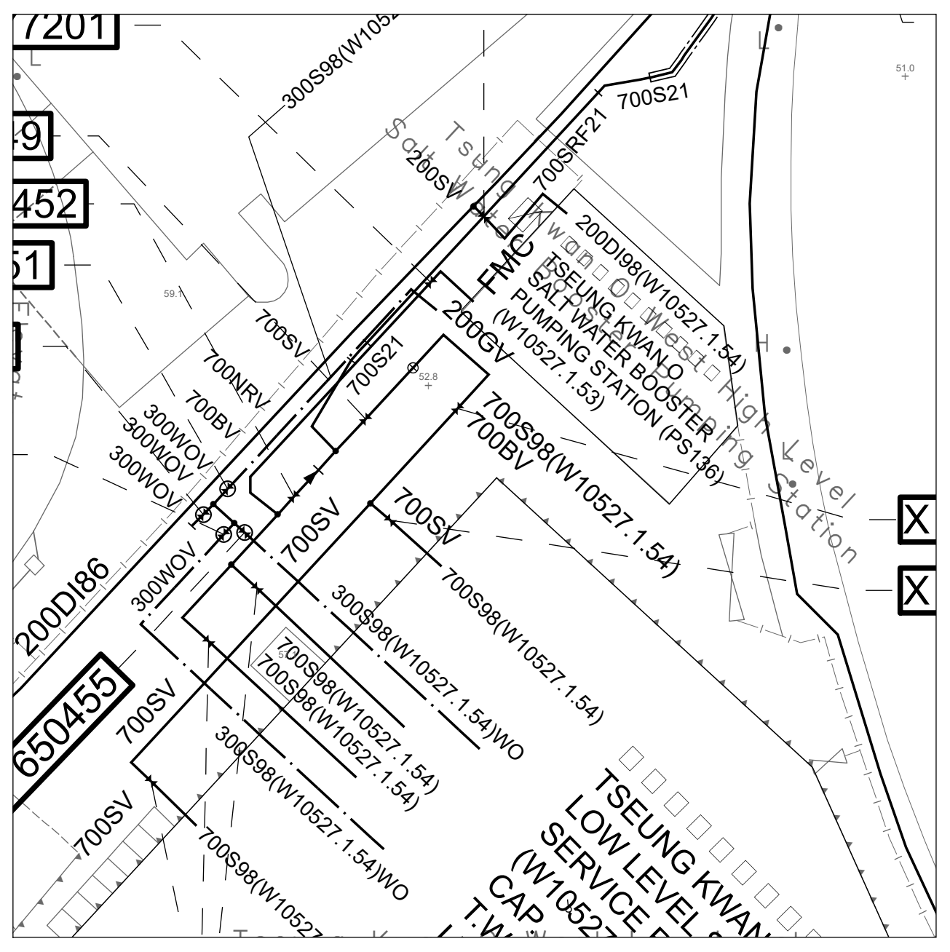
7201
452
650455
700SV
300SV
TSEUNG KWAN
LOW LEVEL
SERVICE

Scale 1:500

INSET 'B'

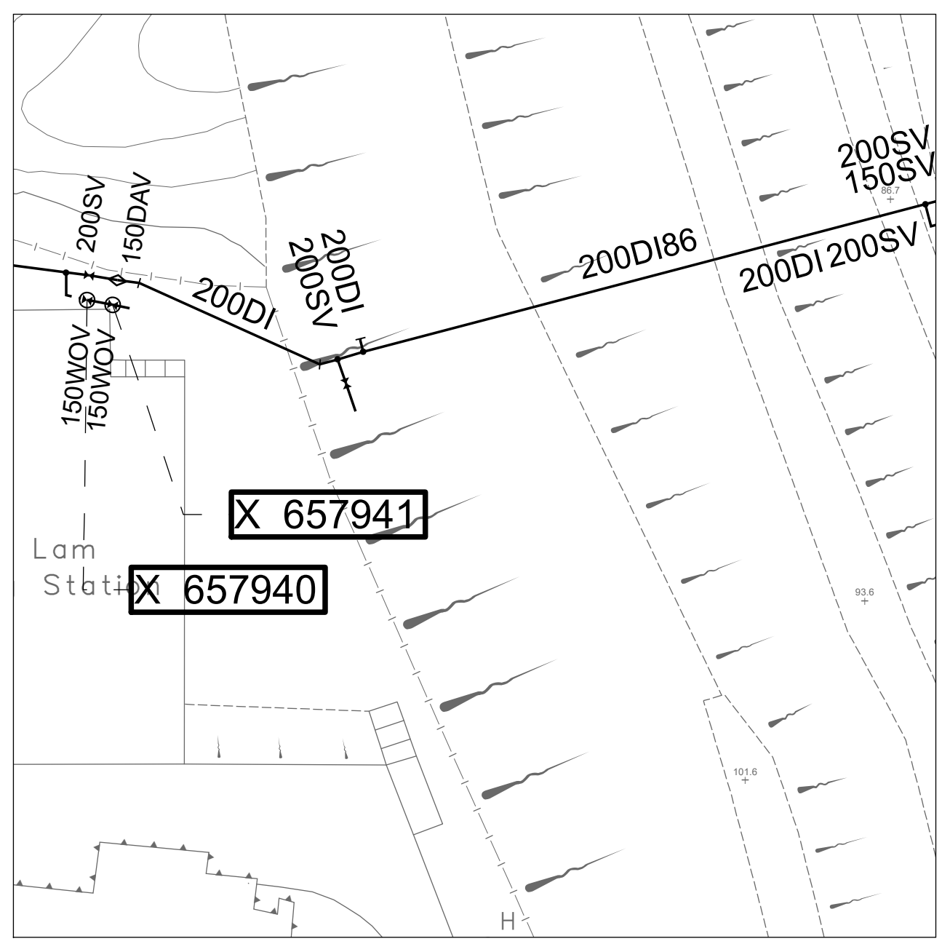
200SV
150SV
200DI86
200DI 200SV
200DI
150WOV
X 657941
X 657940
Lam Stat

Scale 1:500

INSET 'C'

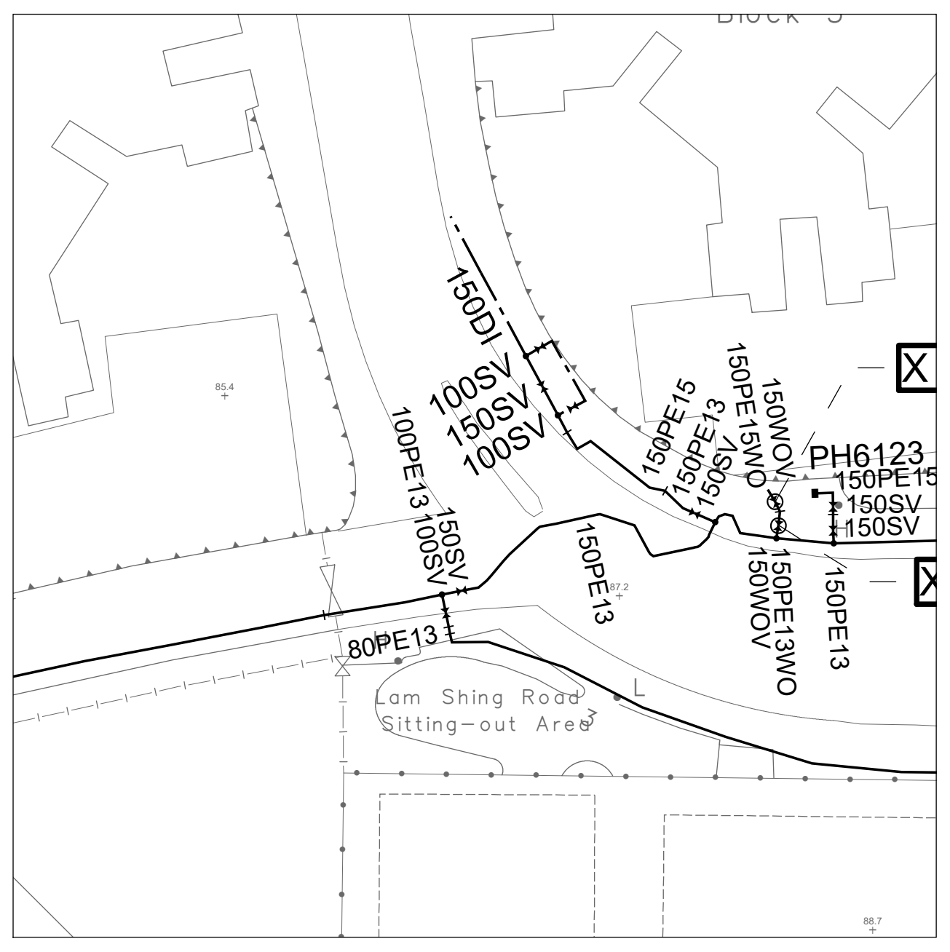
150DI
100SV
150SV
100SV
PH6123
150PE13
80PE13
Lam Shing Road Sitting-out Area

Scale 1:500

INSET 'D'

INSET 'E'

INSET 'F'

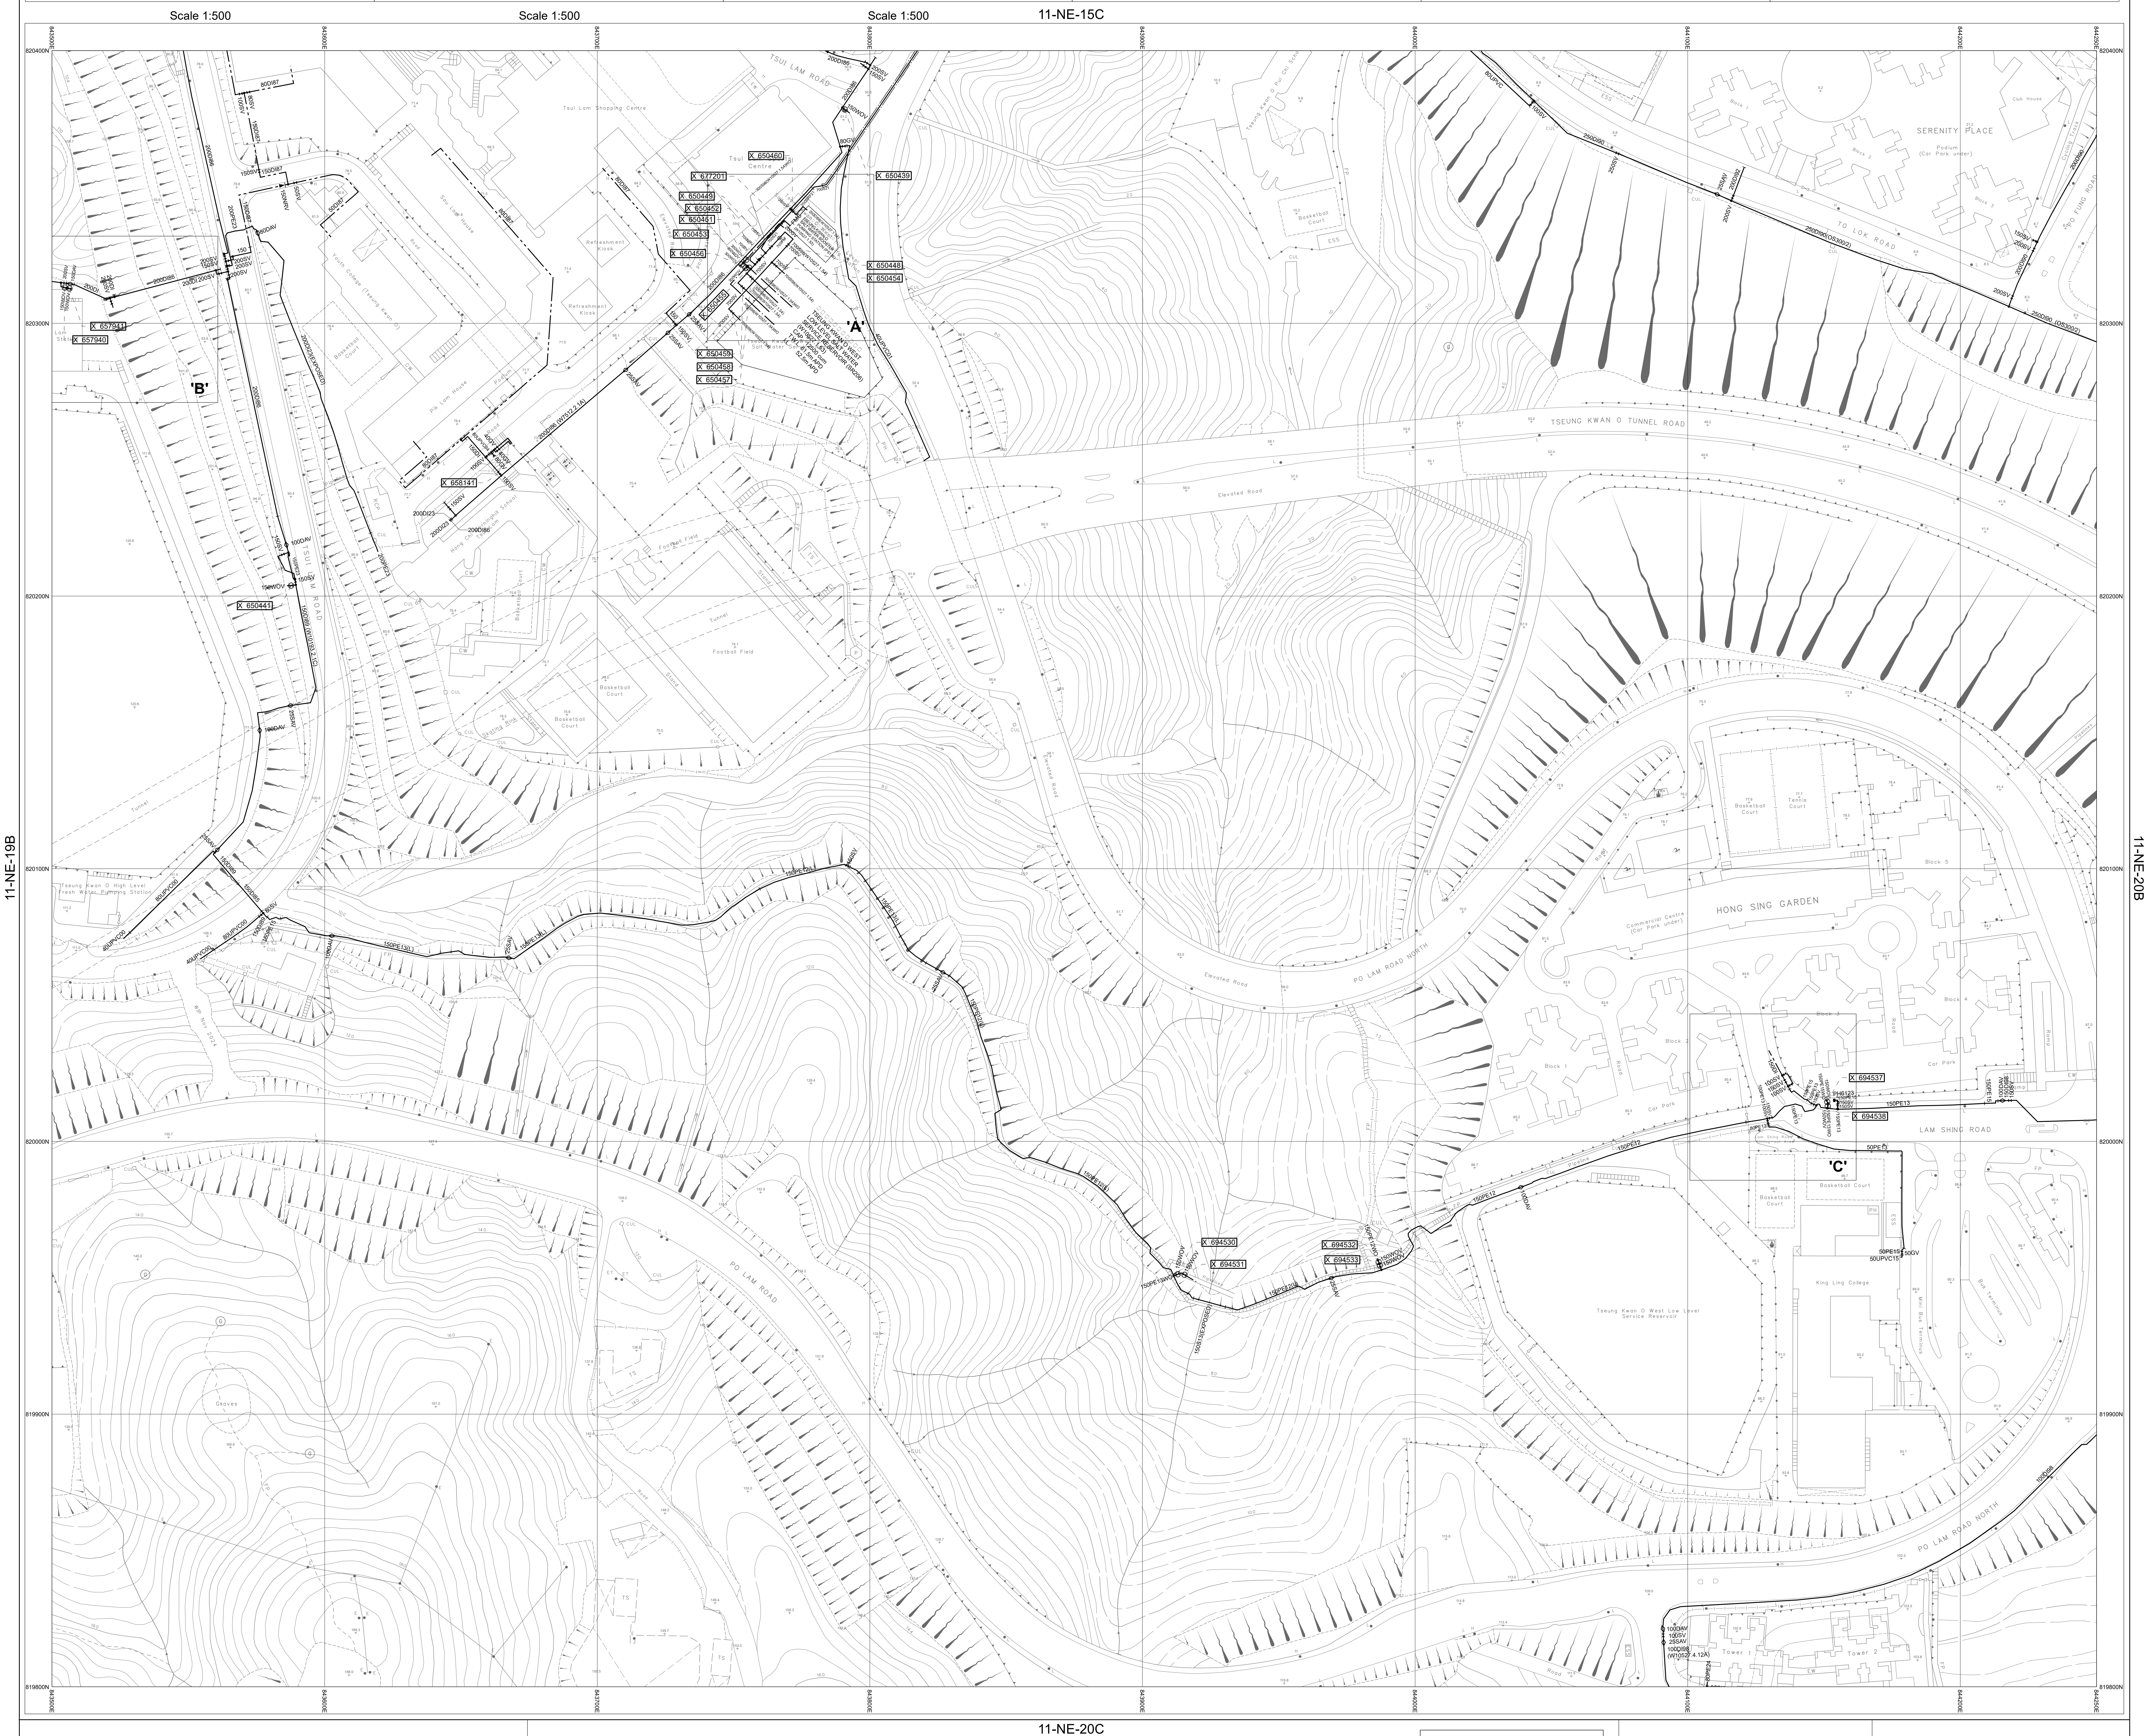
11-NE-15C
11-NE-19B
11-NE-20B
11-NE-20C
TSUI LAM ROAD
TSEUNG KWAN O TUNNEL ROAD
SERENITY PLACE
TO LOK ROAD
HONG SING GARDEN
LAM SHING ROAD
PO LAM ROAD NORTH
PO LAM ROAD
'A'
'B'
'C'
X 650441
X 694537
X 694538
X 694530
X 694531
X 694532
X 694533
X 658141
820400N
820300N
820200N
820100N
820000N
819900N
819800N

NOTES:
1. FOR MAINS RECORDS SIGN CONVENTIONS AND DESIGNATIONS SEE SKETCH NO.3988.
2. DIMENSIONS OF MAINS ARE IN MILLIMETRES UNLESS OTHERWISE SPECIFIED.
3. ALL LEVELS ARE IN METRES ABOVE PRINCIPAL DATUM.

Basemap Date Updated On: 05/01/2026

SCALE 1:1 000

METRES 20 10 0 20 40 60 80 100 METRES

SALT WATER MAINS RECORD PLAN

HONG SING GARDEN, TSUI LAM ESTATE

THIS IS A COMPUTER PRINTOUT,
NO SIGNATURE IS REQUIRED.

COPYRIGHT RESERVED

DATE REVISED : 04/06/2026

SIGNED
C.H. NG
CE/MSE
DATE: 10/06/1999

DRAWING NO.
W67881/ 11-NE-20A

Water Supplies Department
HONG KONG

© The Government of the Hong Kong SAR, Map reproduced with permission of the Director of Lands