INSET 'A'

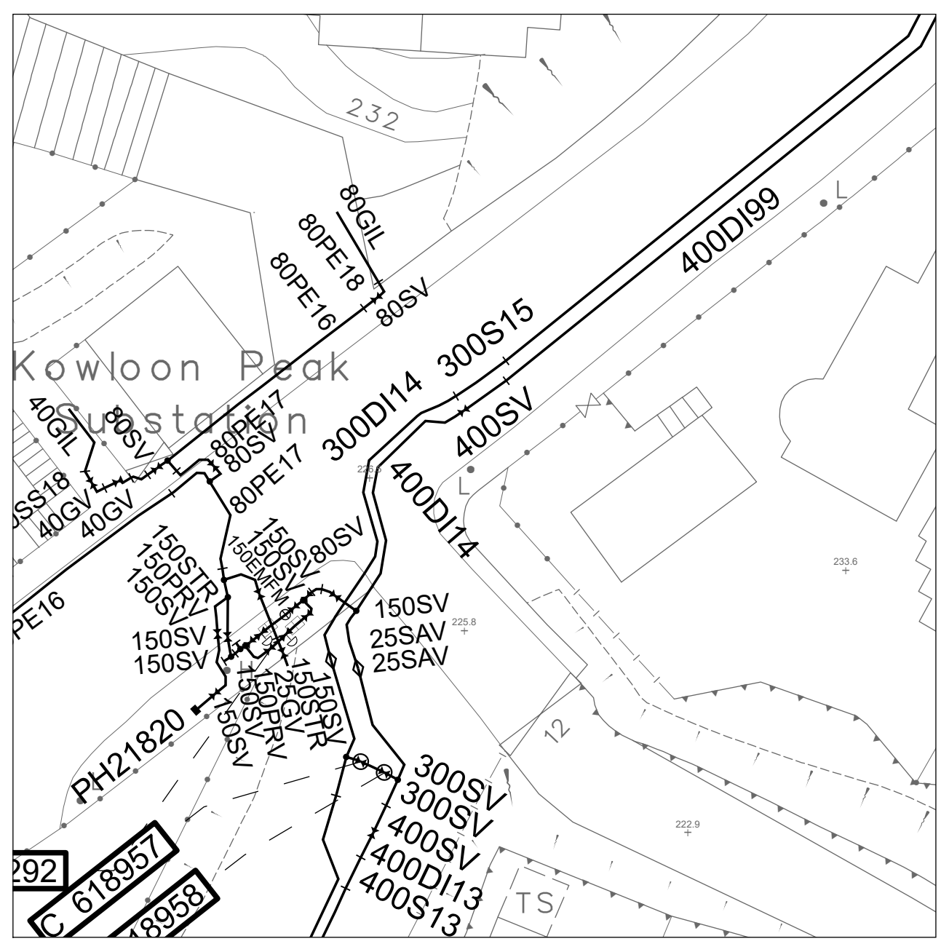
400DI99
300DI14
300S15
400SV
400DI14
PH21820
300SV
400SV
400DI13
400S13
150SV
25SAV

Scale 1:500

INSET 'B'

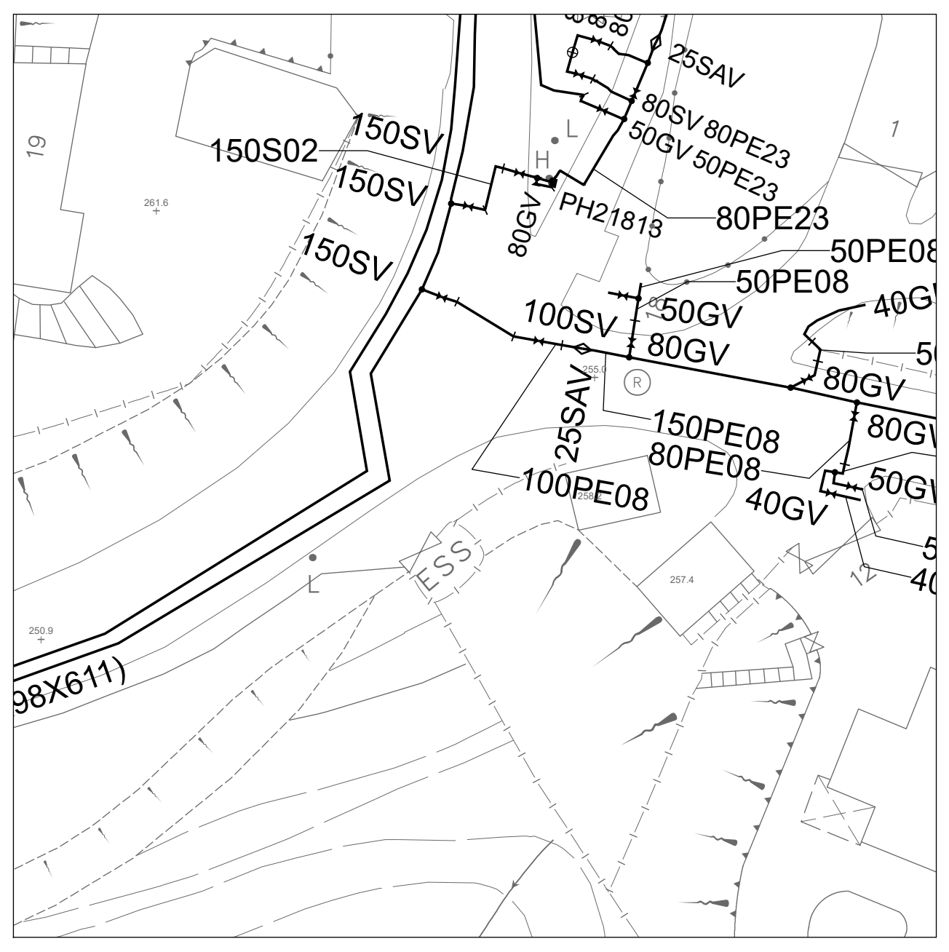
25SAV
80SV 80PE23
50GV 50PE23
150S02
150SV
150SV
80PE23
50PE08
100SV
50GV
80GV
80GV
150PE08
80PE08
100PE08
40GV
50GV
25SAV

Scale 1:500

INSET 'C'

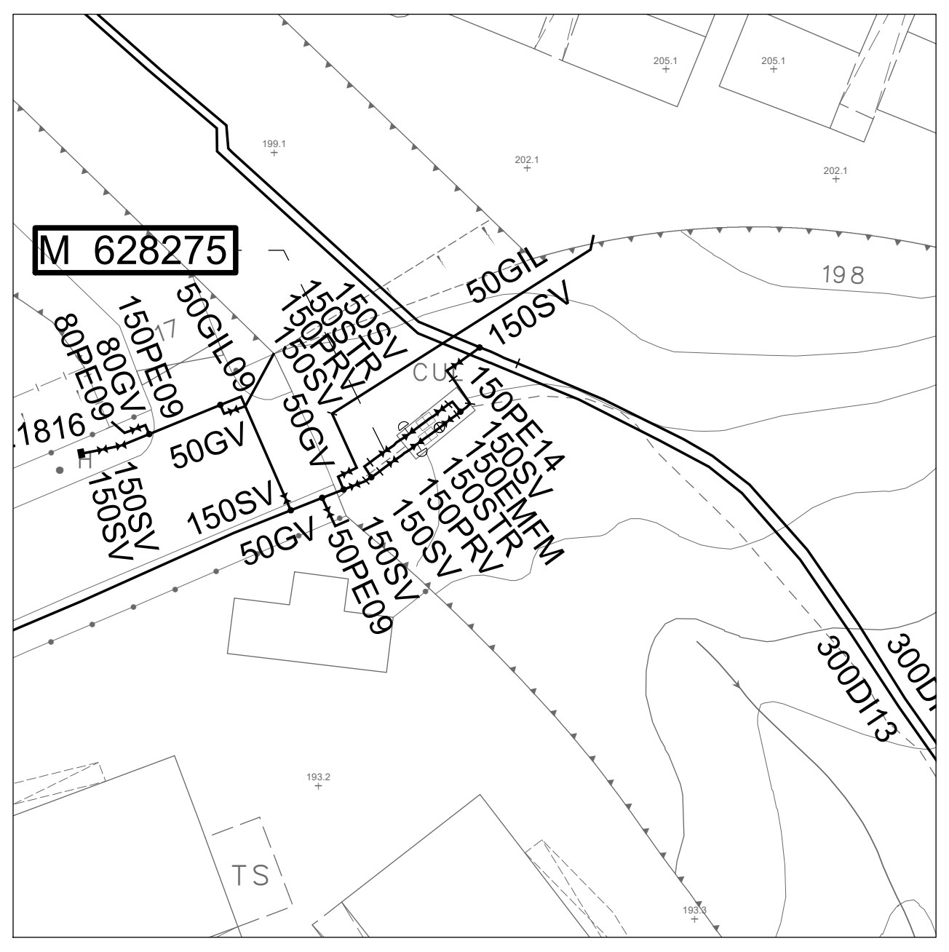
M 628275
50GIL
150SV
150PE14
50GV
150SV
50GV
150PE09
80PE09
1816
300DI13

Scale 1:500

INSET 'D'

INSET 'E'

INSET 'F'

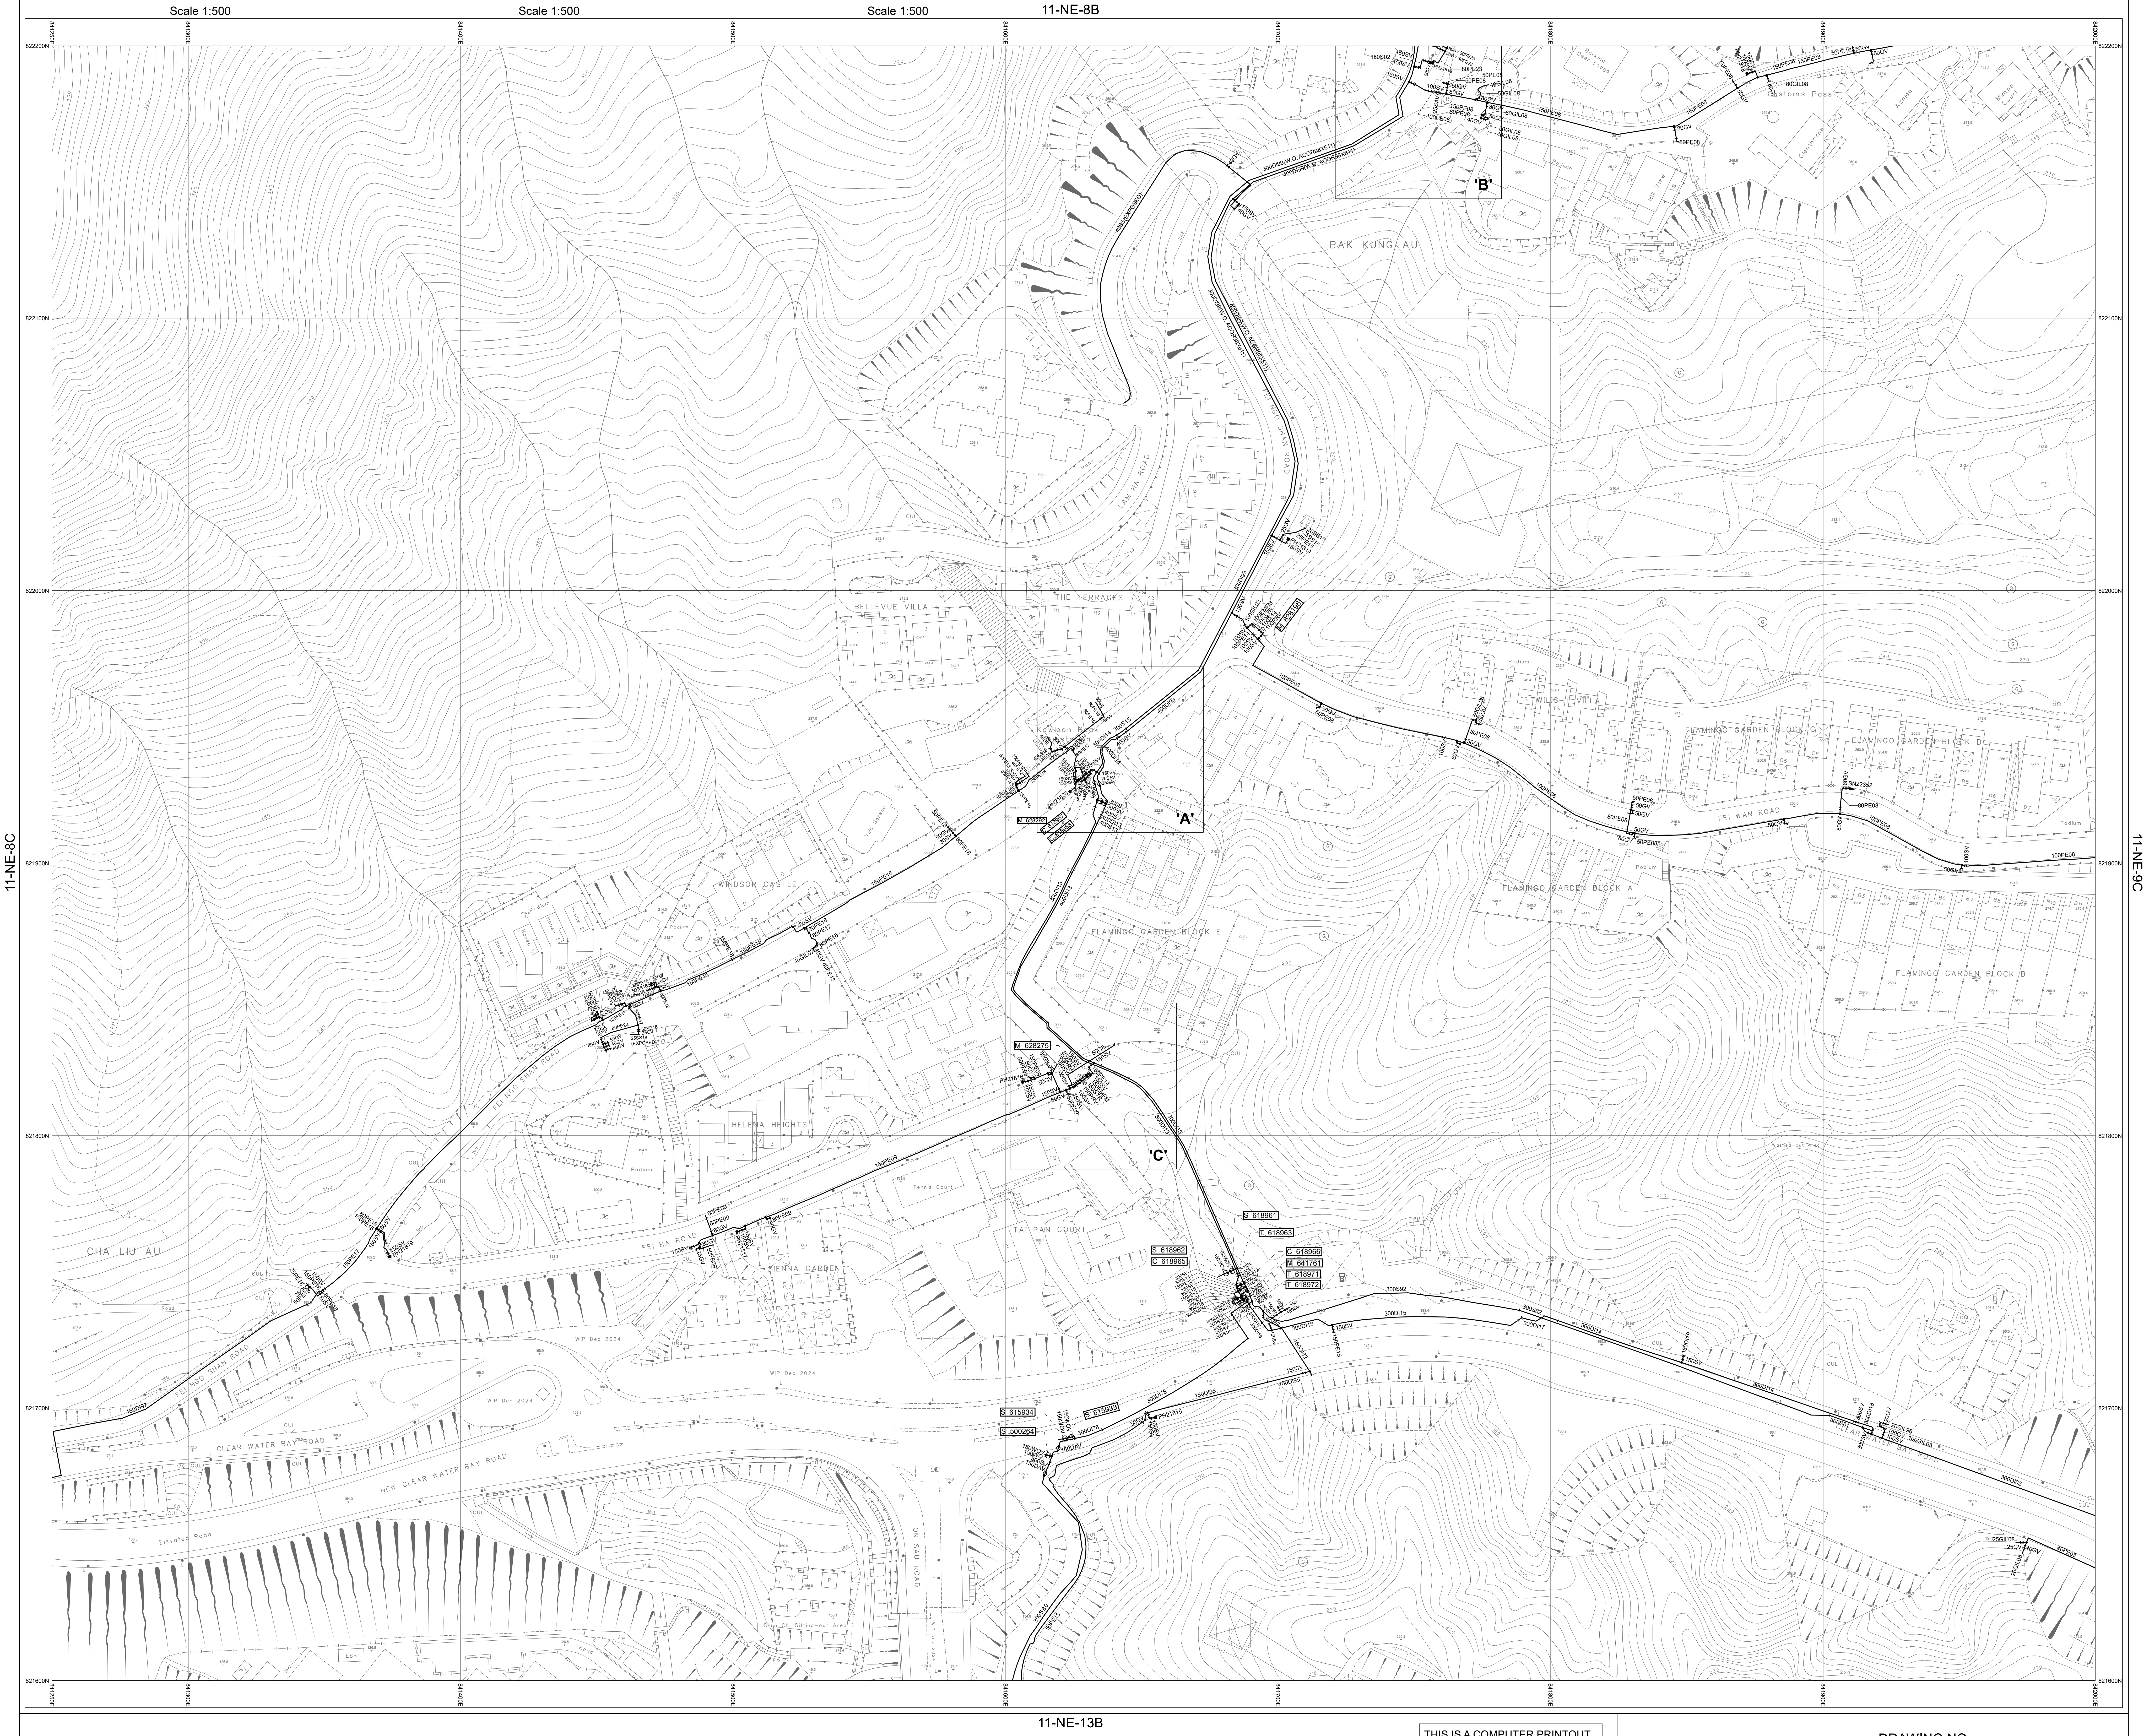
11-NE-8B
11-NE-8C
11-NE-9C
11-NE-13B
PAK KUNG AU
'A'
'B'
'C'
THE TERRACES
BELLEVUE VILLA
WINDSOR CASTLE
HELENA HEIGHTS
TAI PAN COURT
SIENNA GARDEN
FLAMINGO GARDEN BLOCK A
FLAMINGO GARDEN BLOCK B
FLAMINGO GARDEN BLOCK D
FLAMINGO GARDEN BLOCK E
FEI NGO SHAN ROAD
FEI HA ROAD
FEI WAN ROAD
LAM MA ROAD
CLEAR WATER BAY ROAD
NEW CLEAR WATER BAY ROAD
ON SAU ROAD
CHA LIU AU
Elevated Road
M 628275
S 618961
T 618963
S 618962
C 618965
S 615934
S 500284
S 615933

THIS IS A COMPUTER PRINTOUT,
NO SIGNATURE IS REQUIRED.

NOTES:

1. FOR MAINS RECORDS SIGN CONVENTIONS AND DESIGNATIONS SEE SKETCH NO.3988.
2. DIMENSIONS OF MAINS ARE IN MILLIMETRES UNLESS OTHERWISE SPECIFIED.
3. ALL LEVELS ARE IN METRES ABOVE PRINCIPAL DATUM.

Basemap Date Updated On: 05/01/2026

SCALE 1:1 000

METRES 20 10 0 20 40 60 80 100 METRES

FRESH WATER MAINS RECORD PLAN

FEI NGO SHAN ROAD, PAK KUNG AU

COPYRIGHT RESERVED

DATE REVISED : 10/04/2026

SIGNED
C.H. NG
CE/MSE
DATE: 10/06/1999

DRAWING NO.
W67880/ 11-NE-8D

Water Supplies Department
HONG KONG

© The Government of the Hong Kong SAR, Map reproduced with permission of the Director of Lands