INSET 'A'	INSET 'B'	INSET 'C'	INSET 'D'	INSET 'E'	INSET 'F'

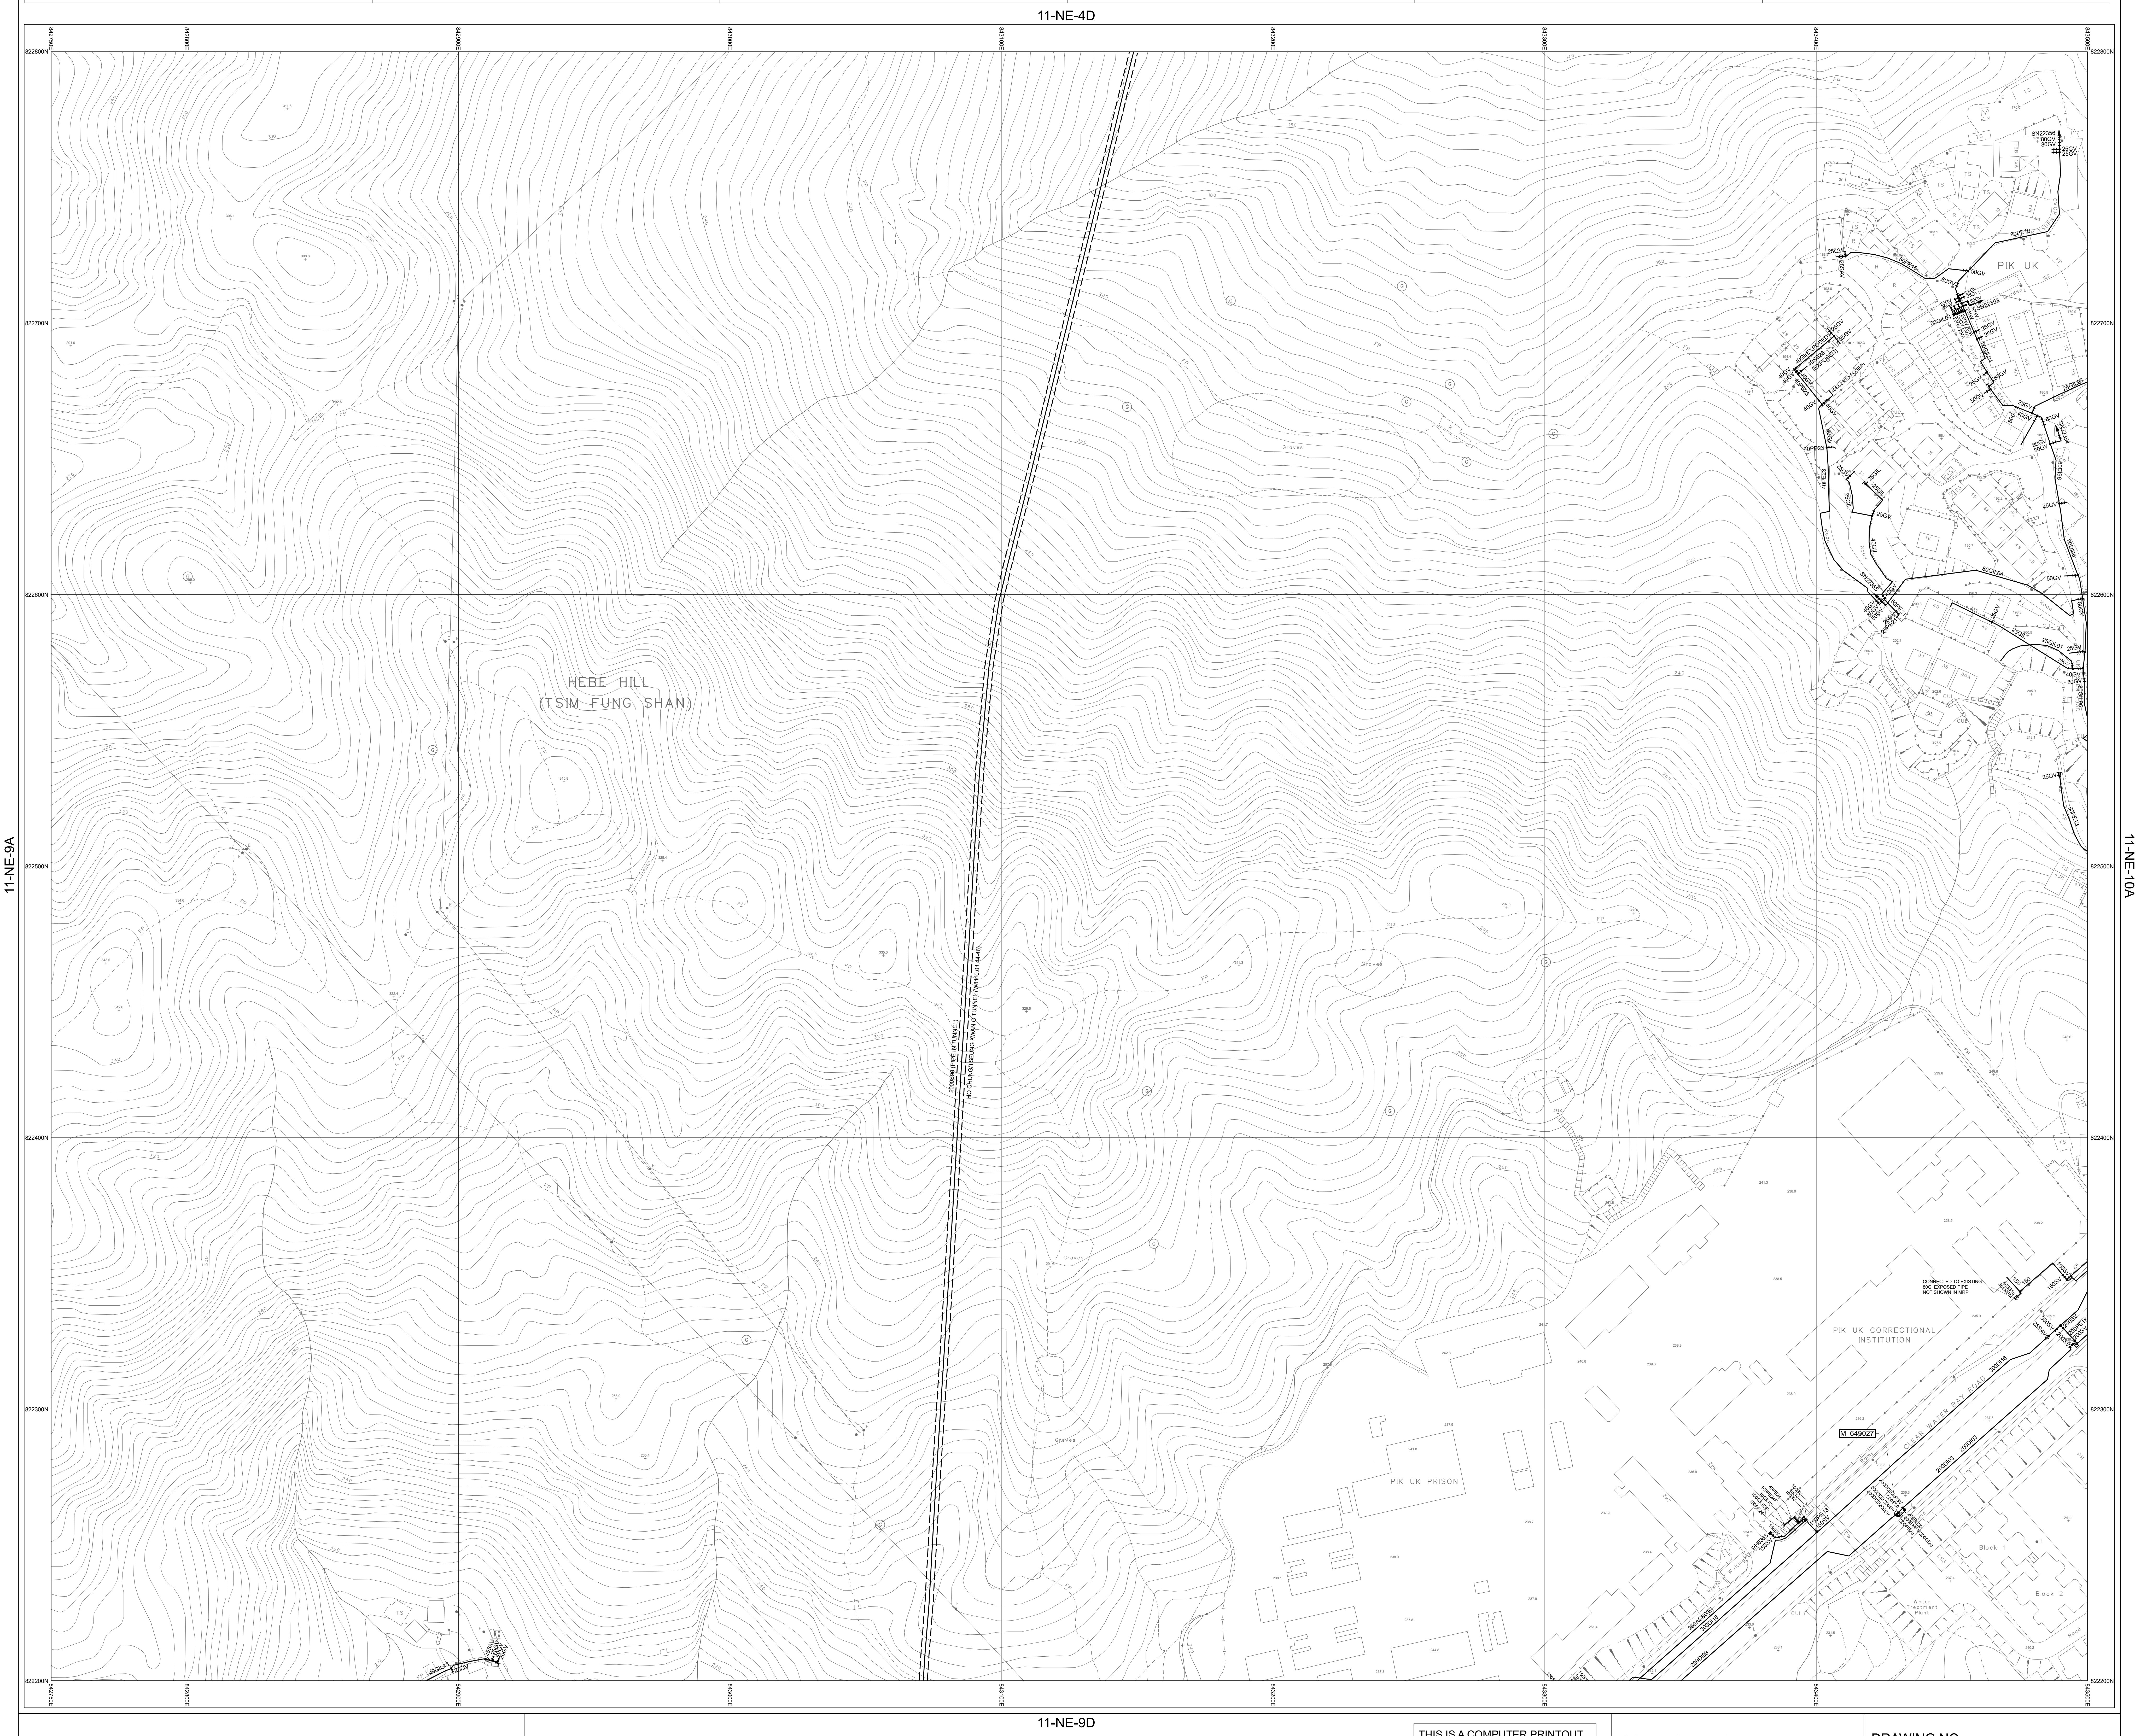
11-NE-4D
11-NE-9A
11-NE-10A
11-NE-9D
HEBE HILL
(TSIM FUNG SHAN)
PIK UK
PIK UK CORRECTIONAL INSTITUTION
PIK UK PRISON
CLEAR WATER BAY ROAD
Graves
Block 1
Block 2
Water Treatment Plant
CONNECTED TO EXISTING 80GI EXPOSED PIPE NOT SHOWN IN MRP
M 649027
300DI16
200DI03
822200N
822300N
822400N
822500N
822600N
822700N
822800N
842750E
842800E
842900E
843000E
843100E
843200E
843300E
843400E
843500E

NOTES:

1. FOR MAINS RECORDS SIGN CONVENTIONS AND DESIGNATIONS SEE SKETCH NO.3988.
2. DIMENSIONS OF MAINS ARE IN MILLIMETRES UNLESS OTHERWISE SPECIFIED.
3. ALL LEVELS ARE IN METRES ABOVE PRINCIPAL DATUM.

Basemap Date Updated On: 05/01/2026

SCALE 1:1 000

METRES 20 10 0 20 40 60 80 100 METRES

THIS IS A COMPUTER PRINTOUT,
NO SIGNATURE IS REQUIRED.

FRESH WATER MAINS RECORD PLAN

PIK UK PRISON, TSIM FUNG SHAN

COPYRIGHT RESERVED

DATE REVISED : 02/03/2026

SIGNED C.H. NG
CE/MSE
DATE: 10/06/1999

DRAWING NO.
W67880/ 11-NE-9B

Water Supplies Department
HONG KONG

© The Government of the Hong Kong SAR, Map reproduced with permission of the Director of Lands