INSET 'A'	INSET 'B'	INSET 'C'	INSET 'D'	INSET 'E'	INSET 'F'

8-NW-22C

8-SW-1B

8-SW-2B

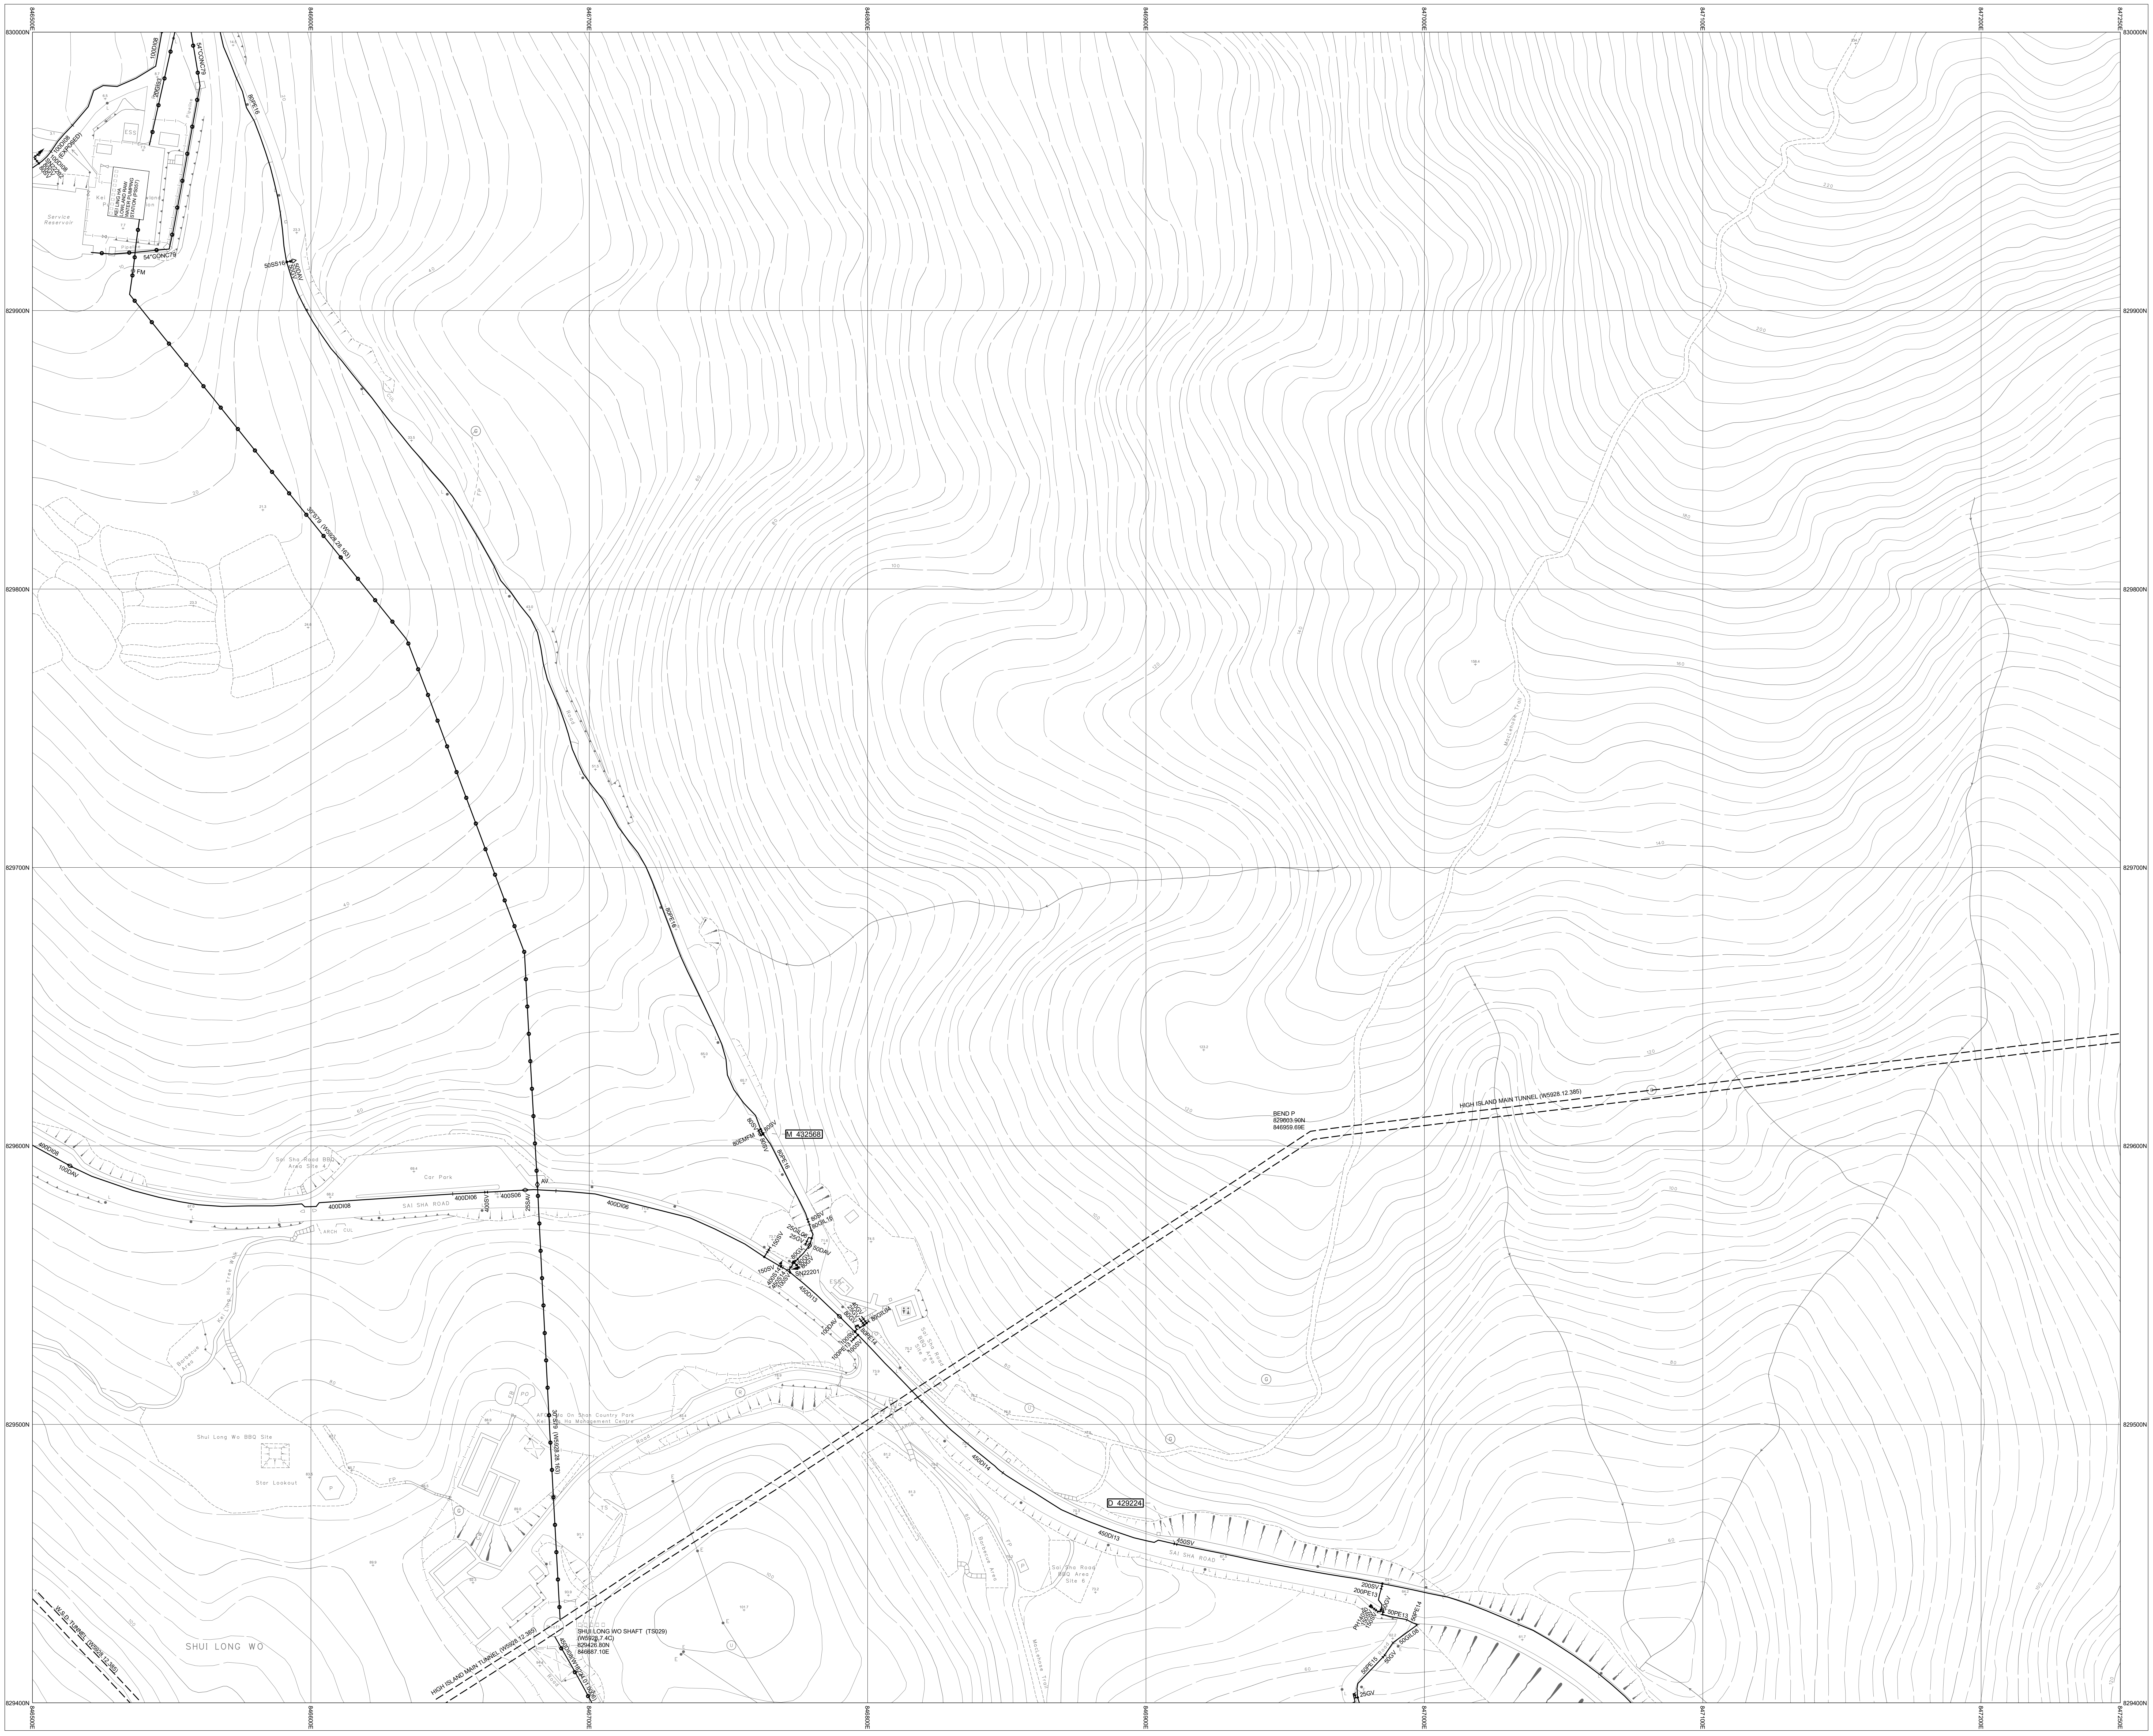
846500E
846600E
846700E
846800E
846900E
847000E
847100E
847200E
830000N
829900N
829800N
829700N
829600N
829500N
829400N
100DI08
100DI08 (EXPOSED)
SN22202
80GV
80SV
20GI93
54"CONC79
KEI LING HA LOWLAND RAW WATER PUMPING STATION (PS057)
Service Reservoir
ESS
Pipeline
FM
80PE16
50SS16
50DAV
50GV
30ST9 (W5928.28.163)
M 432568
80SV
80EMFM
Car Park
SAI SHA ROAD
400DI06
400SV
400S06
25SAV
AV
80GIL16
25GIL06
25GV
50DAV
150SV
80GV
SN22201
400S14
450S14
100SV
450DI13
80GIL04
100DAV
80PE14
100PE13
Sai Sha Road BBQ Area Site 5
AFCD Ma On Shan Country Park Kei Ling Ha Management Centre
Shui Long Wo BBQ Site
Star Lookout
SHUI LONG WO SHAFT (TS029)
(W5928.7.4C)
829426.80N
846687.10E
450DI08(W1824.01.006)
HIGH ISLAND MAIN TUNNEL (W5928.12.385)
450DI14
D 429224
450DI13
450SV
Barbecue Area
Sai Sha Road BBQ Area Site 6
MacLehose Trail
BEND P
829603.90N
846959.69E
SHUI LONG WO
PH1
50PE13
50GI
25GV
50PE15

8-SW-2C

NOTES:
1. FOR MAINS RECORDS SIGN CONVENTIONS AND DESIGNATIONS SEE SKETCH NO.3988.
2. DIMENSIONS OF MAINS ARE IN MILLIMETRES UNLESS OTHERWISE SPECIFIED.
3. ALL LEVELS ARE IN METRES ABOVE PRINCIPAL DATUM.

Basemap Date Updated On: 05/01/2026

SCALE 1:1 000

METRES 20 10 0 20 40 60 80 100 METRES

FRESH WATER MAINS RECORD PLAN

SHUI LONG WO, SAI KUNG

THIS IS A COMPUTER PRINTOUT,
NO SIGNATURE IS REQUIRED.

COPYRIGHT RESERVED

DATE REVISED : 02/03/2026

SIGNED
C.H. NG
CE/MSE
DATE: 13/05/1999

DRAWING NO.
W67880/ 8-SW-2A

Water Supplies Department
HONG KONG

© The Government of the Hong Kong SAR, Map reproduced with permission of the Director of Lands