INSET 'A'	INSET 'B'	INSET 'C'	INSET 'D'	INSET 'E'	INSET 'F'

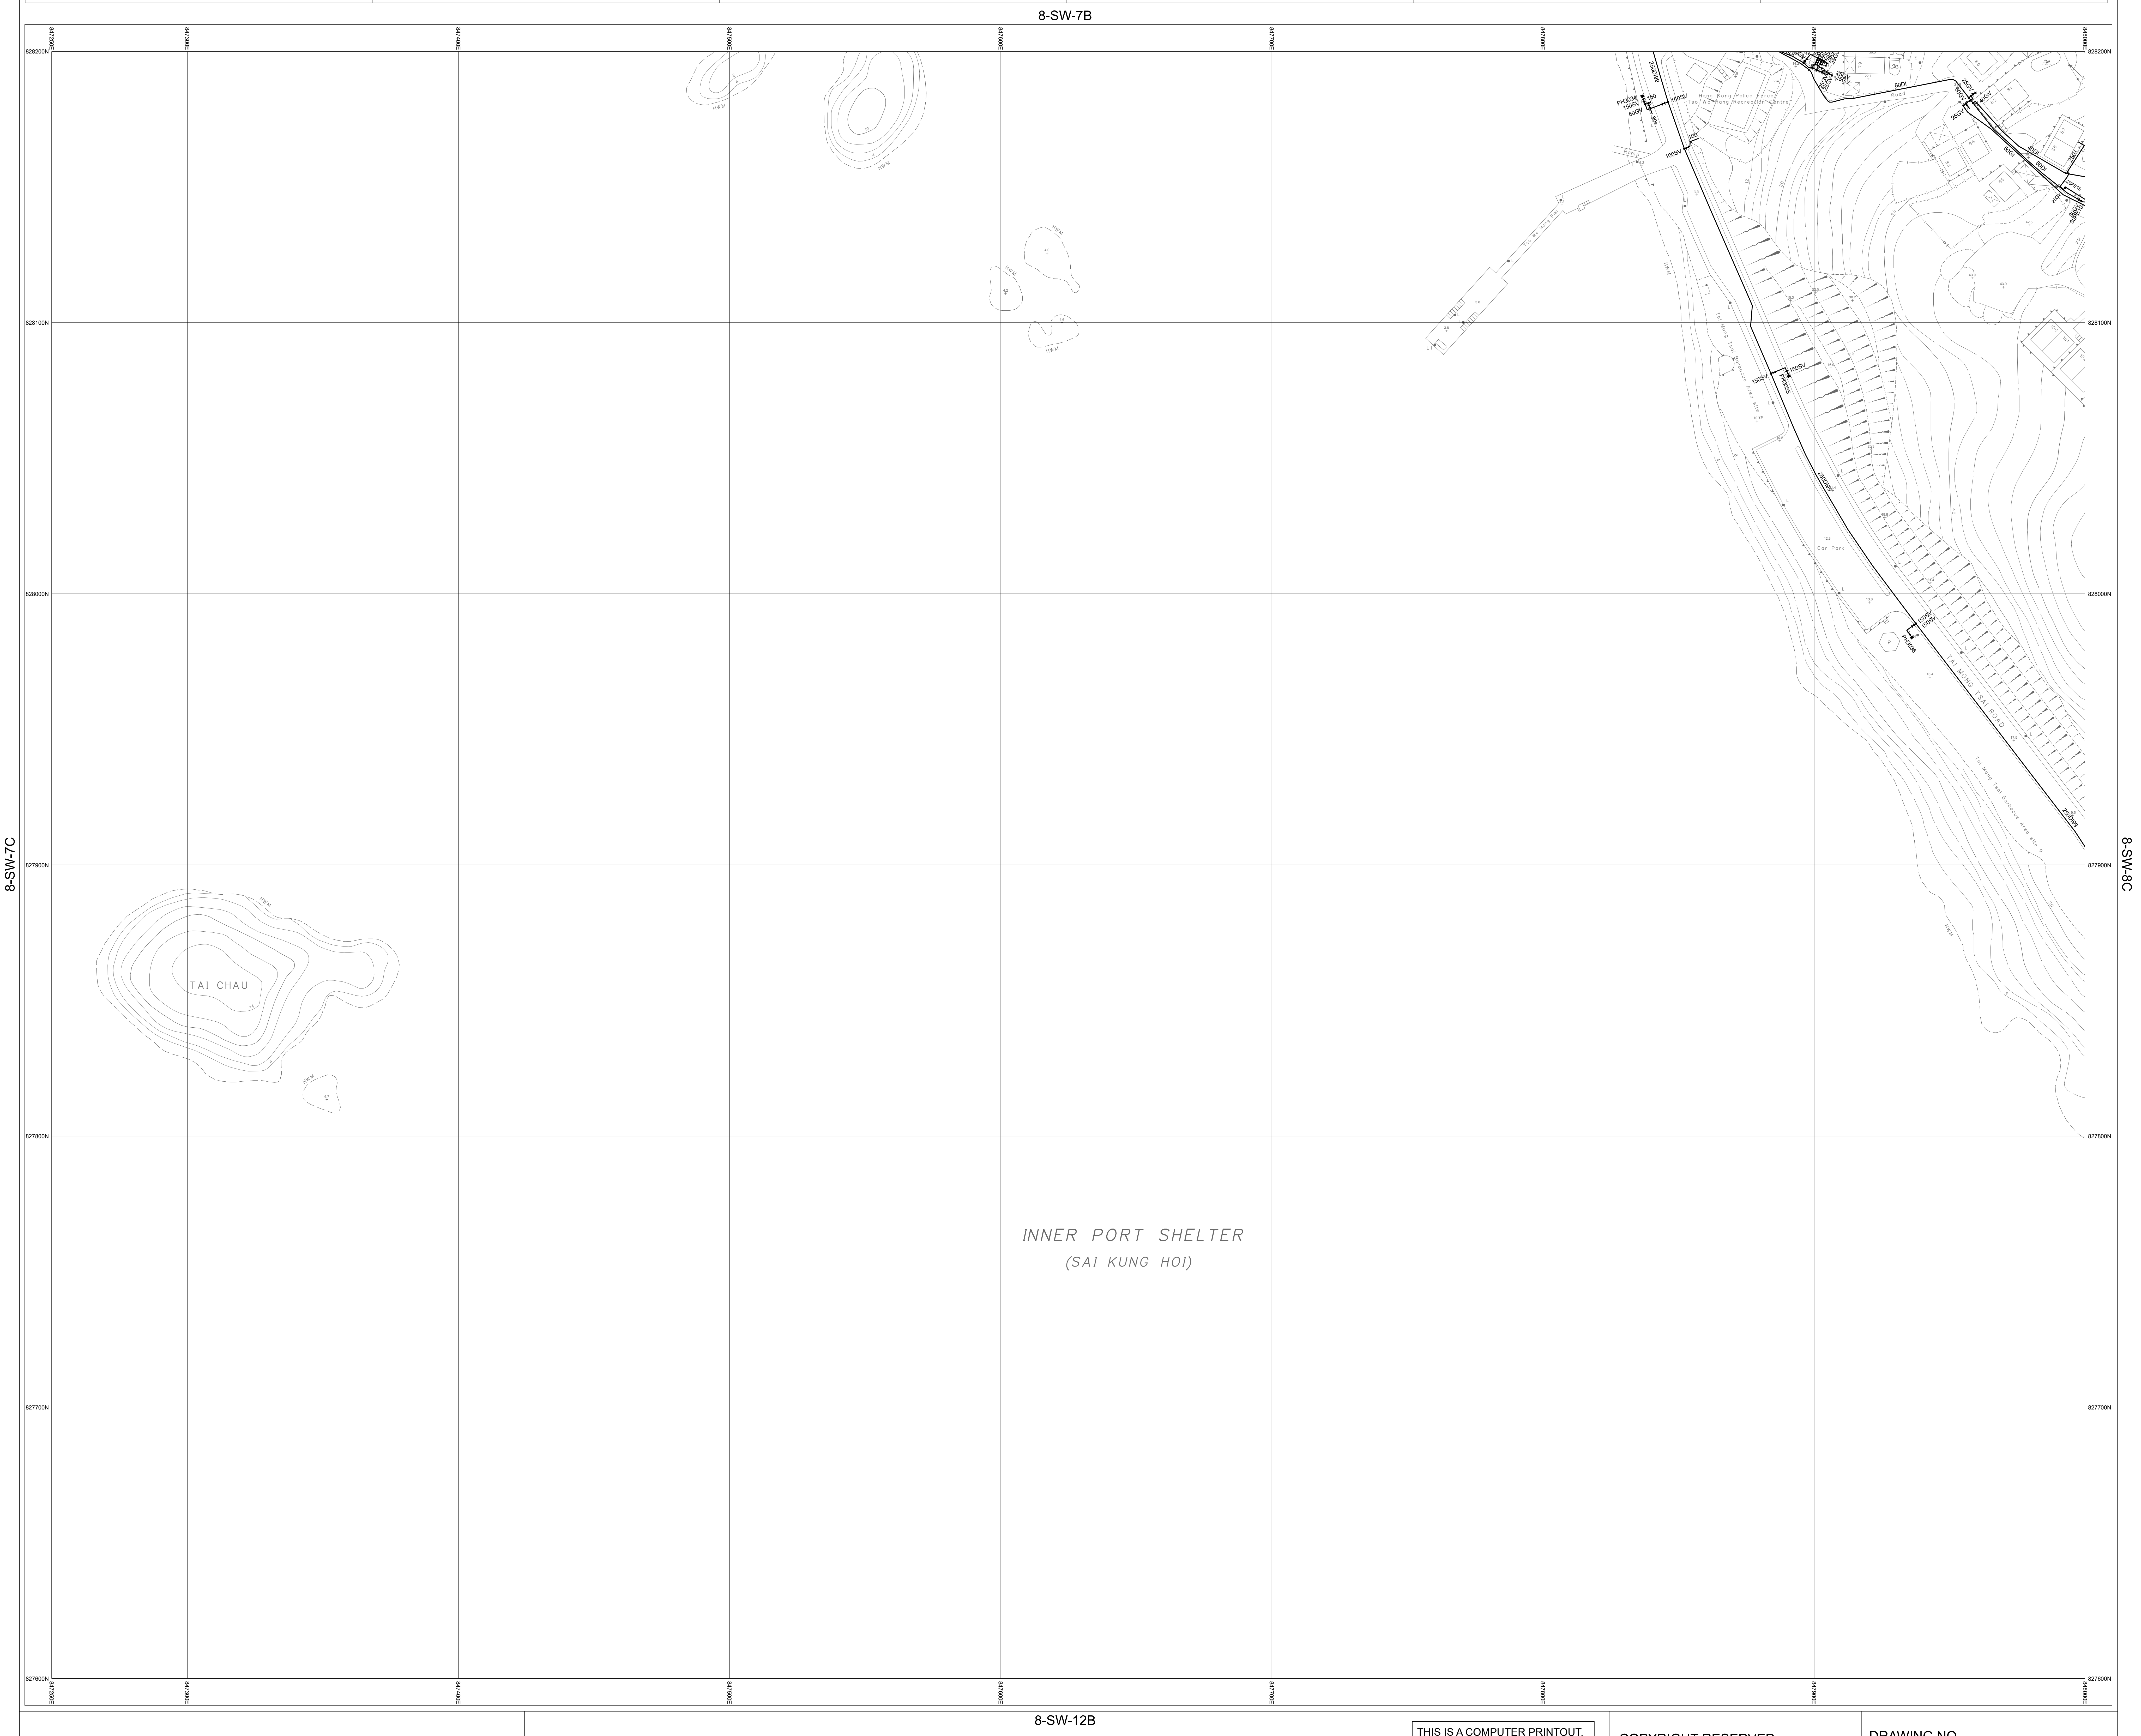
8-SW-7B
8-SW-7C
8-SW-8C
8-SW-12B
828200N
828100N
828000N
827900N
827800N
827700N
827600N
847250E
847300E
847400E
847900E
848000E
TAI CHAU
INNER PORT SHELTER
(SAI KUNG HOI)
TAI MONG TSAI ROAD
Hong Kong Police Force
Tso Wo Hang Recreation Centre
Road
Ramp
Tai Mong Tsai Barbecue Area site 8
Tai Mong Tsai Barbecue Area site 9
Car Park
HWM
P
250DI99
PH3034
150SV
80GV
150
80
100
100SV
PH3035
PH3036
80DI
25GV
50GV
40GV
50GI
40GI
25GI
25PE15
80GV
80PE10
FP

NOTES:

1. FOR MAINS RECORDS SIGN CONVENTIONS AND DESIGNATIONS SEE SKETCH NO.3988.
2. DIMENSIONS OF MAINS ARE IN MILLIMETRES UNLESS OTHERWISE SPECIFIED.
3. ALL LEVELS ARE IN METRES ABOVE PRINCIPAL DATUM.

Basemap Date Updated On: 23/12/2024

SCALE 1:1 000

METRES 20 10 0 20 40 60 80 100 METRES

THIS IS A COMPUTER PRINTOUT,
NO SIGNATURE IS REQUIRED.

FRESH WATER MAINS RECORD PLAN

SAN TIN HANG, SAI KUNG

COPYRIGHT RESERVED

DATE REVISED : 05/03/2025

SIGNED
C.H. NG
CE/MSE
DATE: 13/05/1999

DRAWING NO.
W67880/ 8-SW-7D

Water Supplies Department
HONG KONG

© The Government of the Hong Kong SAR, Map reproduced with permission of the Director of Lands