INSET 'A'	INSET 'B'	INSET 'C'	INSET 'D'	INSET 'E'	INSET 'F'

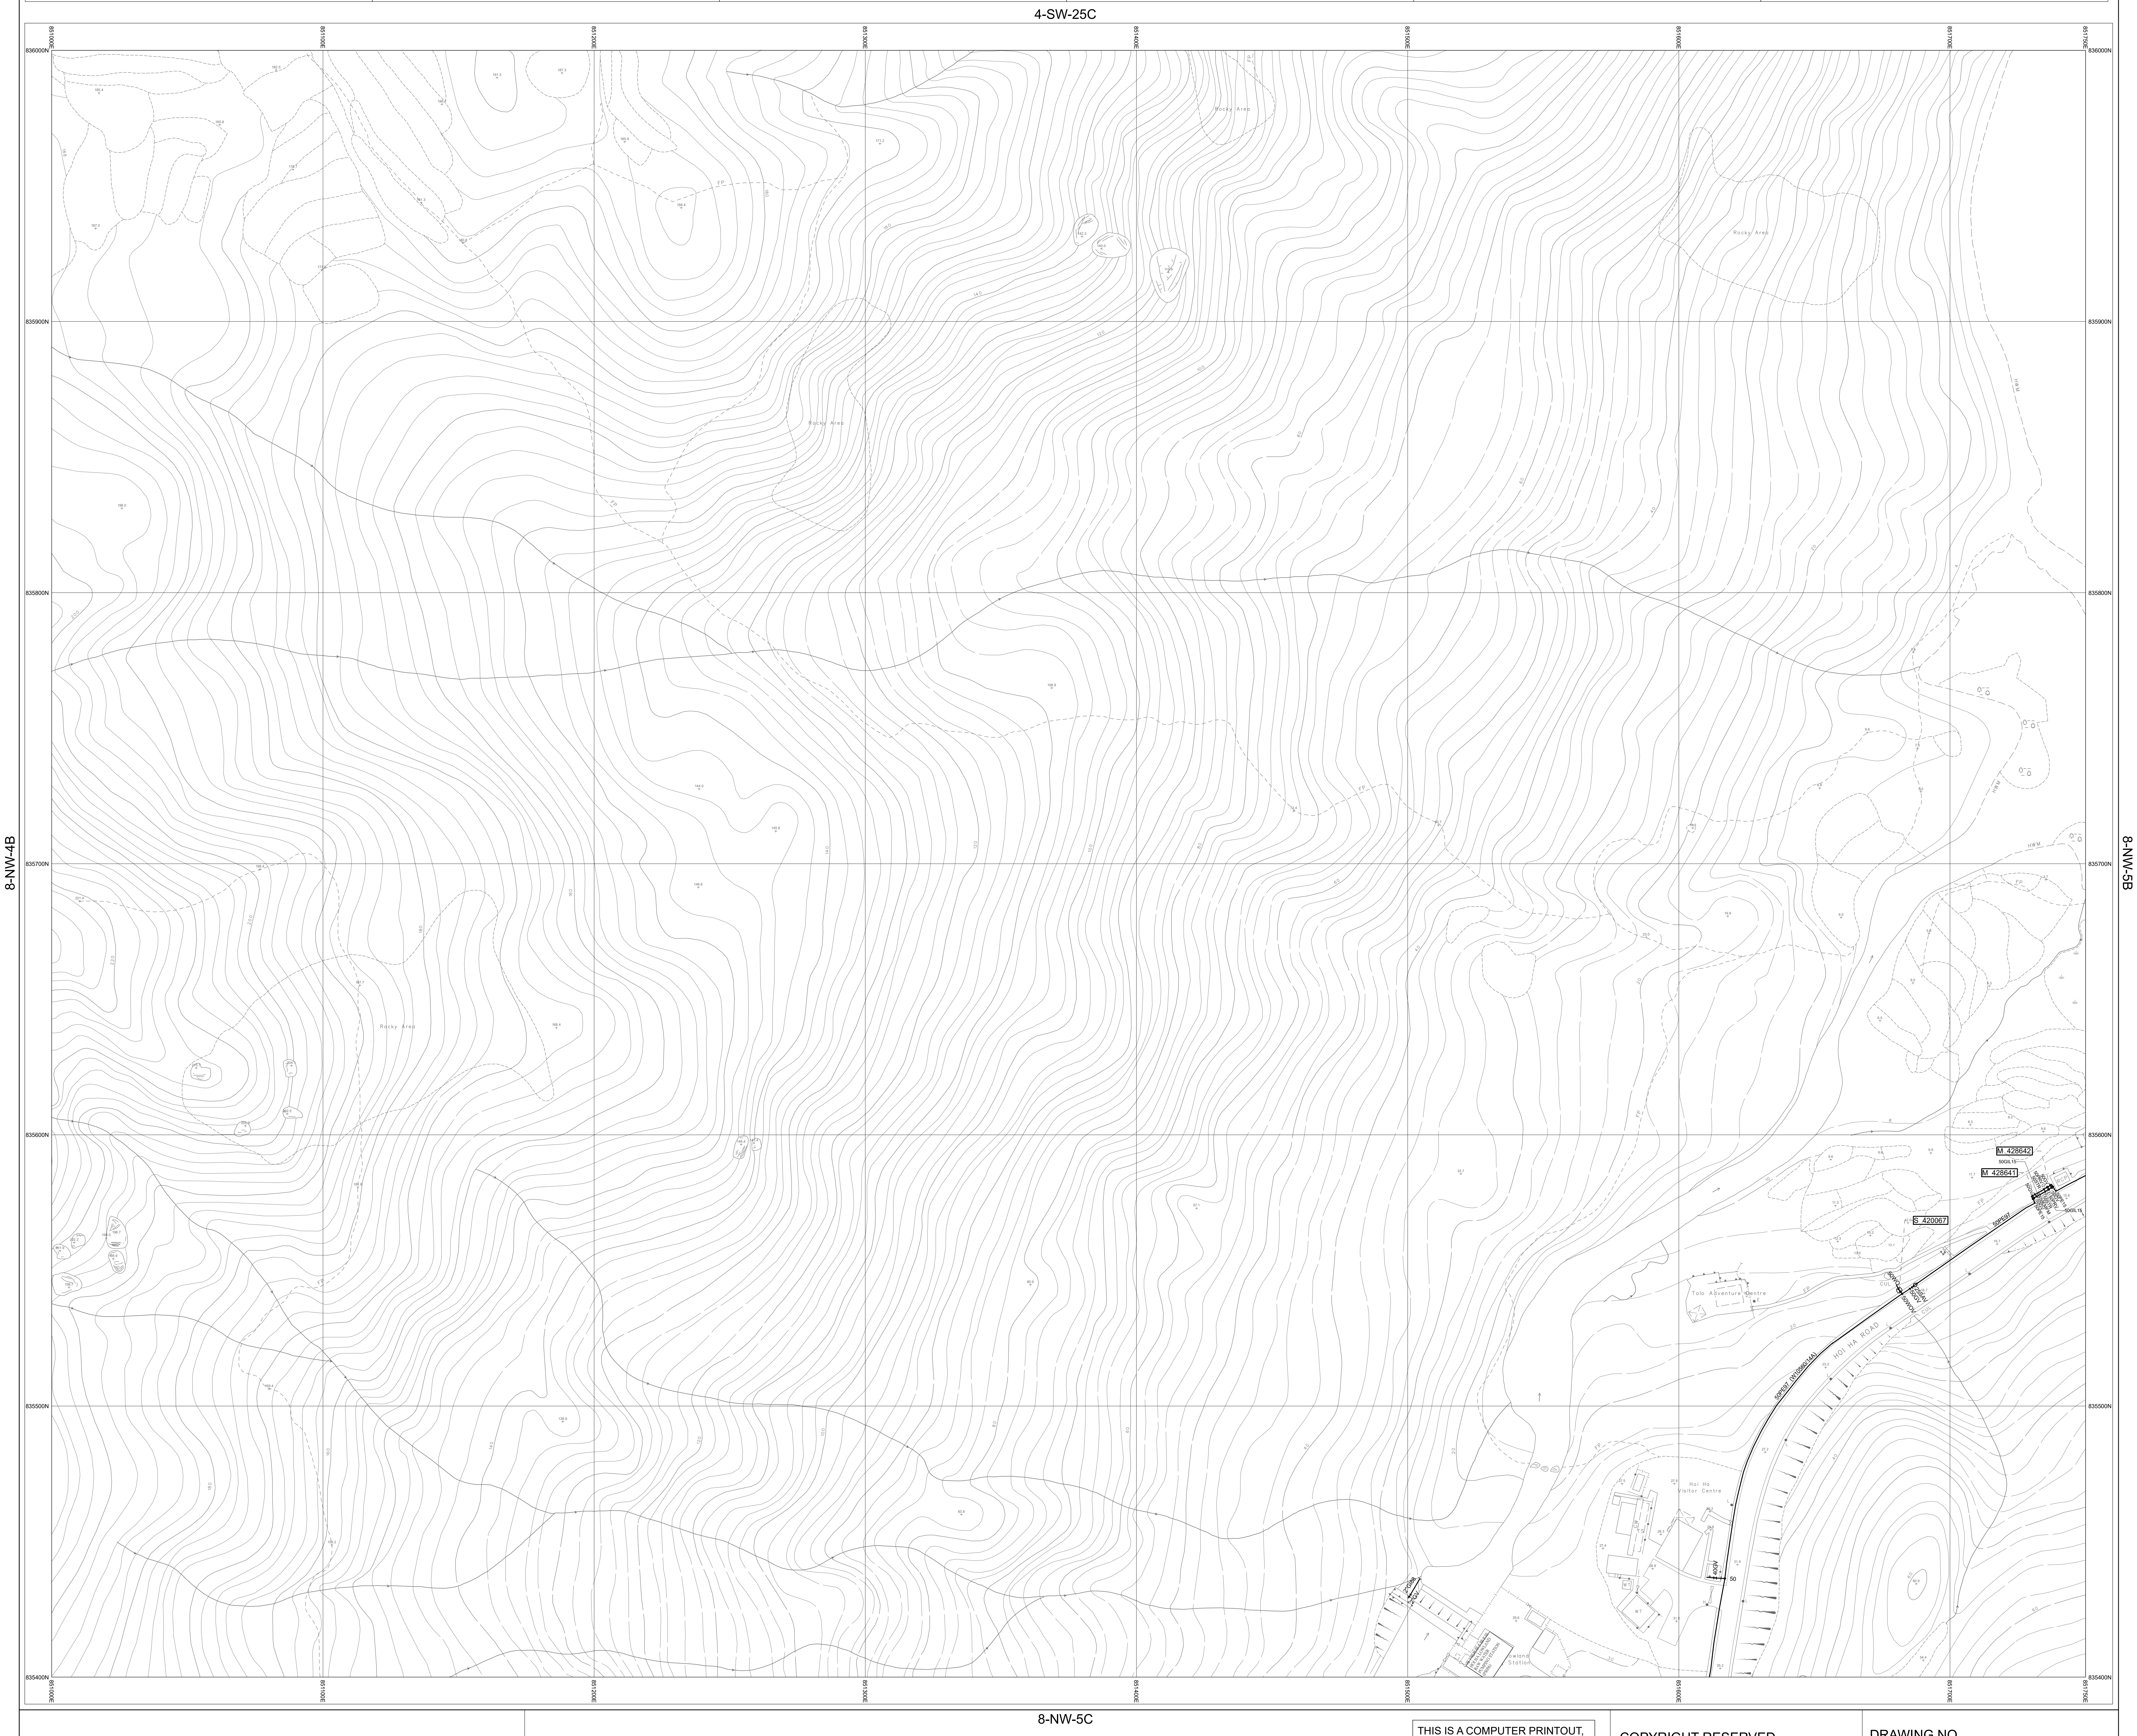
4-SW-25C
8-NW-4B
8-NW-5B
8-NW-5C
836000N
835900N
835800N
835700N
835600N
835500N
835400N
851000E
851100E
851200E
851300E
851400E
851500E
851600E
851700E
851750E
Rocky Area
Tolo Adventure Centre
Hoi Ha Visitor Centre
HOI HA ROAD
M 428642
M 428641
S 420067
50GIL15
50PE97
50PE97 (W10560/14A)
50WO
25SAV
50GV
50WOV
40GV
50
CUL
RCP
FP
WT
CW
TS

NOTES:
1. FOR MAINS RECORDS SIGN CONVENTIONS AND DESIGNATIONS SEE SKETCH NO.3988.
2. DIMENSIONS OF MAINS ARE IN MILLIMETRES UNLESS OTHERWISE SPECIFIED.
3. ALL LEVELS ARE IN METRES ABOVE PRINCIPAL DATUM.

Basemap Date Updated On: 23/12/2024

SCALE 1:1 000

METRES 20 10 0 20 40 60 80 100 METRES

THIS IS A COMPUTER PRINTOUT,
NO SIGNATURE IS REQUIRED.

FRESH WATER MAINS RECORD PLAN

HOI HA LOWLAND P/S

COPYRIGHT RESERVED

DATE REVISED : 31/12/2024

DRAWING NO.

W67880/ 8-NW-5A

SIGNED C.H. NG
CE/MSE
DATE: 13/05/1999

Water Supplies Department
HONG KONG

© The Government of the Hong Kong SAR, Map reproduced with permission of the Director of Lands