INSET 'A' | INSET 'B' | INSET 'C' | INSET 'D' | INSET 'E' | INSET 'F'

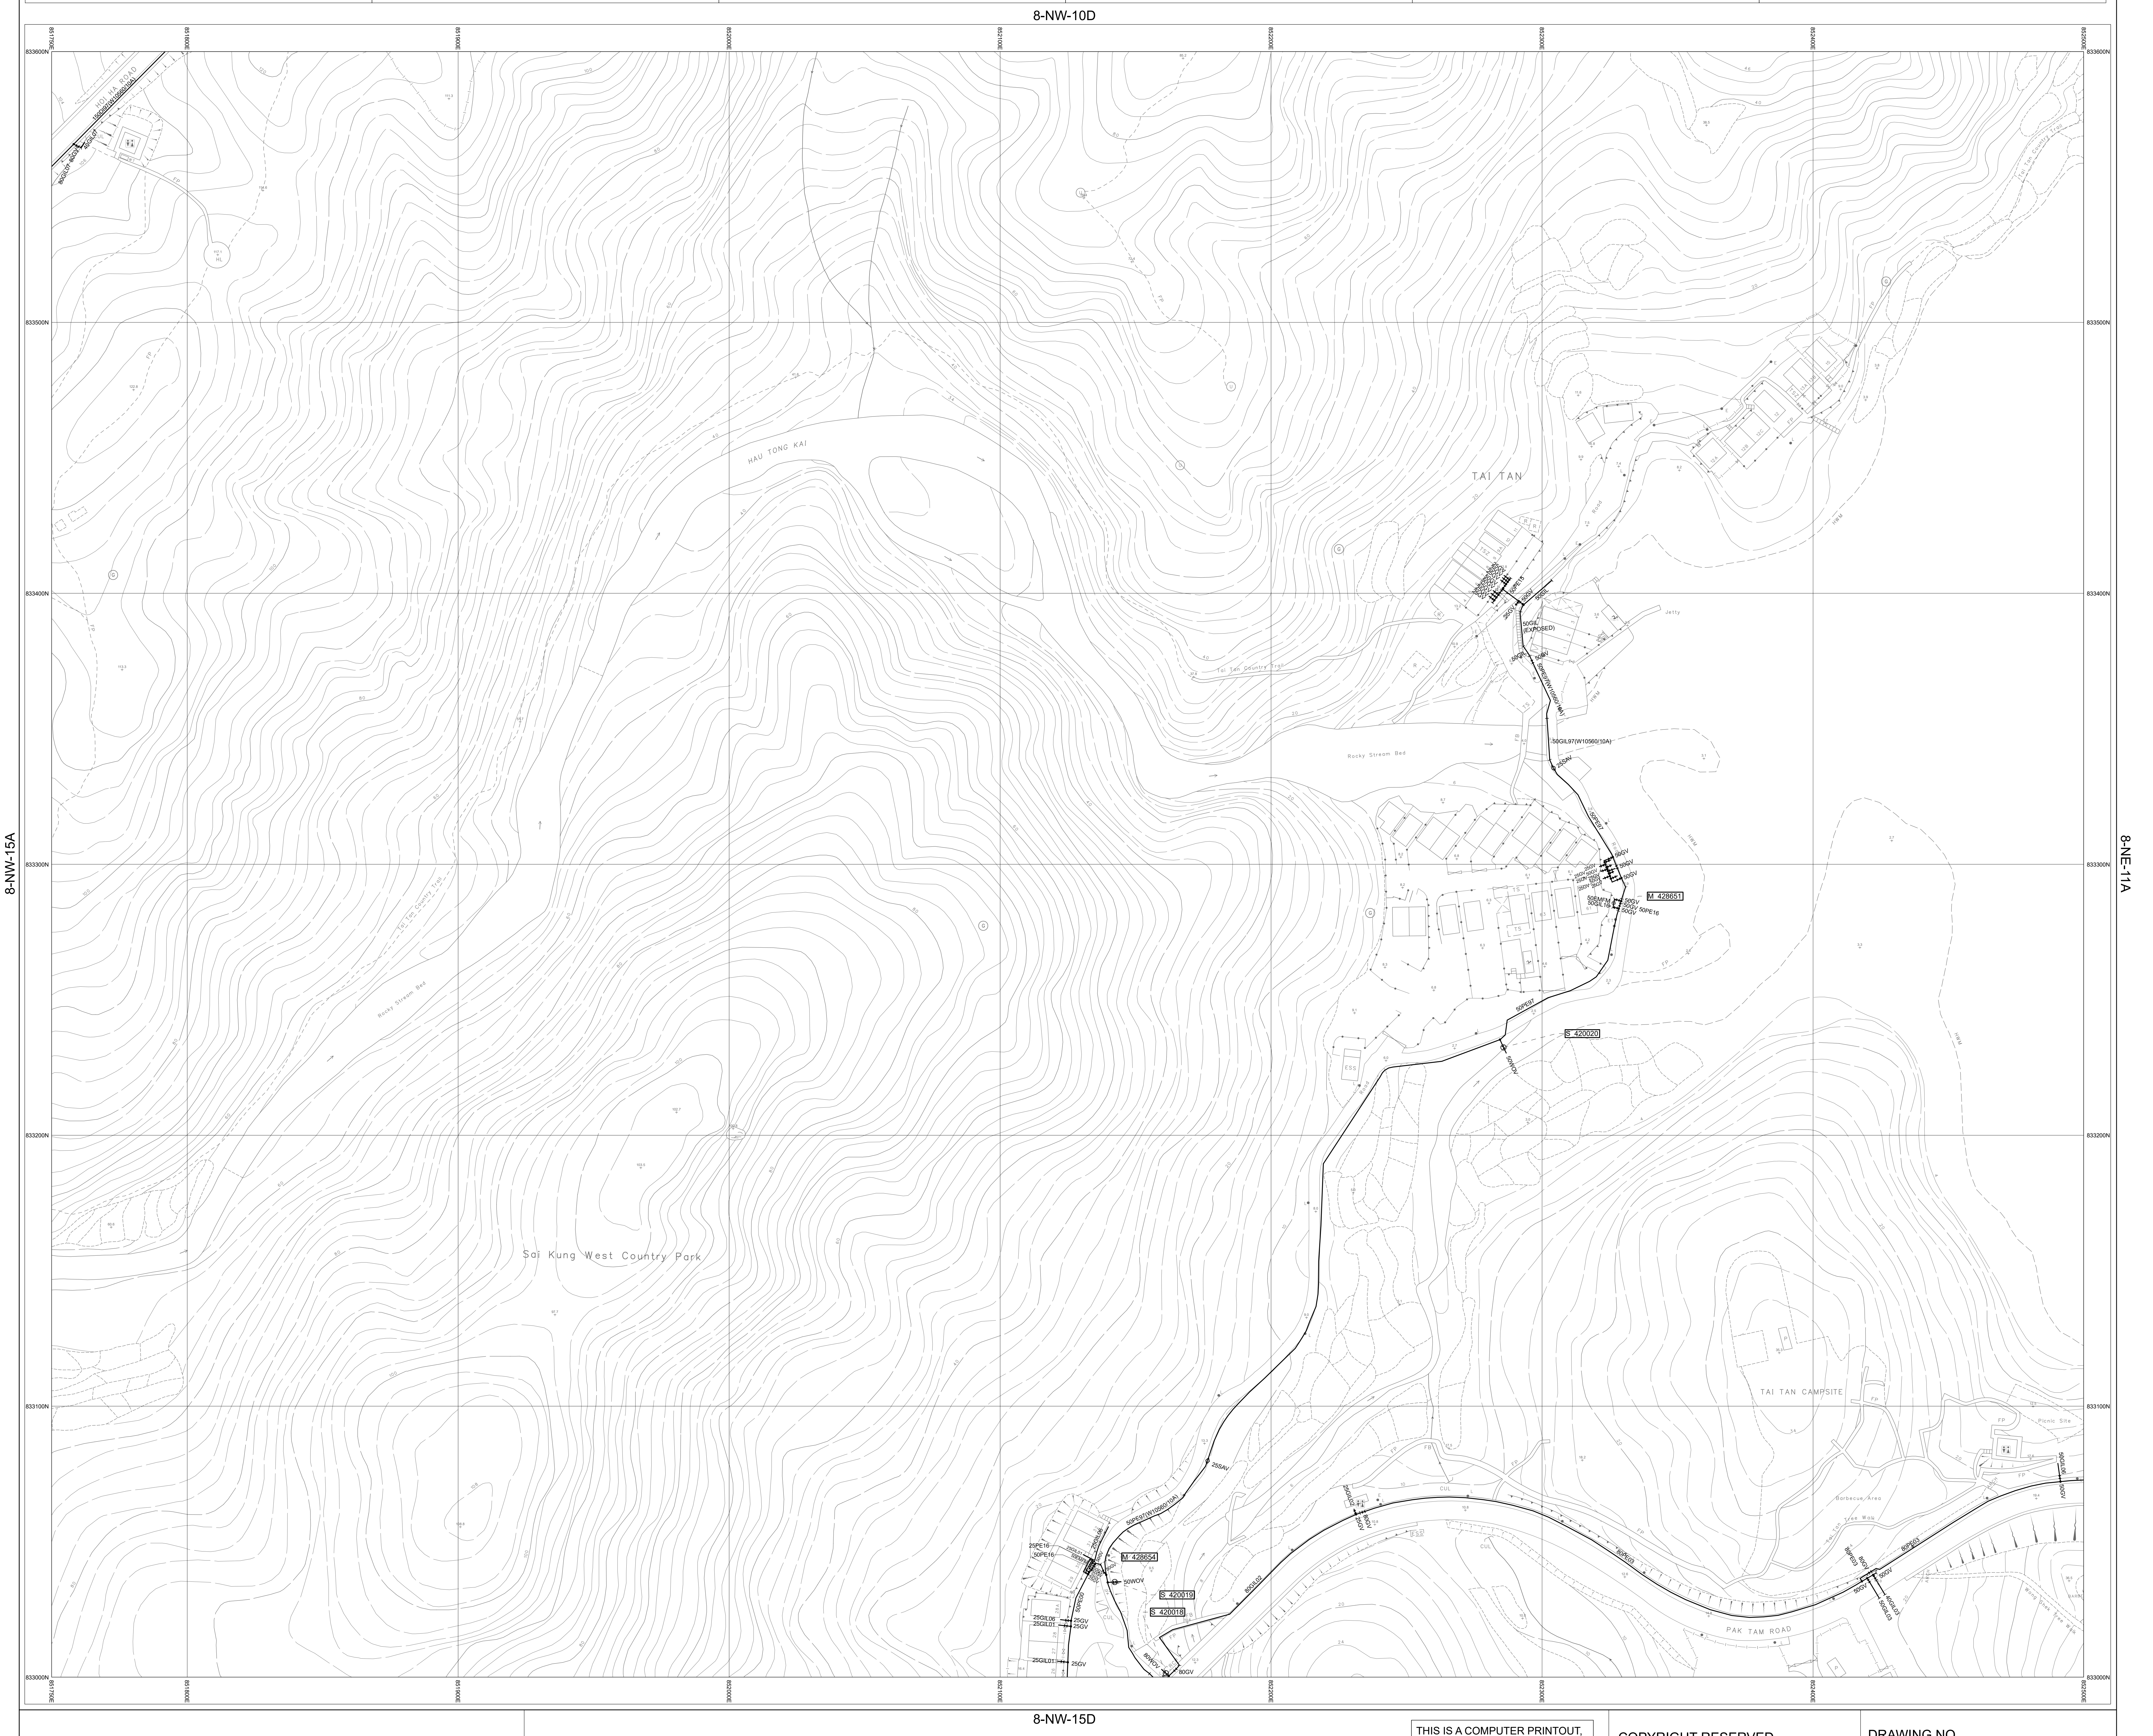
8-NW-10D
8-NW-15A
8-NE-11A
8-NW-15D
833600N
833500N
833400N
833300N
833200N
833100N
833000N
851750E
851800E
851900E
852000E
852100E
852200E
852300E
852400E
852500E
HAU TONG KAI
TAI TAN
Sai Kung West Country Park
TAI TAN CAMPSITE
PAK TAM ROAD
Jetty
Rocky Stream Bed
Tai Tan Country Trail
50PE15
50GV
50GIL
25GV
50GIL (EXPOSED)
50PE97(W10560/10A)
50GIL97(W10560/10A)
25SAV
50PE97
50EMFM
50GIL16
50PE16
M 428651
S 420020
50WOV
25PE16
50PE16
25GIL01
25GIL06
50PE00
M 428654
S 420019
S 420018
80WOV
80GV
80GIL02

NOTES:
1. FOR MAINS RECORDS SIGN CONVENTIONS AND DESIGNATIONS SEE SKETCH NO.3988.
2. DIMENSIONS OF MAINS ARE IN MILLIMETRES UNLESS OTHERWISE SPECIFIED.
3. ALL LEVELS ARE IN METRES ABOVE PRINCIPAL DATUM.

Basemap Date Updated On: 23/12/2024

SCALE 1:1 000

METRES 20 10 0 20 40 60 80 100 METRES

THIS IS A COMPUTER PRINTOUT,
NO SIGNATURE IS REQUIRED.

FRESH WATER MAINS RECORD PLAN

PAK TAM ROAD, SAI KUNG WEST COUNTRY PARK

COPYRIGHT RESERVED

DATE REVISED : 31/12/2024

SIGNED
C.H. NG
CE/MSE
DATE: 13/05/1999

DRAWING NO.
W67880/ 8-NW-15B

Water Supplies Department
HONG KONG

© The Government of the Hong Kong SAR, Map reproduced with permission of the Director of Lands