INSET 'A'	INSET 'B'	INSET 'C'	INSET 'D'	INSET 'E'	INSET 'F'

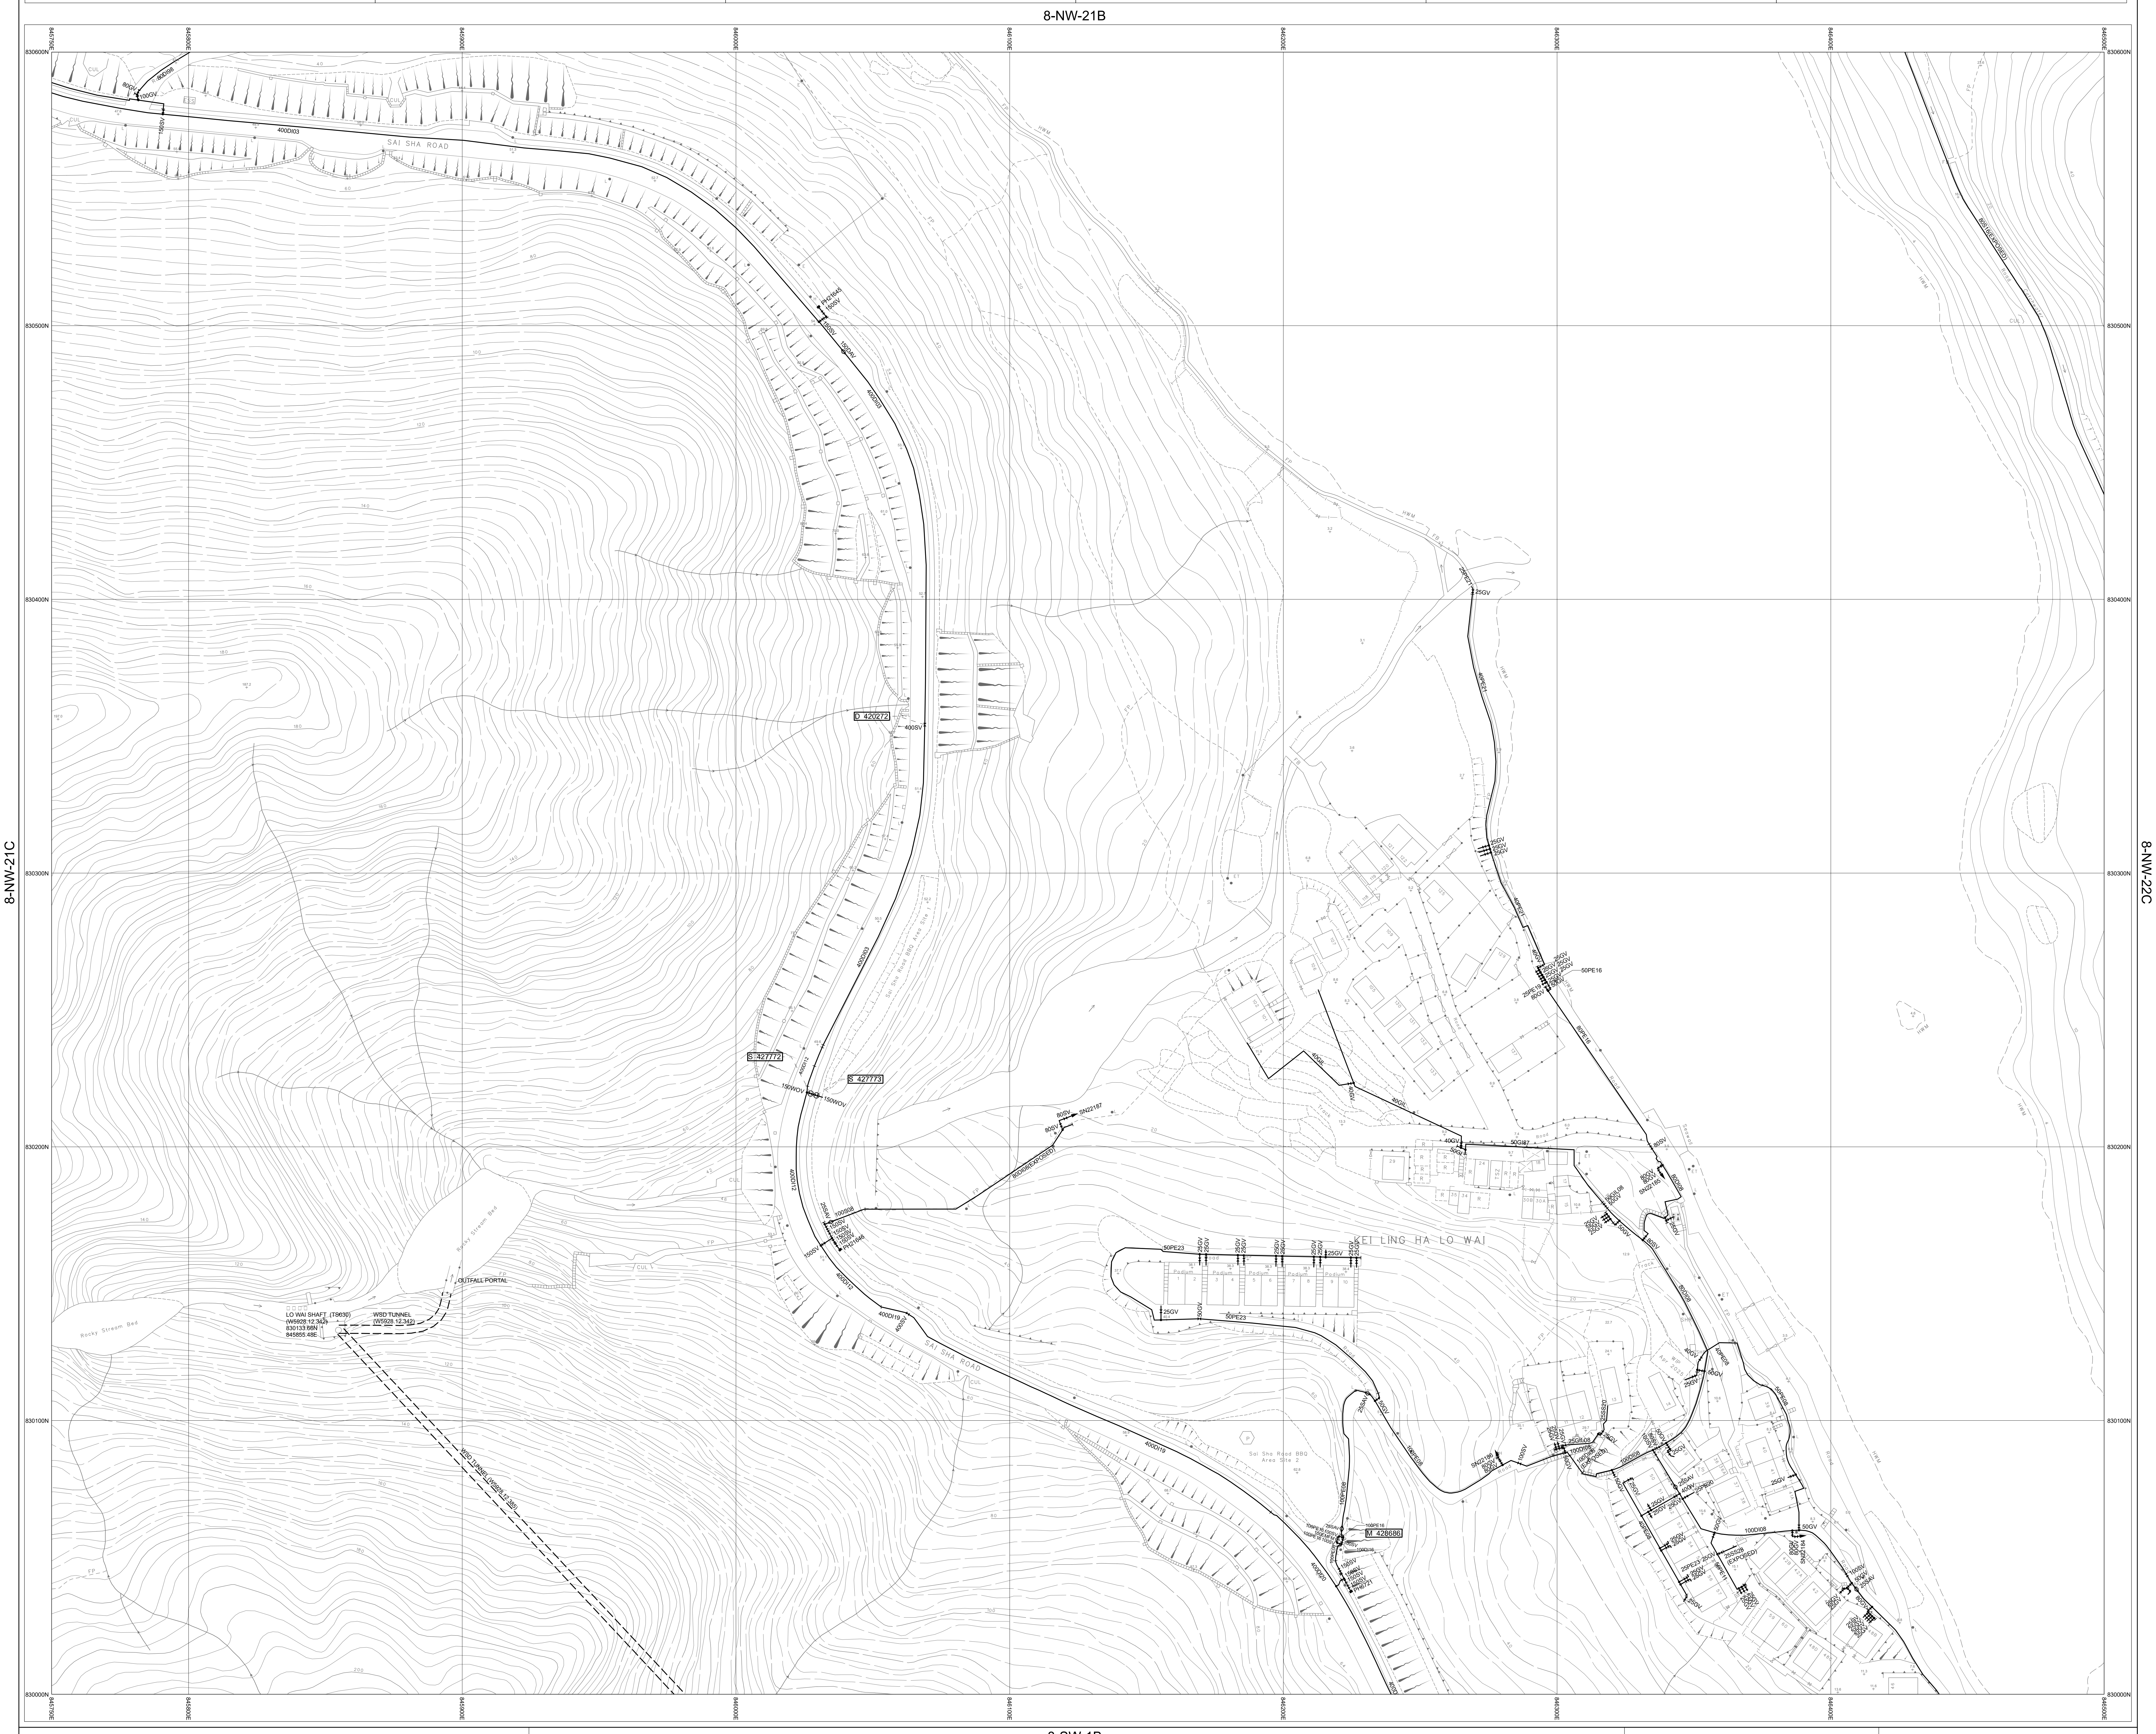
8-NW-21B
8-NW-21C
8-NW-22C
8-SW-1B
SAI SHA ROAD
KEI LING HA LO WAI
S 420272
S 427772
S 427773
M 428690
OUTFALL PORTAL
LO WAI SHAFT
WSD TUNNEL
830000N
830100N
830200N
830300N
830400N
830500N
830600N
845750E
845800E
845900E
846000E
846100E
846200E
846300E
846400E
846500E

NOTES:

1. FOR MAINS RECORDS SIGN CONVENTIONS AND DESIGNATIONS SEE SKETCH NO.3988.
2. DIMENSIONS OF MAINS ARE IN MILLIMETRES UNLESS OTHERWISE SPECIFIED.
3. ALL LEVELS ARE IN METRES ABOVE PRINCIPAL DATUM.

Basemap Date Updated On: 05/01/2026

SCALE 1:1 000

METRES 20 10 0 20 40 60 80 100 METRES

FRESH WATER MAINS RECORD PLAN

KEI LING HA LO WAI

THIS IS A COMPUTER PRINTOUT,
NO SIGNATURE IS REQUIRED.

COPYRIGHT RESERVED

DATE REVISED : 02/03/2026

SIGNED C.H. NG
CE/MSE
DATE: 13/05/1999

DRAWING NO.
W67880/ 8-NW-21D

Water Supplies Department
HONG KONG

© The Government of the Hong Kong SAR, Map reproduced with permission of the Director of Lands