INSET 'A'	INSET 'B'	INSET 'C'	INSET 'D'	INSET 'E'	INSET 'F'

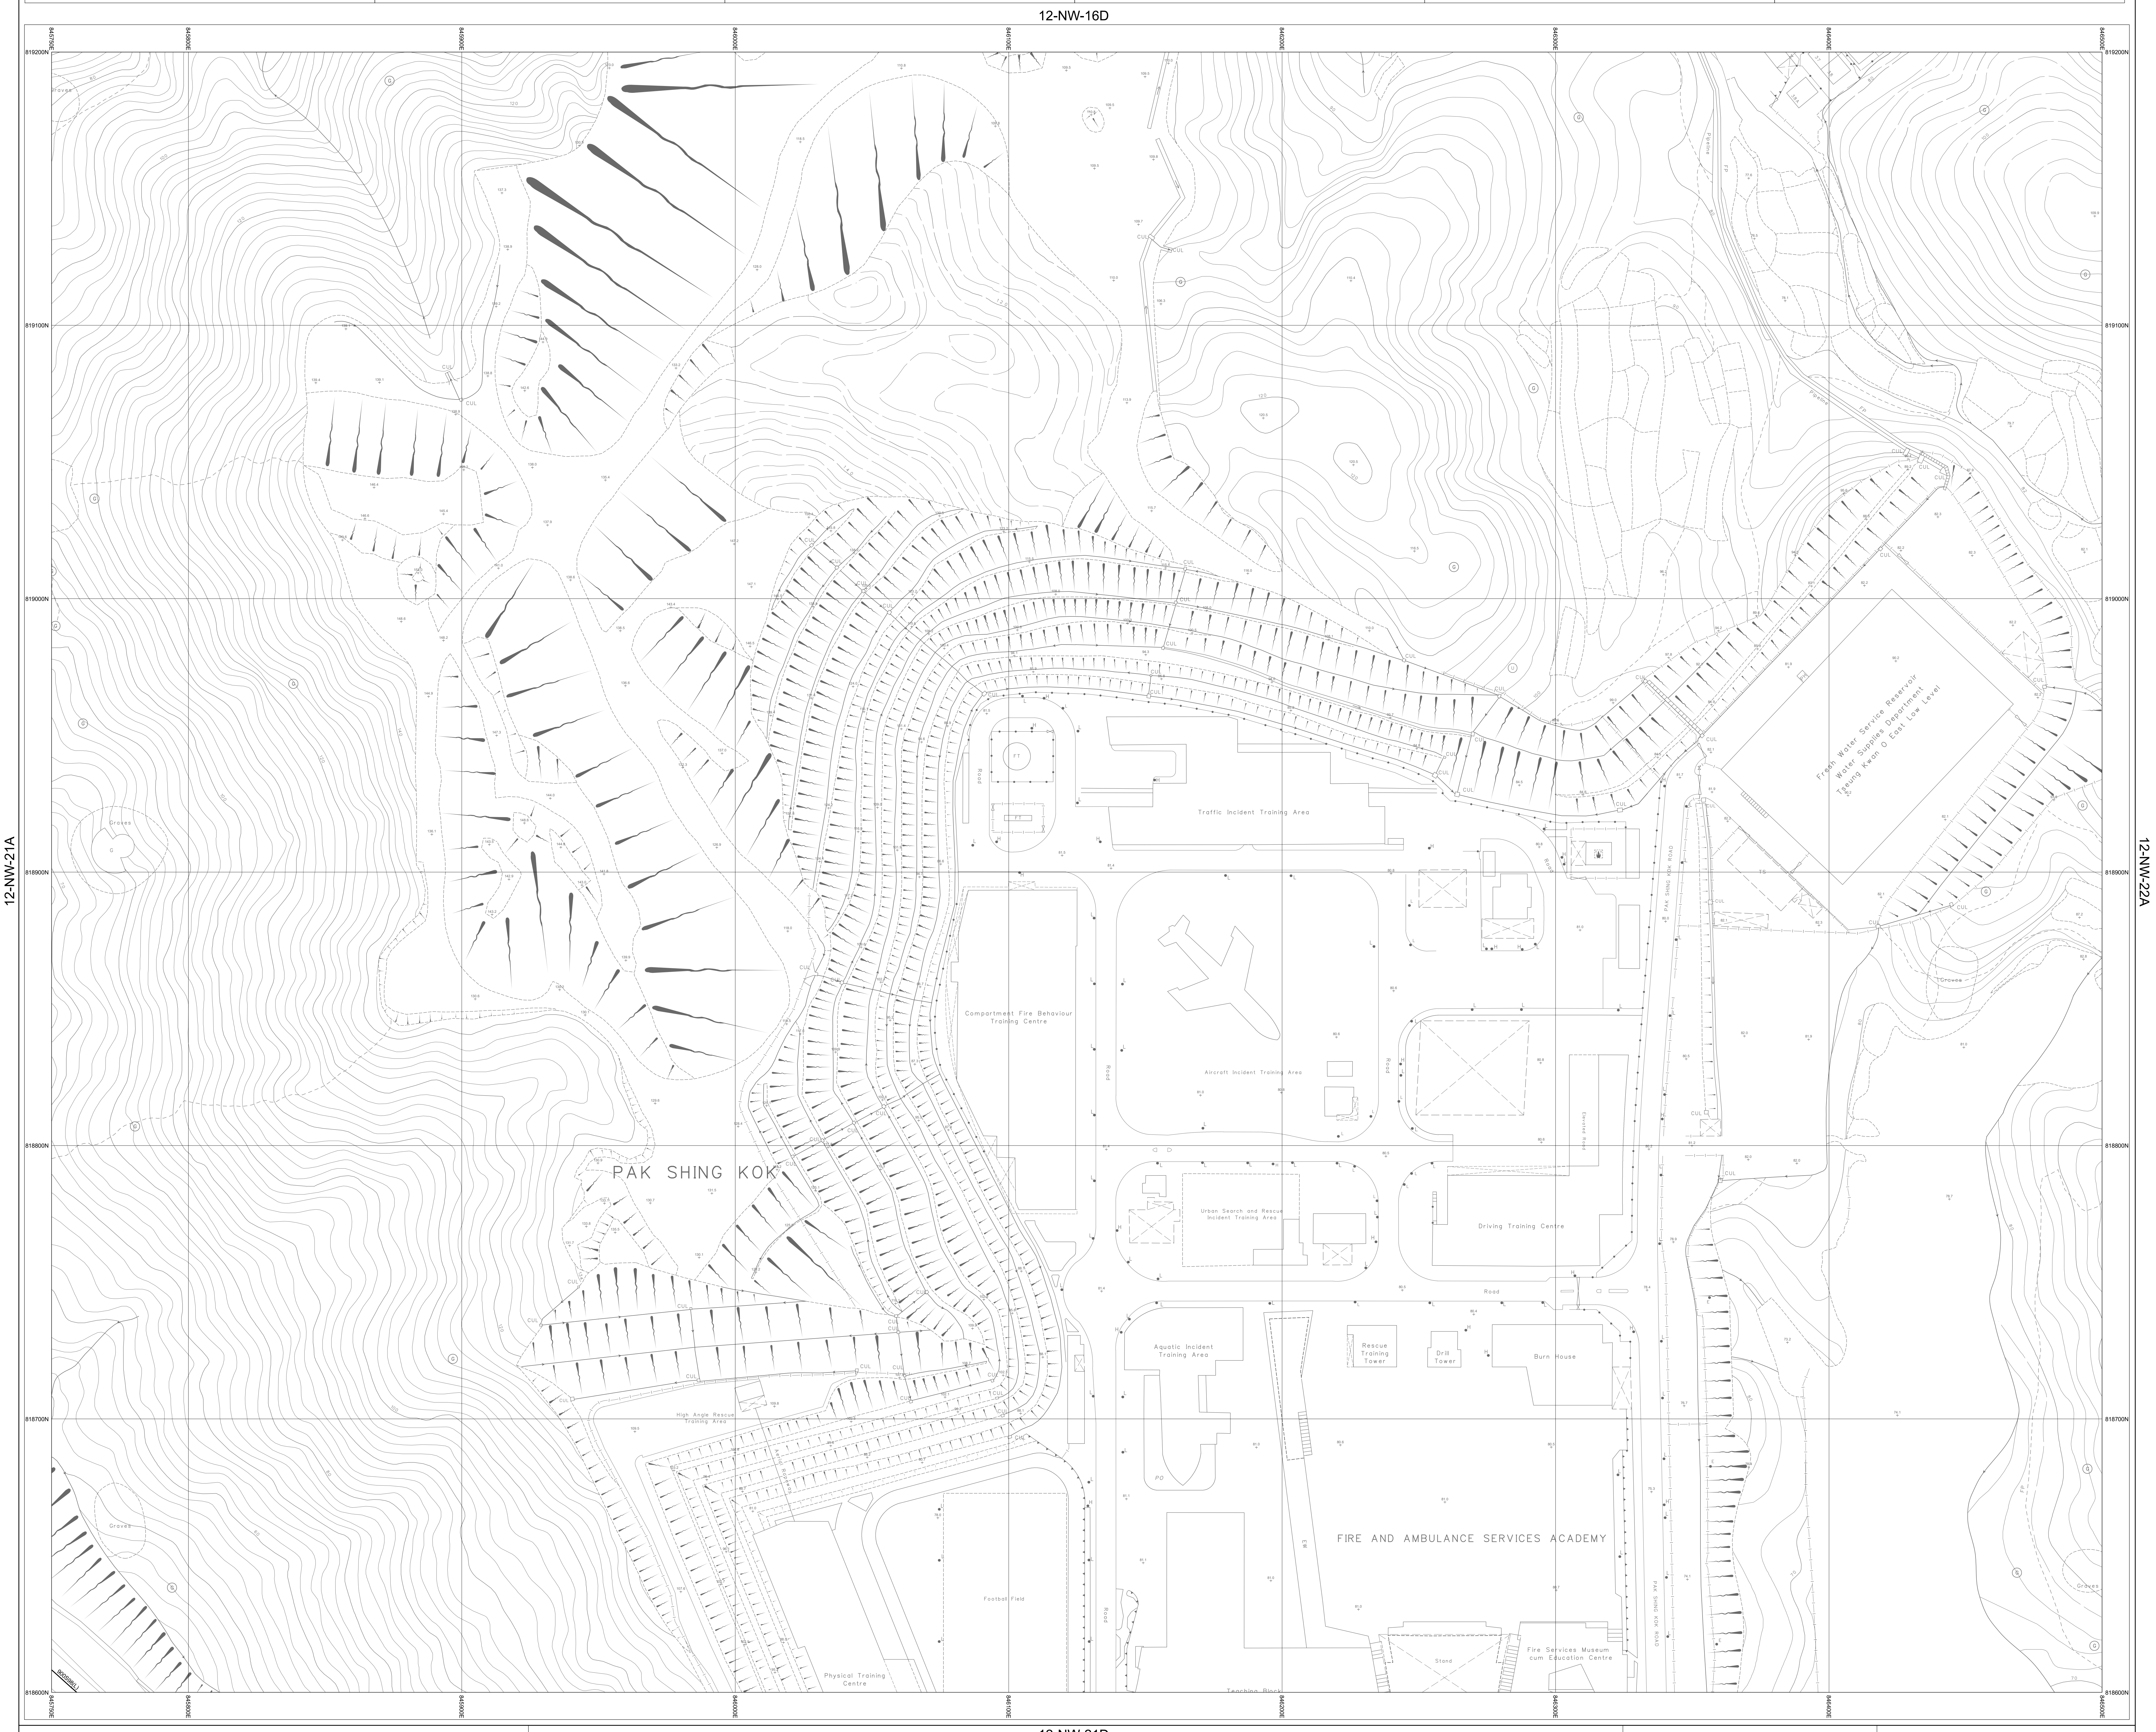
12-NW-16D
12-NW-21A
12-NW-22A
PAK SHING KOK
Traffic Incident Training Area
Fresh Water Service Reservoir
Water Supplies Department
Tseung Kwan O East Low Level
Compartment Fire Behaviour Training Centre
Aircraft Incident Training Area
Urban Search and Rescue Incident Training Area
Driving Training Centre
Aquatic Incident Training Area
Rescue Training Tower
Drill Tower
Burn House
High Angle Rescue Training Area
FIRE AND AMBULANCE SERVICES ACADEMY
Football Field
Physical Training Centre
Stand
Fire Services Museum cum Education Centre
Teaching Block
PAK SHING KOK ROAD
Elevated Road
Road
Graves
CUL

12-NW-21D

NOTES:

1. FOR MAINS RECORDS SIGN CONVENTIONS AND DESIGNATIONS SEE SKETCH NO.3988.
2. DIMENSIONS OF MAINS ARE IN MILLIMETRES UNLESS OTHERWISE SPECIFIED.
3. ALL LEVELS ARE IN METRES ABOVE PRINCIPAL DATUM.

Basemap Date Updated On: 23/12/2024

SCALE 1:1 000

METRES 20 10 0 20 40 60 80 100 METRES

THIS IS A COMPUTER PRINTOUT,
NO SIGNATURE IS REQUIRED.

SALT WATER MAINS RECORD PLAN

PAK SHIN KOK,SAI KUNG

COPYRIGHT RESERVED

DATE REVISED : 30/12/2024

SIGNED
C.H. NG
CE/MSE
DATE: 10/06/1999

DRAWING NO.

W67881/ 12-NW-21B

Water Supplies Department
HONG KONG

© The Government of the Hong Kong SAR, Map reproduced with permission of the Director of Lands