
INSET 'A'	INSET 'B'	INSET 'C'	INSET 'D'	INSET 'E'	INSET 'F'

12-SW-6B

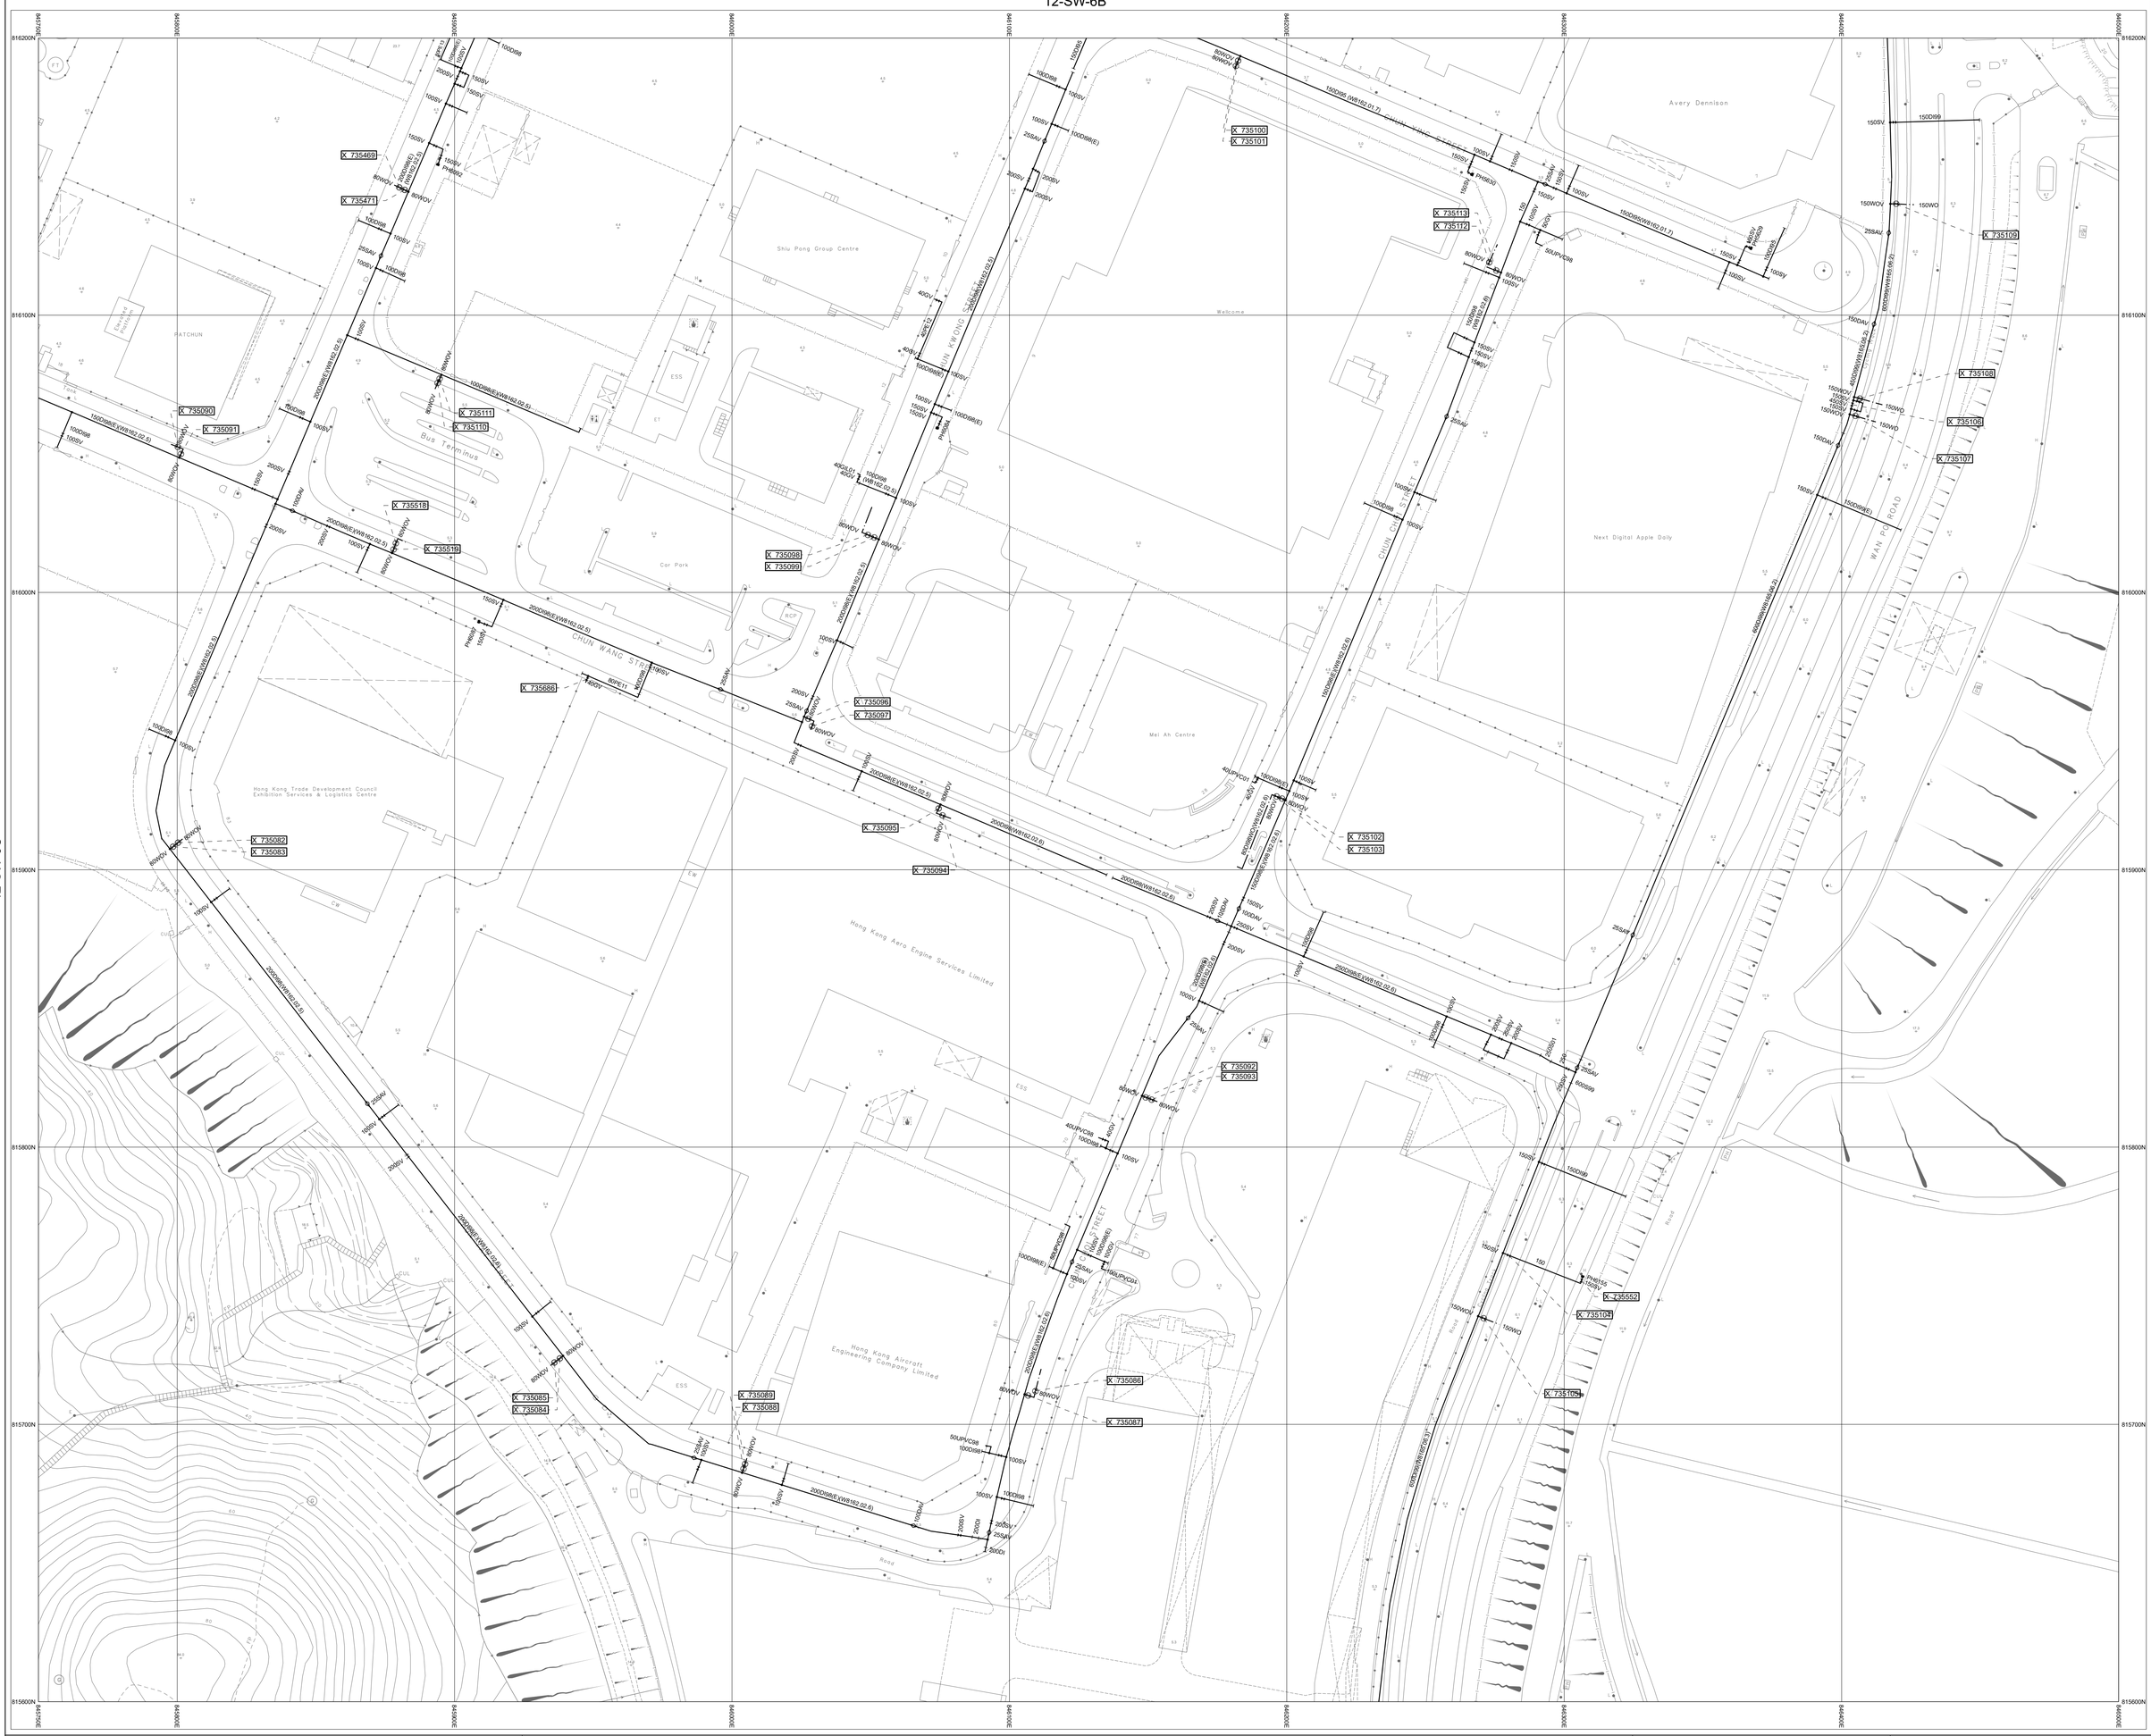

NOTES:

1. FOR MAINS RECORDS SIGN CONVENTIONS AND DESIGNATIONS SEE SKETCH NO.3988.
2. DIMENSIONS OF MAINS ARE IN MILLIMETRES UNLESS OTHERWISE SPECIFIED.
3. ALL LEVELS ARE IN METRES ABOVE PRINCIPAL DATUM.

Basemap Date Updated On: 23/12/2024

SCALE 1:1 000

METRES 20 10 0 20 40 60 80 100 METRES

SALT WATER MAINS RECORD PLAN

TSEUNG KWAN O

THIS IS A COMPUTER PRINTOUT, NO SIGNATURE IS REQUIRED.

COPYRIGHT RESERVED

DATE REVISED : 30/12/2024

SIGNED
C.H. NG
CE/MSE
DATE: 10/06/1999

DRAWING NO.

W67881/ 12-SW-6D

Water Supplies Department
HONG KONG

© The Government of the Hong Kong SAR, Map reproduced with permission of the Director of Lands