INSET 'A'	INSET 'B'	INSET 'C'	INSET 'D'	INSET 'E'	INSET 'F'

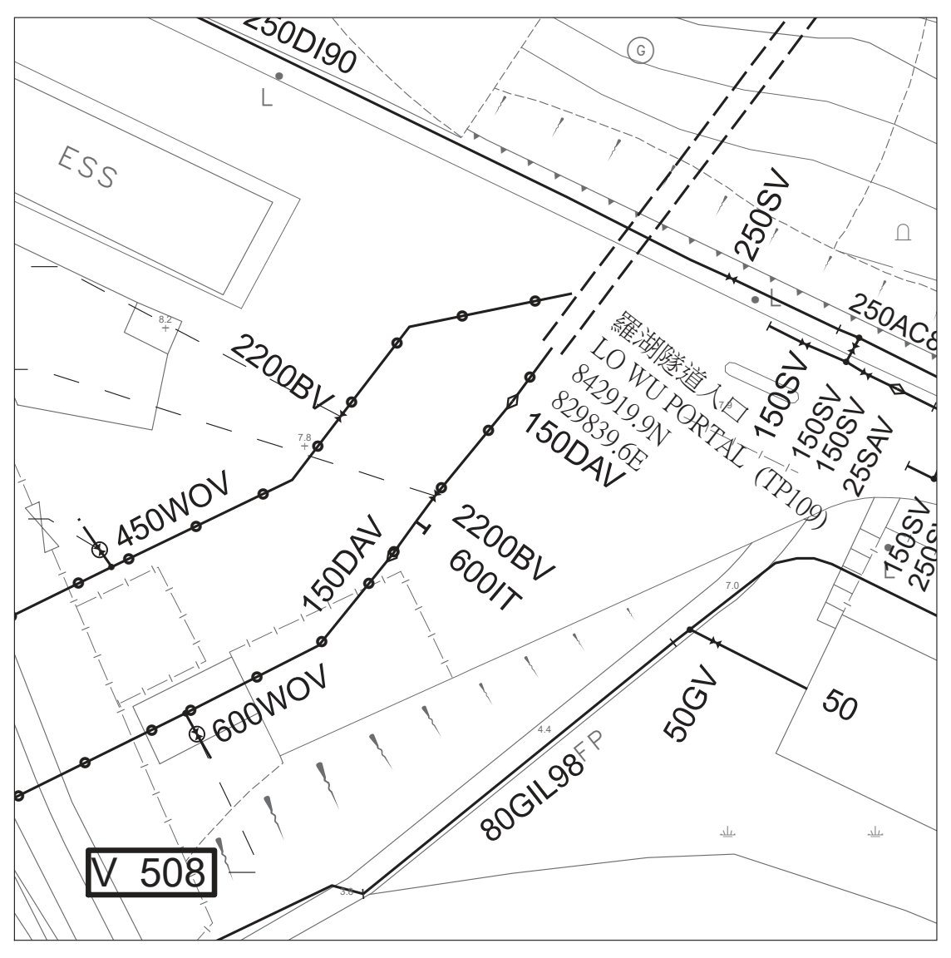
250DI90
ESS
250SV
250AC8
2200BV
羅湖隧道入口
LO WU PORTAL (TP109)
842919.9N
829839.6E
150DAV
150SV
150SV
150SV
25SAV
450WOV
150DAV
2200BV
600IT
150SV
600WOV
50GV
50
80GIL98
FP
V 508

Scale 1:500

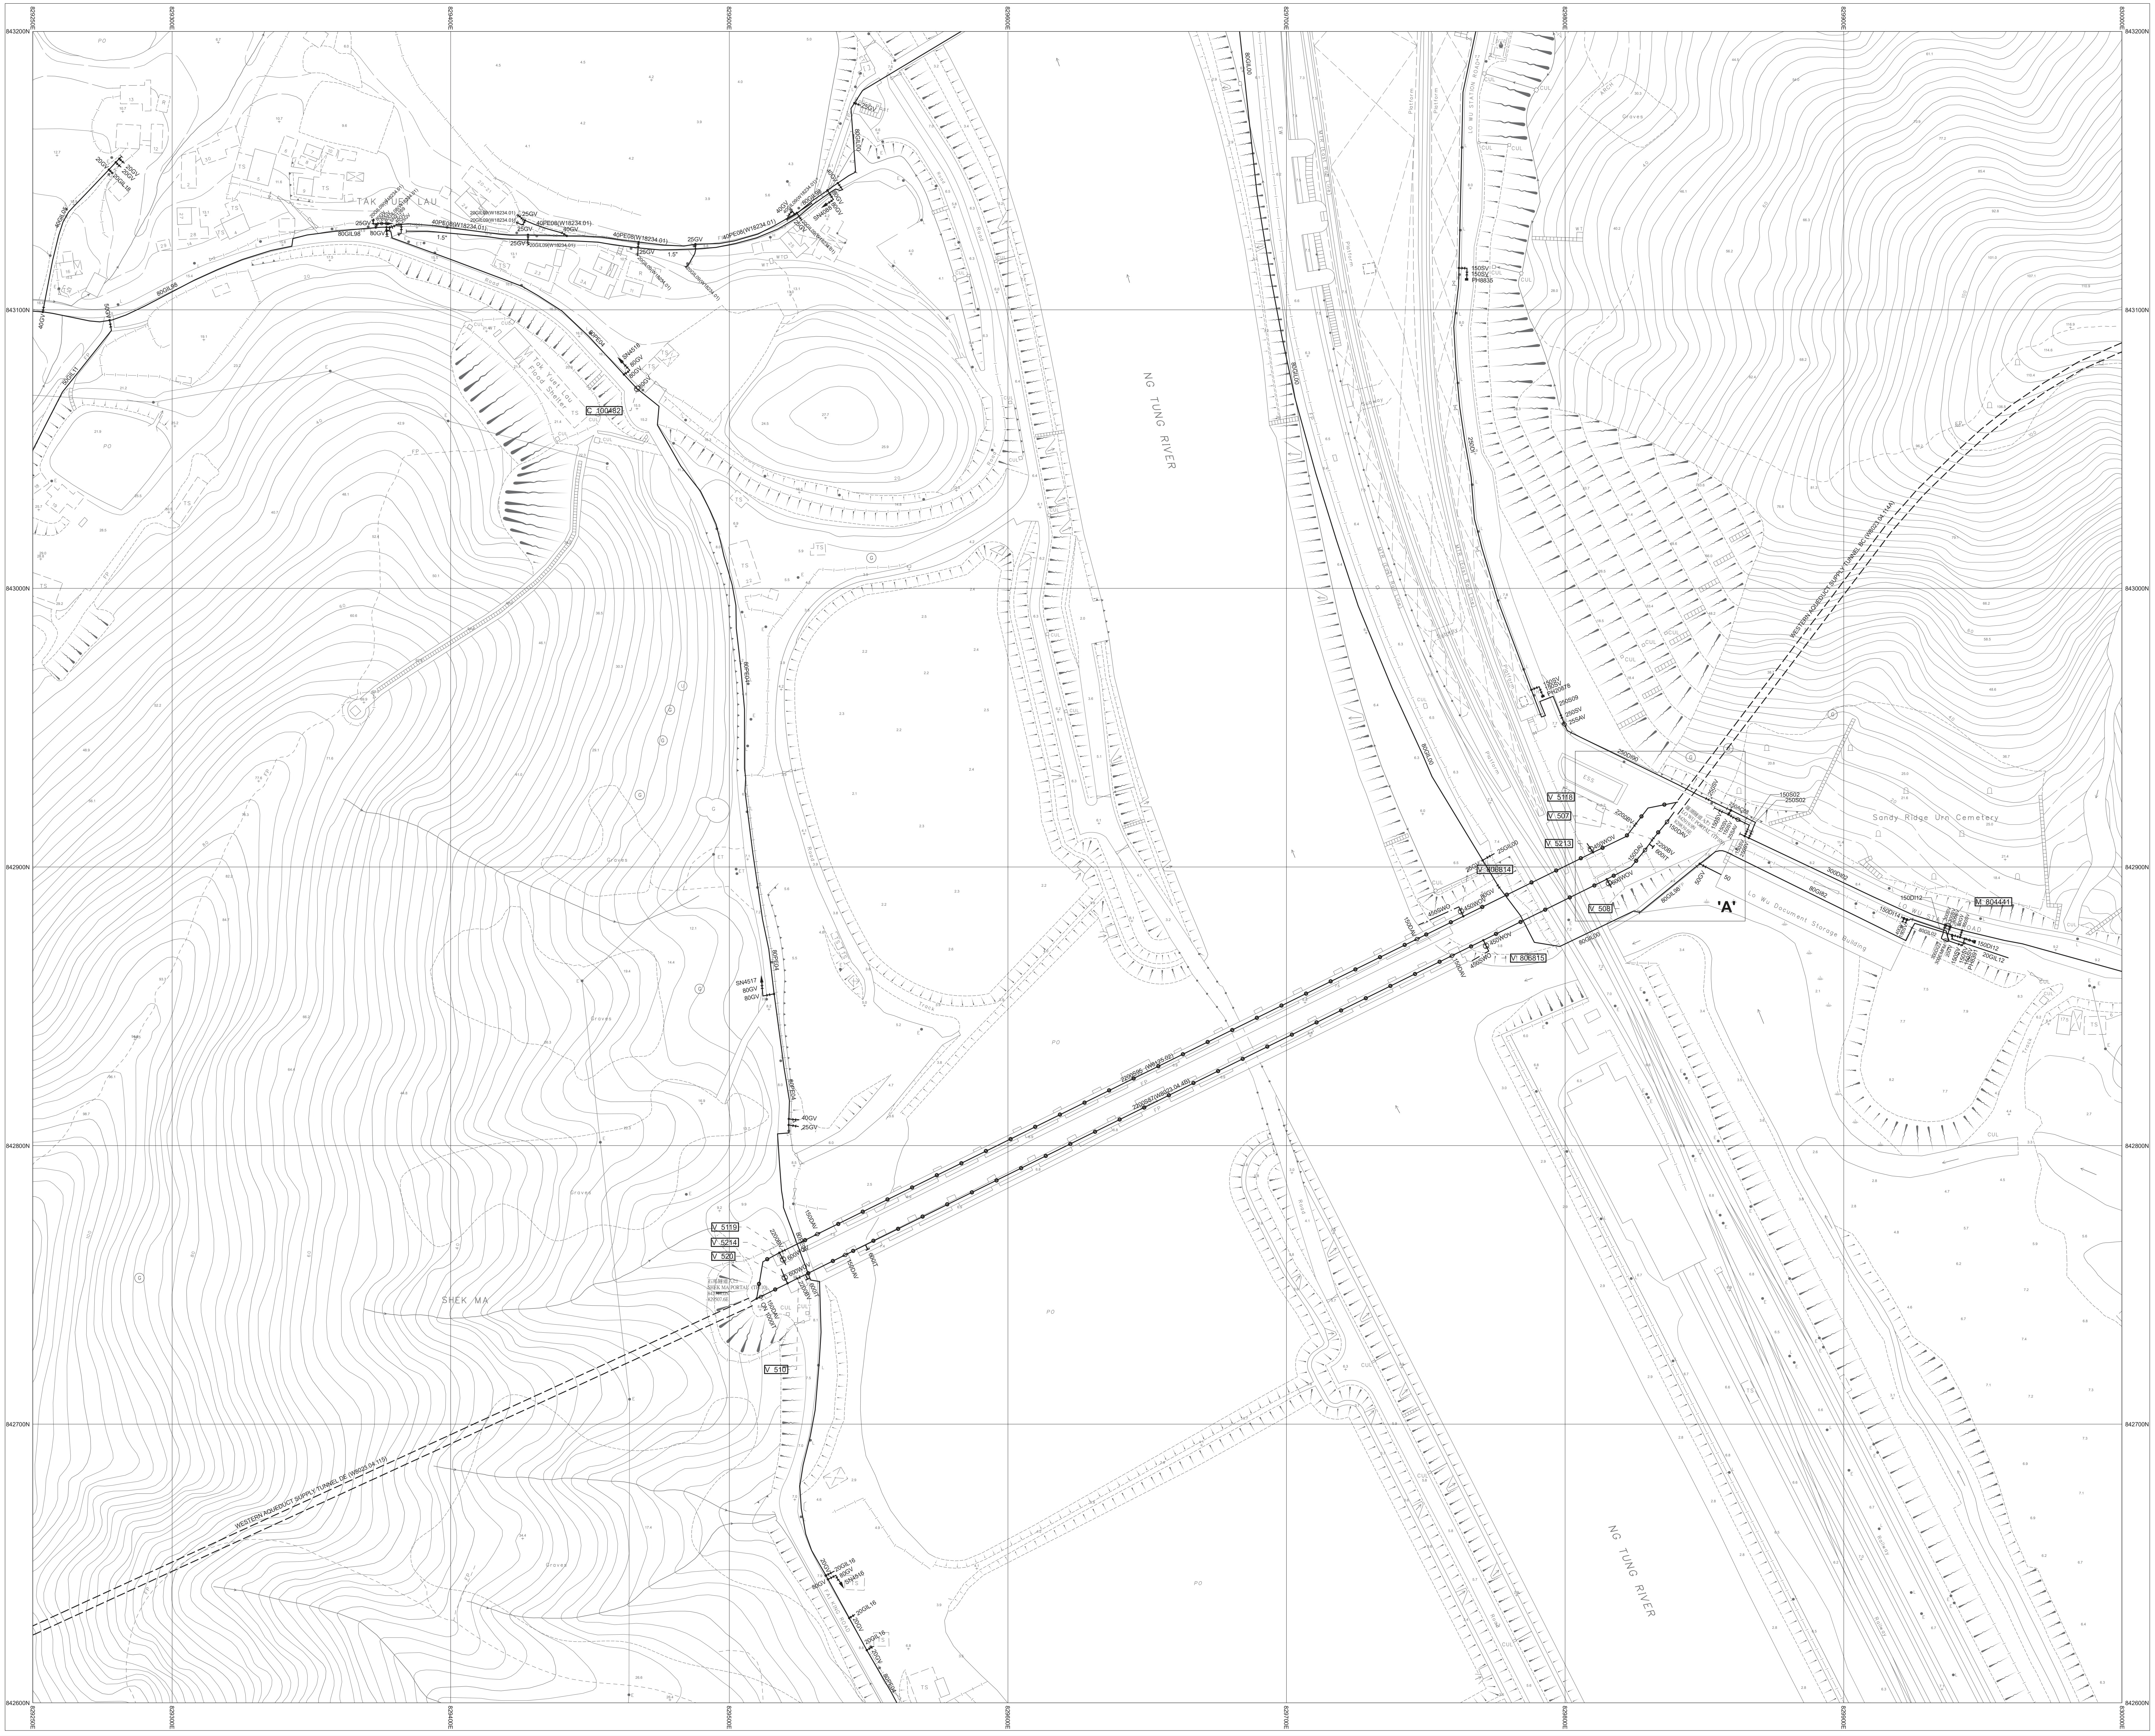
2-NE-20D
2-NE-25A
3-NW-21A
2-NE-25D
843200N
843100N
843000N
842900N
842800N
842700N
842600N
829250E
829300E
829400E
829500E
829600E
829700E
829800E
829900E
830000E
NG TUNG RIVER
NG TUNG RIVER
SHEK MA
Sandy Ridge Urn Cemetery
'A'
V 508
V 537

NOTES:

1. FOR MAINS RECORDS SIGN CONVENTIONS AND DESIGNATIONS SEE SKETCH NO.3988.
2. DIMENSIONS OF MAINS ARE IN MILLIMETRES UNLESS OTHERWISE SPECIFIED.
3. ALL LEVELS ARE IN METRES ABOVE PRINCIPAL DATUM.

Basemap Date Updated On: 30/04/2019

SCALE 1:1 000

METRES 20 10 0 20 40 60 80 100 METRES

THIS IS A COMPUTER PRINTOUT,
NO SIGNATURE IS REQUIRED.

FRESH WATER MAINS RECORD PLAN

TUNNEL PORTAL 'D', LO WU

COPYRIGHT RESERVED

DATE REVISED : 02/05/2024

DRAWING NO.
W67880/ 2-NE-25B

SIGNED C.S. CHIN
CE/MNE
DATE: 24/12/1998

Water Supplies Department
HONG KONG

© The Government of the Hong Kong SAR, Map reproduced with permission of the Director of Lands