INSET 'A'	INSET 'B'	INSET 'C'	INSET 'D'	INSET 'E'	INSET 'F'

2-SE-9B

2-SE-9C

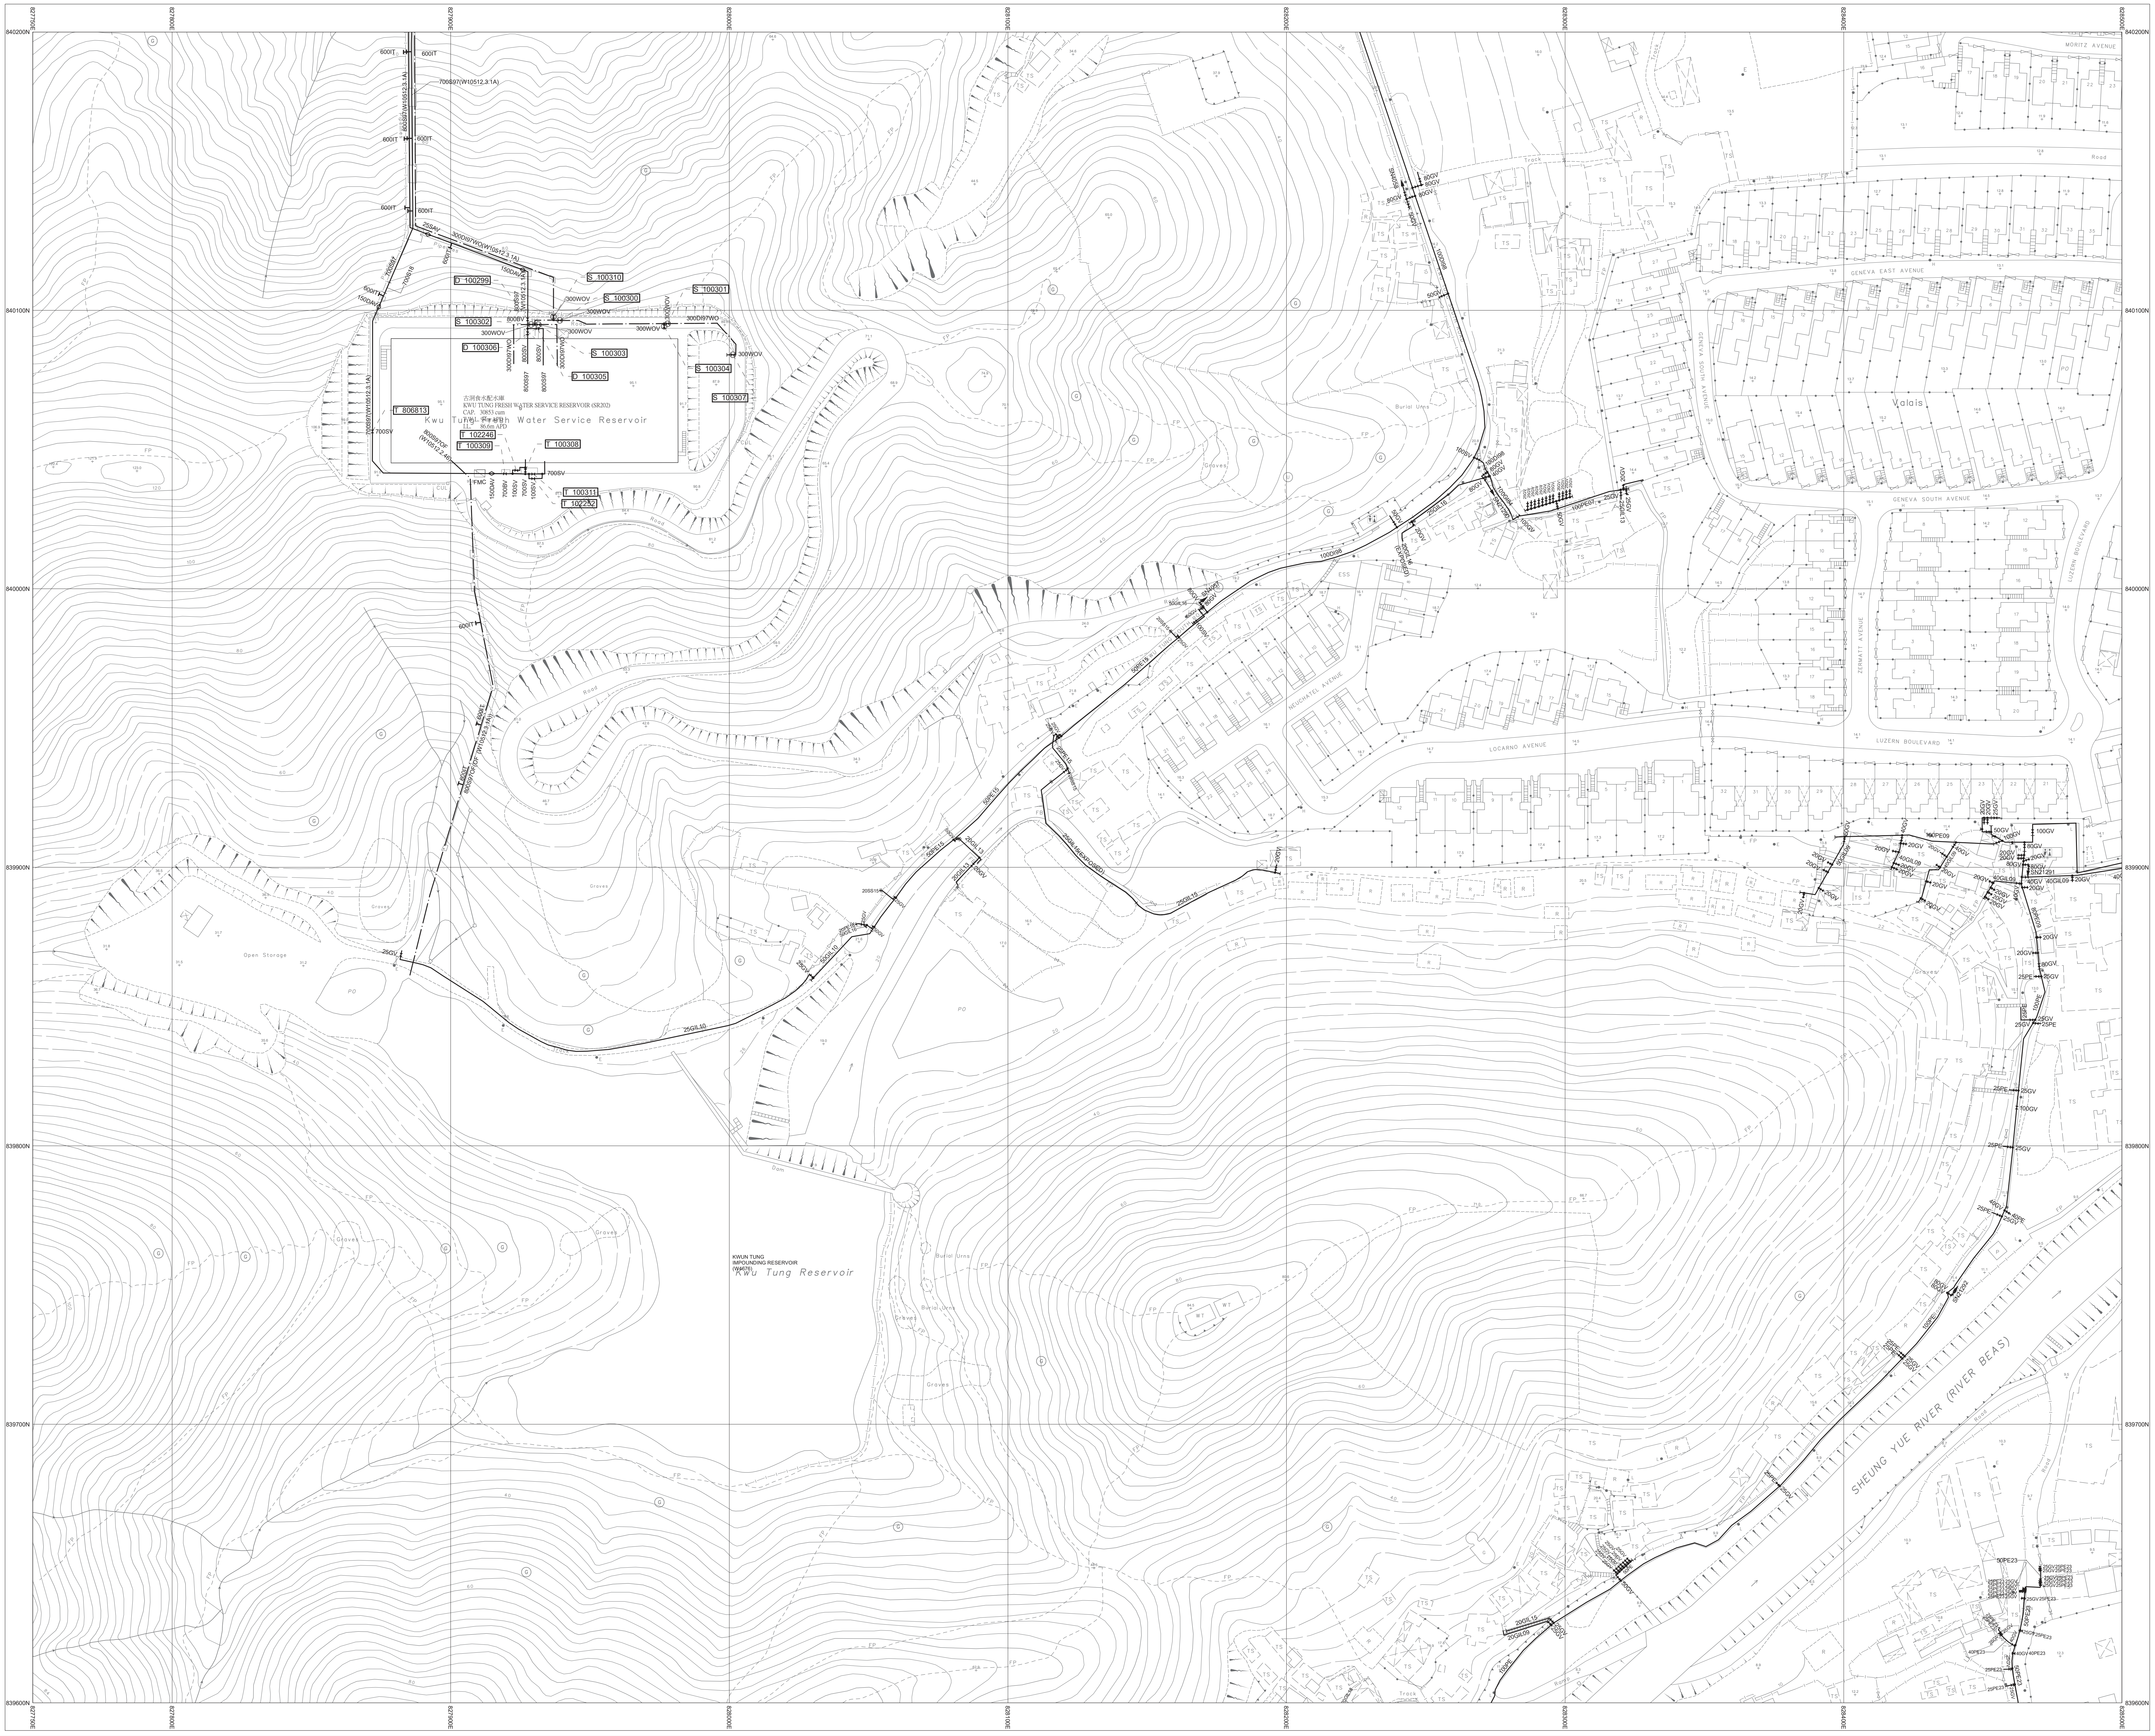
Kwu Tung Fresh Water Service Reservoir
Kwu Tung Reservoir
Valais
SHEUNG YUE RIVER (RIVER BEAS)

2-SE-10C

2-SE-14B

NOTES:
1. FOR MAINS RECORDS SIGN CONVENTIONS AND DESIGNATIONS SEE SKETCH NO.3988.
2. DIMENSIONS OF MAINS ARE IN MILLIMETRES UNLESS OTHERWISE SPECIFIED.
3. ALL LEVELS ARE IN METRES ABOVE PRINCIPAL DATUM.

Basemap Date Updated On: 11/04/2023

SCALE 1:1 000

METRES 20 10 0 20 40 60 80 100 METRES

THIS IS A COMPUTER PRINTOUT,
NO SIGNATURE IS REQUIRED.

FRESH WATER MAINS RECORD PLAN

SHEUNG YUE HO, KWU TUNG

COPYRIGHT RESERVED

DATE REVISED : 01/08/2024

SIGNED C.S. CHIN
CE/MNE
DATE: 24/12/1998

DRAWING NO.
W67880/ 2-SE-9D

Water Supplies Department
HONG KONG

© The Government of the Hong Kong SAR, Map reproduced with permission of the Director of Lands