INSET 'A'

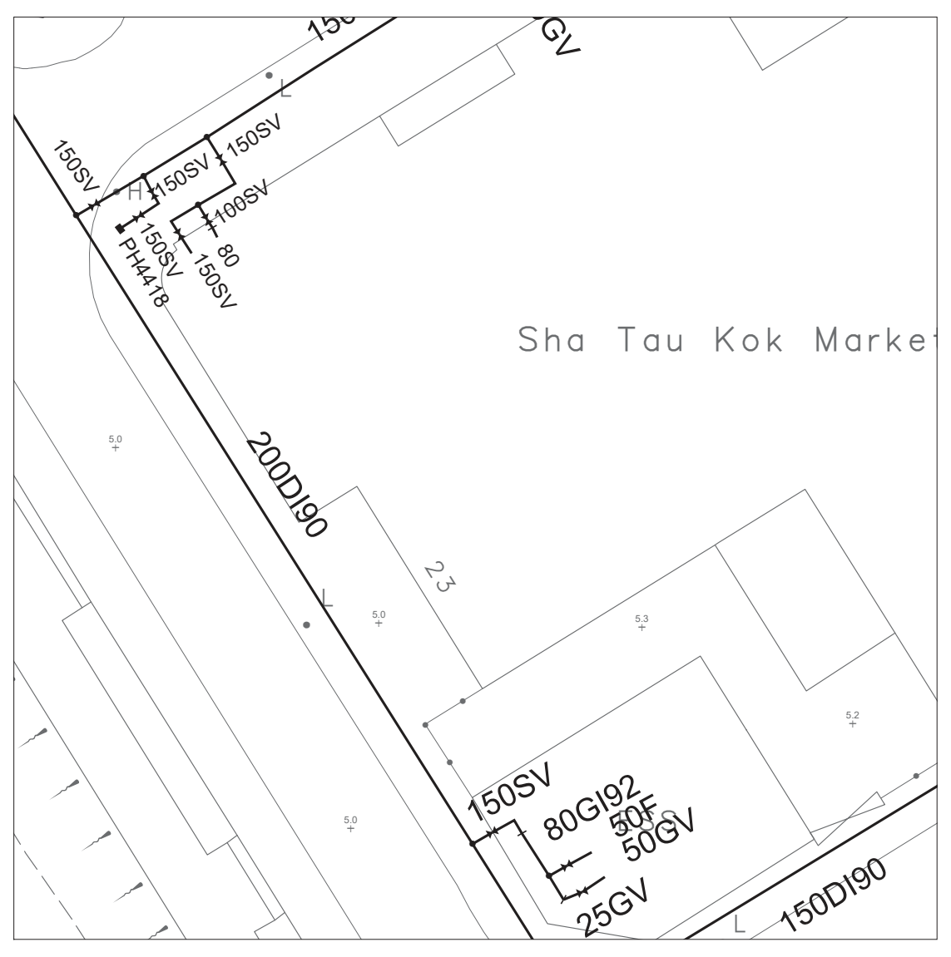

Scale 1:500

INSET 'B'

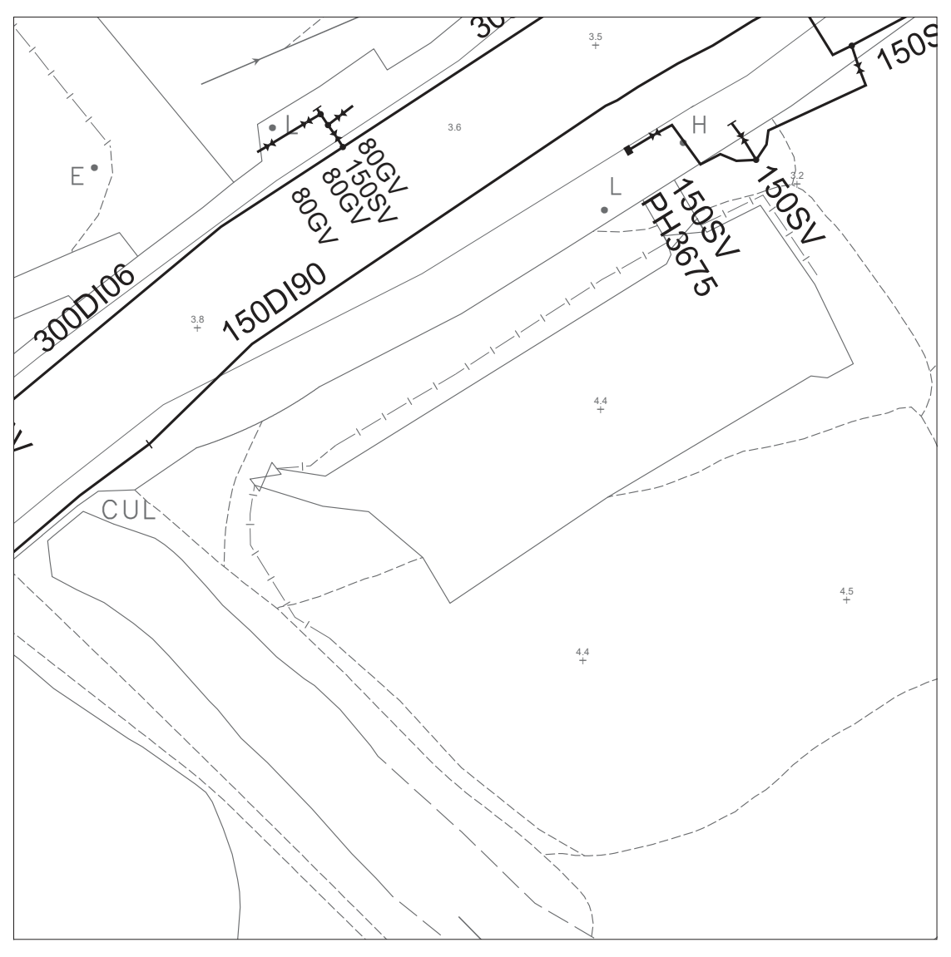

Scale 1:500

INSET 'C'

INSET 'D'

INSET 'E'

INSET 'F'

3-NE-13A

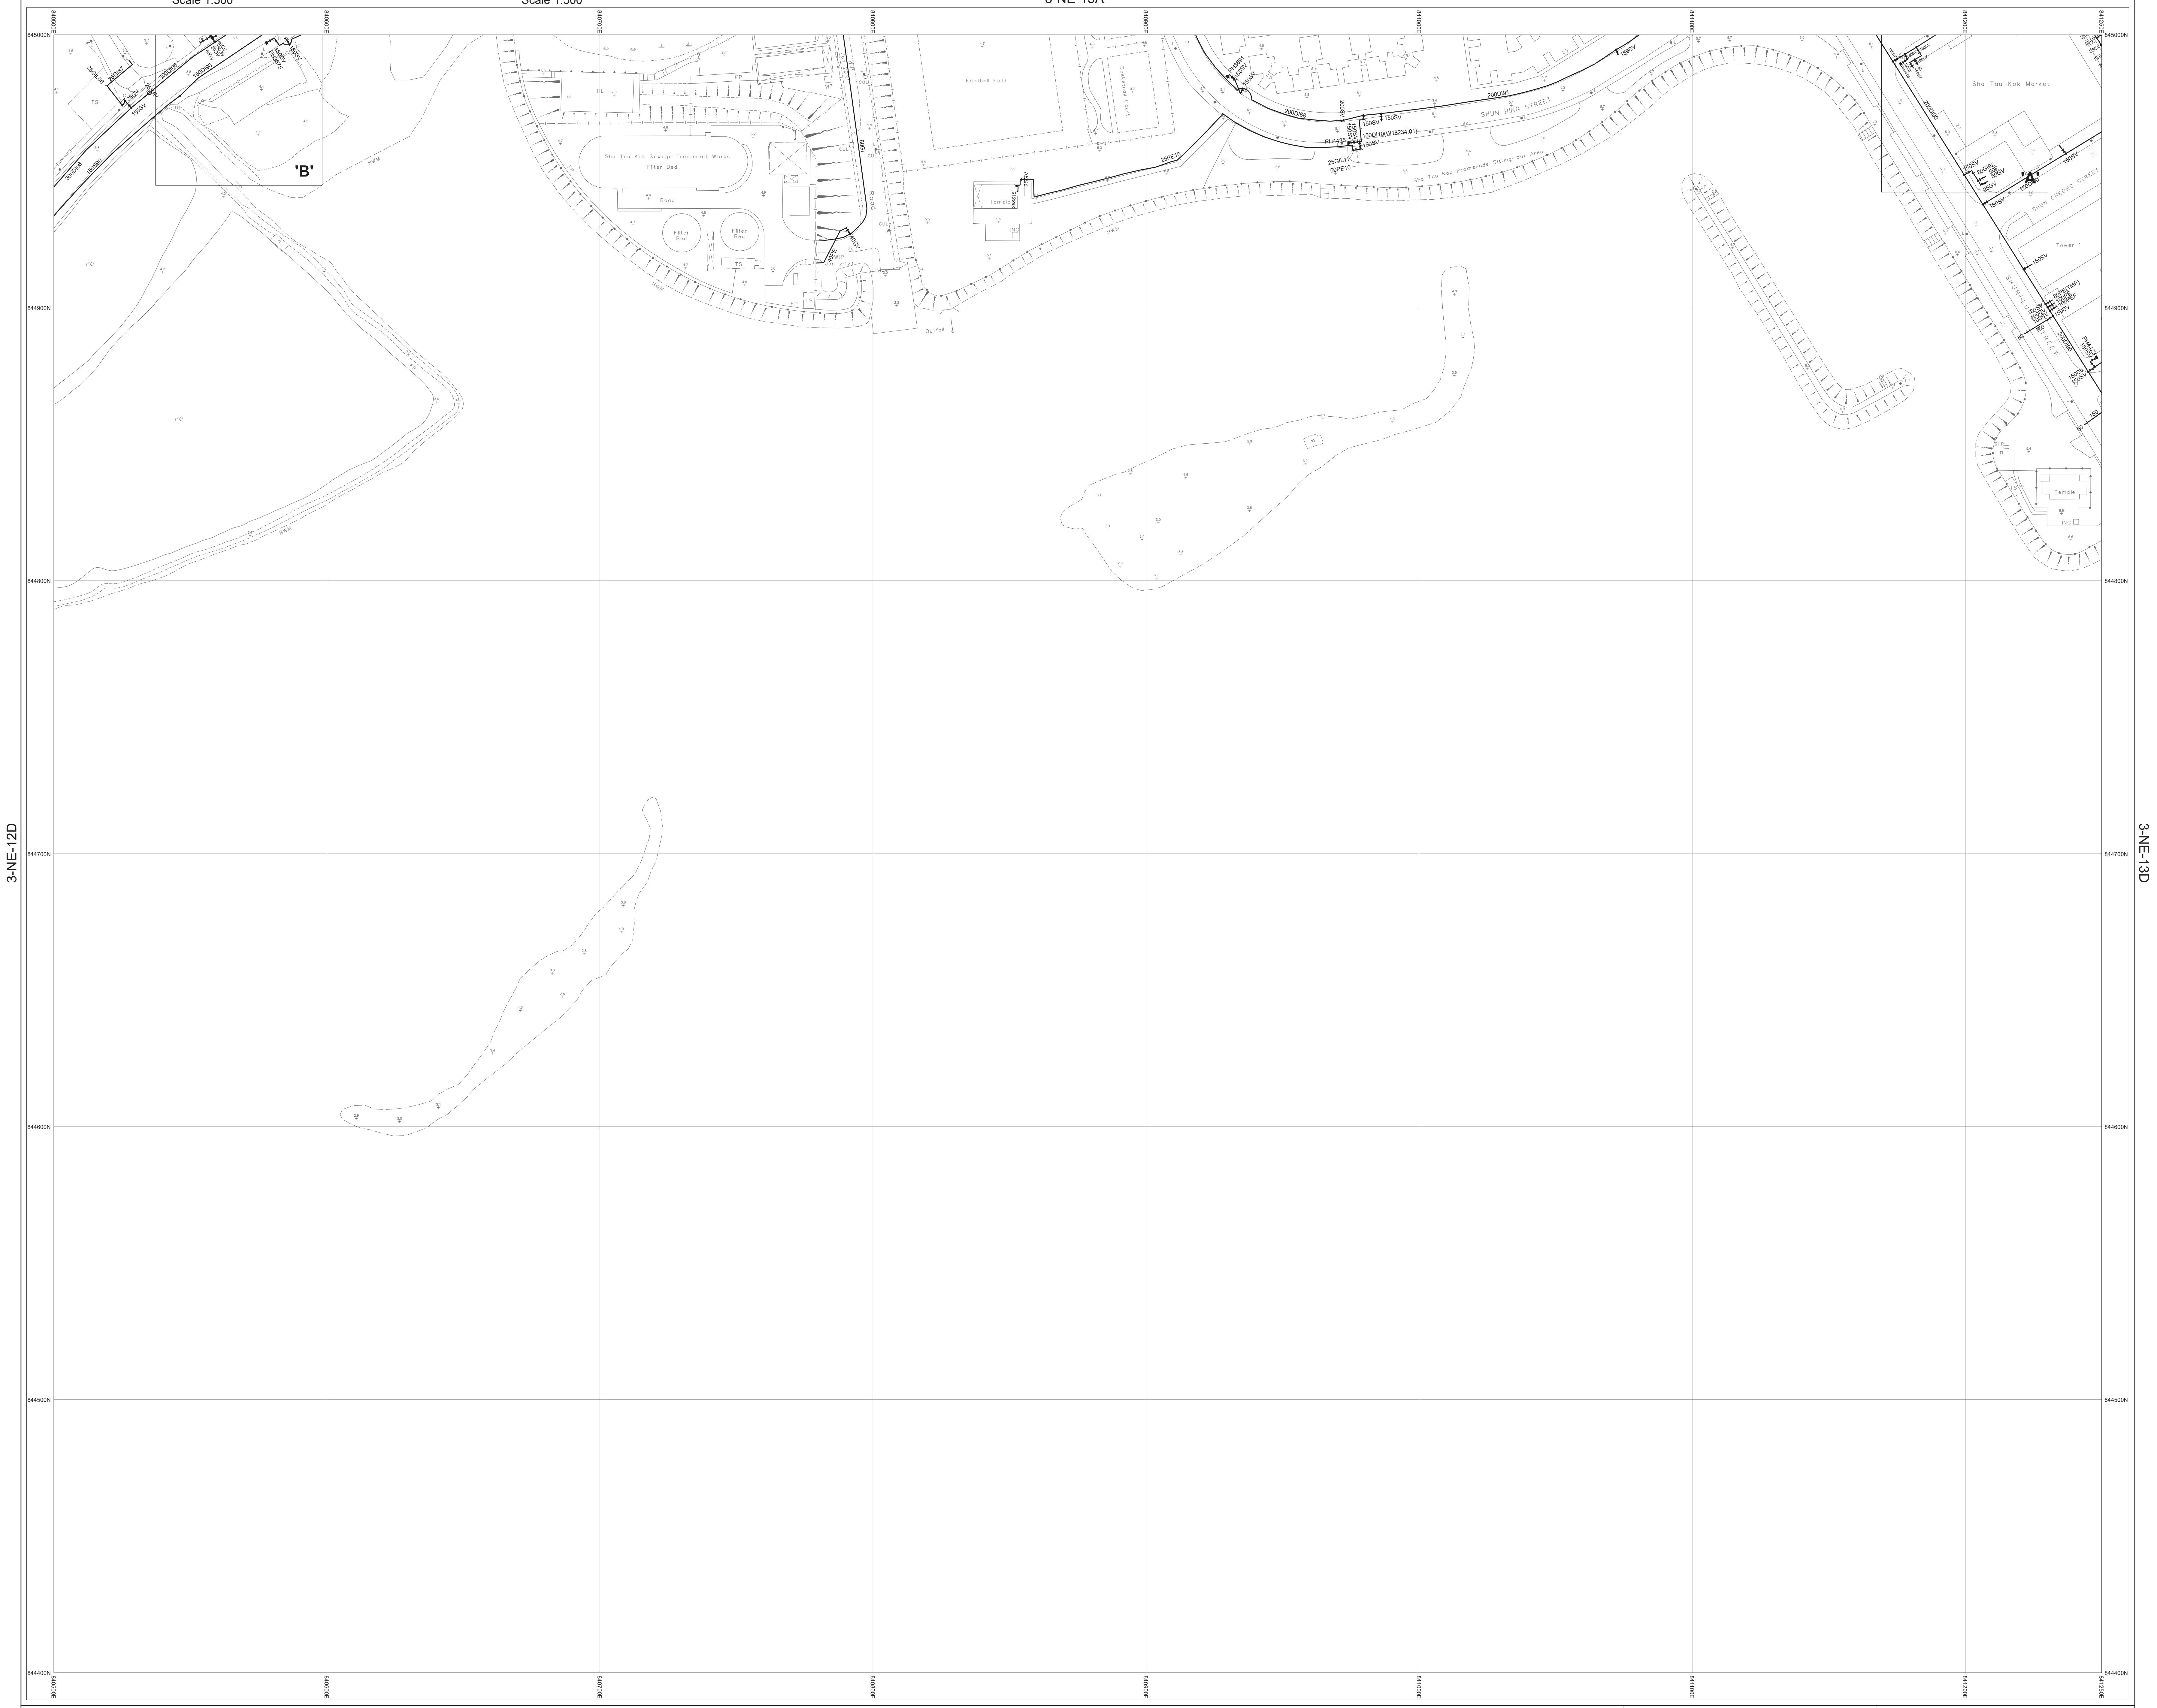

3-NE-18A

THIS IS A COMPUTER PRINTOUT,
NO SIGNATURE IS REQUIRED.

NOTES:
1. FOR MAINS RECORDS SIGN CONVENTIONS AND DESIGNATIONS SEE SKETCH NO.3988.
2. DIMENSIONS OF MAINS ARE IN MILLIMETRES UNLESS OTHERWISE SPECIFIED.
3. ALL LEVELS ARE IN METRES ABOVE PRINCIPAL DATUM.

Basemap Date Updated On: 30/04/2019

SCALE 1:1 000

METRES 20 10 0 20 40 60 80 100 METRES

FRESH WATER MAINS RECORD PLAN

SHA TAU KOK TAN KA

COPYRIGHT RESERVED

DATE REVISED : 08/03/2023

DRAWING NO.
W67880/ 3-NE-13C

SIGNED
C.S. CHIN
CE/MNE
DATE: 09/11/1998

Water Supplies Department
HONG KONG

© The Government of the Hong Kong SAR, Map reproduced with permission of the Director of Lands