INSET 'A'	INSET 'B'	INSET 'C'	INSET 'D'	INSET 'E'	INSET 'F'

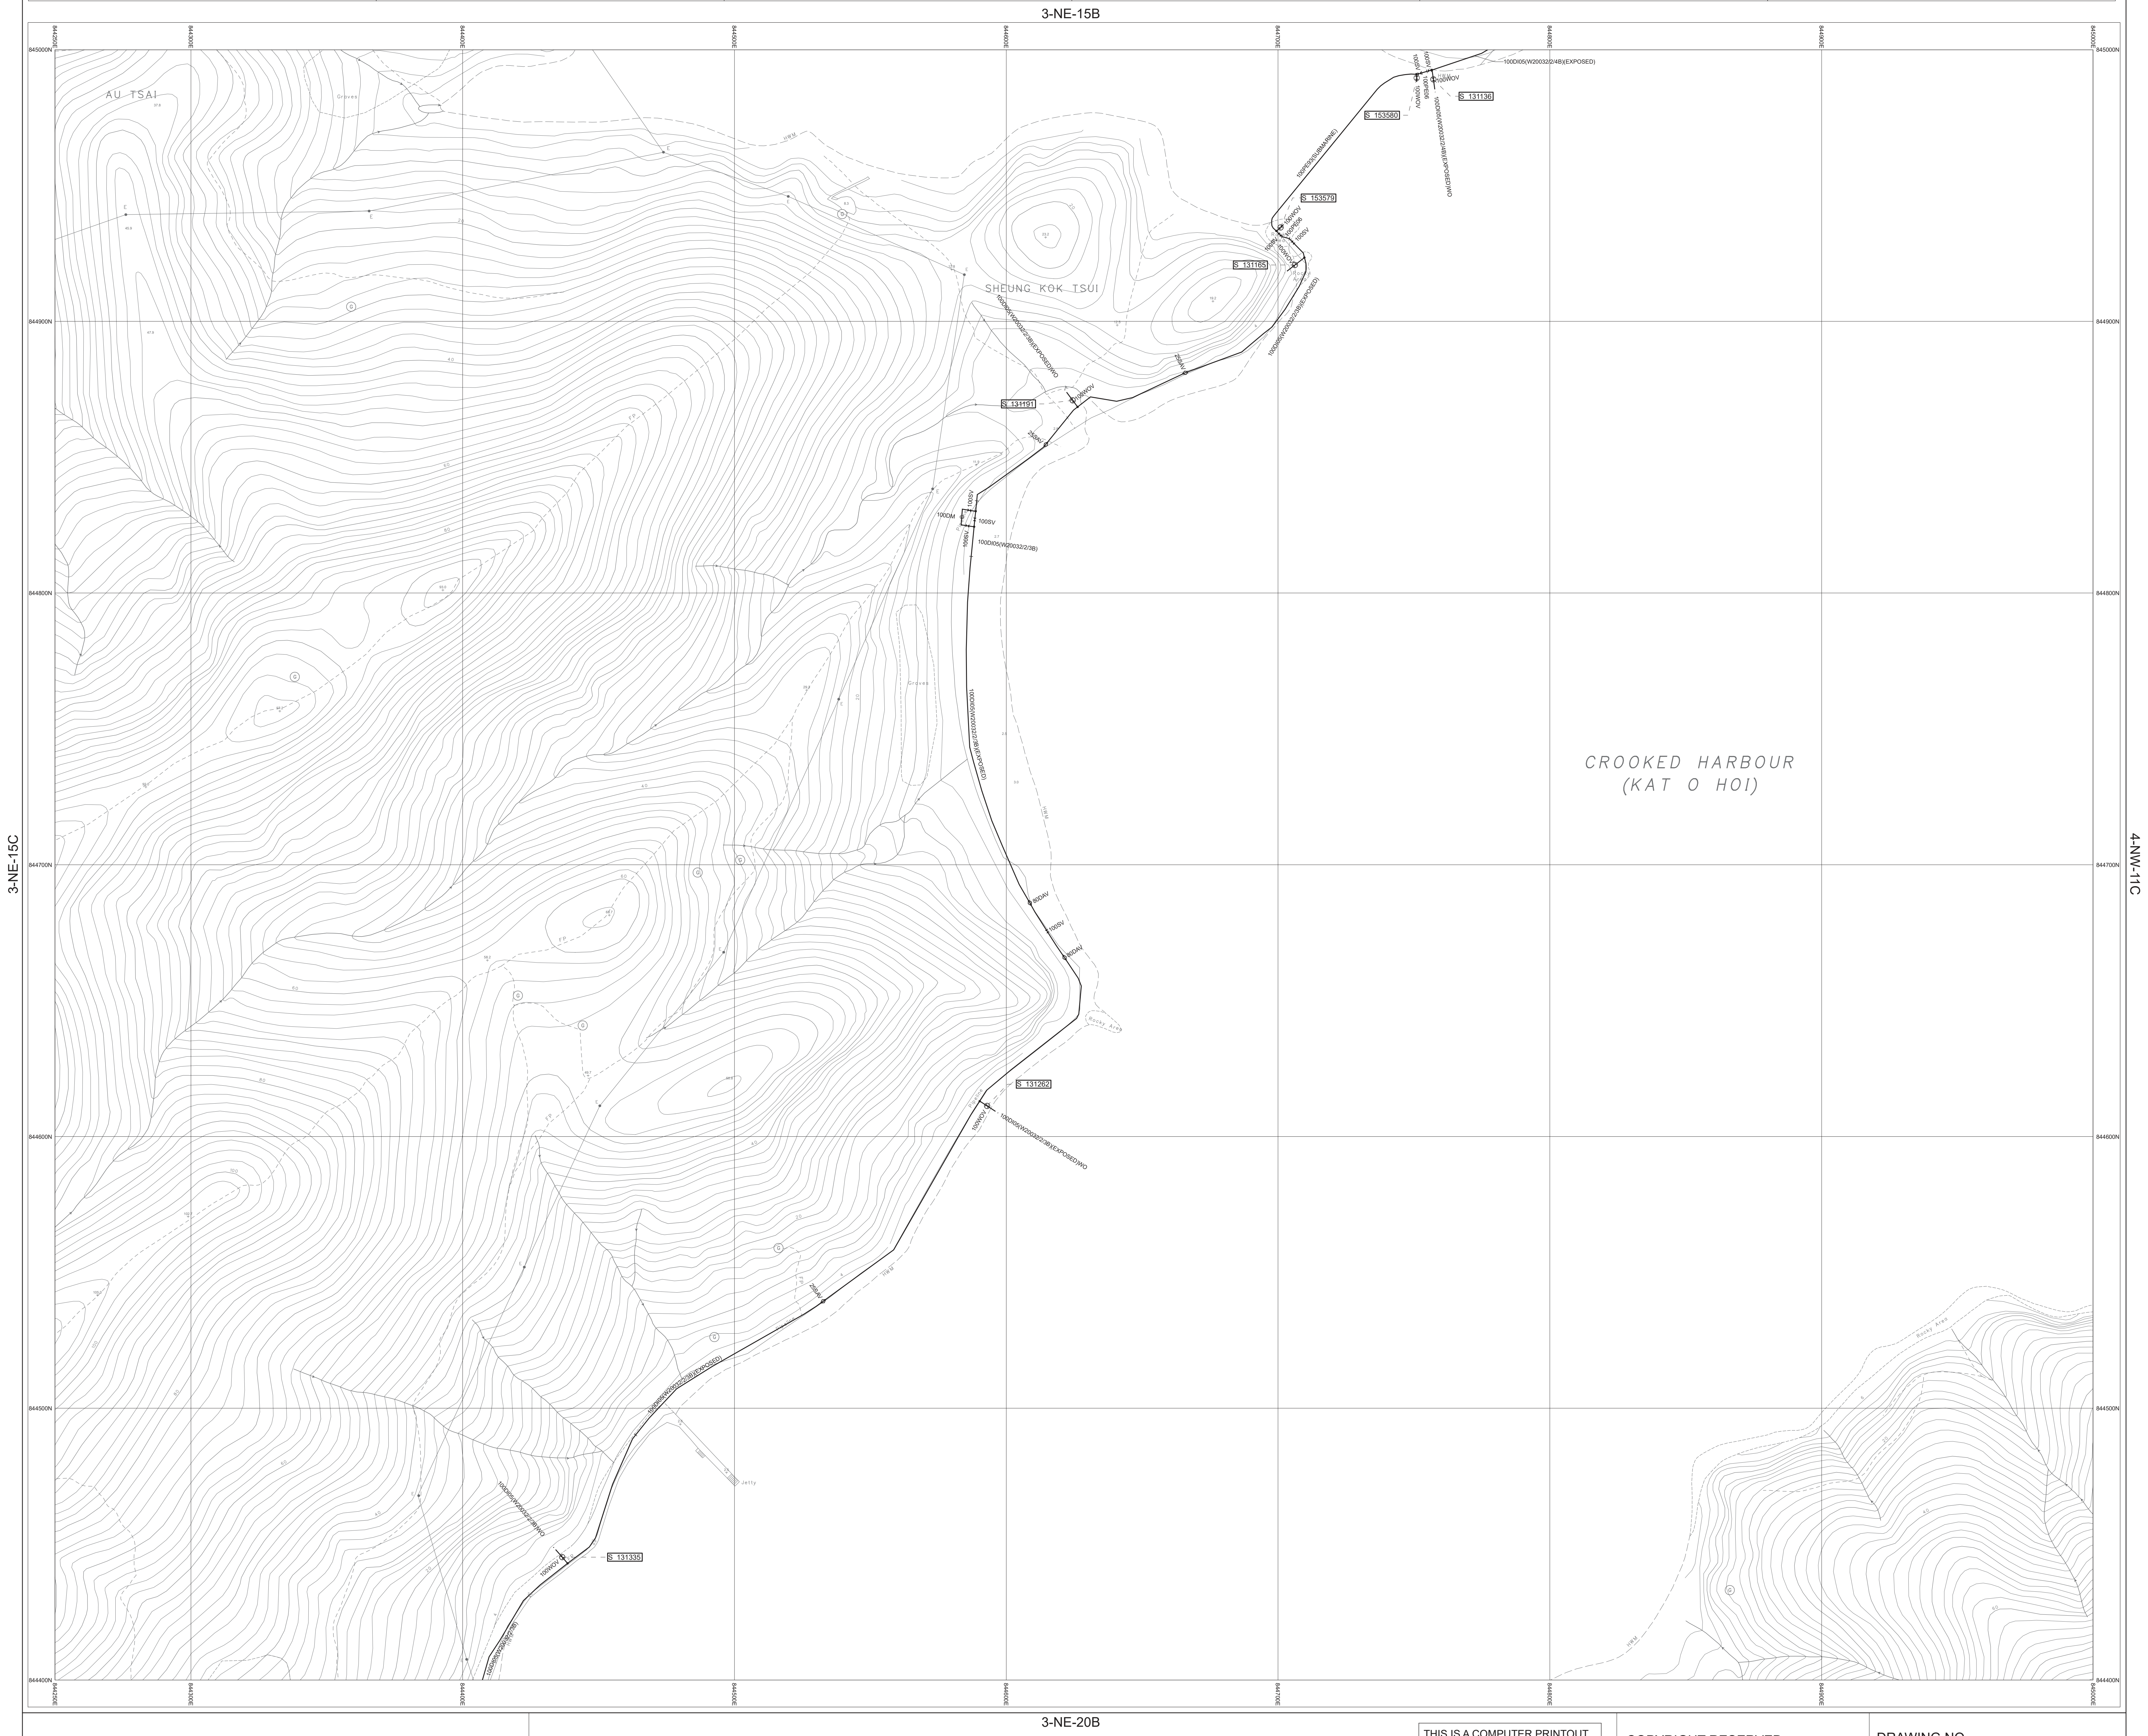
3-NE-15B
3-NE-15C
4-NW-11C
3-NE-20B
844250E
844300E
844400E
844500E
844600E
844700E
844800E
844900E
845000E
845000N
844900N
844800N
844700N
844600N
844500N
844400N
AU TSAI
SHEUNG KOK TSUI
CROOKED HARBOUR
(KAT O HOI)
100DI05(W20032/2/4B)(EXPOSED)
100SV
100SV
100PE06
100WOV
100WOV
S 131136
S 153580
100DI05(W20032/2/4B)(EXPOSED)WO
100PE93(SUBMARINE)
S 153579
100WOV
100PE06
100SV
100SV
100WOV
S 131165
Rocky Area
100DI05(W20032/2/3B)(EXPOSED)
100DI05(W20032/2/3B)(EXPOSED)WO
25SAV
100WOV
S 131191
25SAV
100SV
100DM
100SV
100SV
100DI05(W20032/2/3B)
Graves
100DI05(W20032/2/3B)(EXPOSED)
HWM
80DAV
100SV
80DAV
Rocky Area
S 131262
Pipeline
100WOV
100DI05(W20032/2/3B)(EXPOSED)WO
25SAV
Pipeline
100DI05(W20032/2/3B)(EXPOSED)
Jetty
100DI05(W20032/2/3B)WO
100WOV
S 131335
100DI05(W20032/2/3B)

NOTES:

1. FOR MAINS RECORDS SIGN CONVENTIONS AND DESIGNATIONS SEE SKETCH NO.3988.
2. DIMENSIONS OF MAINS ARE IN MILLIMETRES UNLESS OTHERWISE SPECIFIED.
3. ALL LEVELS ARE IN METRES ABOVE PRINCIPAL DATUM.

Basemap Date Updated On: 30/04/2019

SCALE 1:1 000

METRES 20 10 0 20 40 60 80 100 METRES

THIS IS A COMPUTER PRINTOUT,
NO SIGNATURE IS REQUIRED.

FRESH WATER MAINS RECORD PLAN

SHEUNG KOK TSUI

COPYRIGHT RESERVED

DATE REVISED : 02/05/2024

DRAWING NO.
W67880/ 3-NE-15D

SIGNED C.S. CHIN
CE/MNE
DATE: 09/11/1998

Water Supplies Department
HONG KONG

© The Government of the Hong Kong SAR, Map reproduced with permission of the Director of Lands