INSET 'A'	INSET 'B'	INSET 'C'	INSET 'D'	INSET 'E'	INSET 'F'

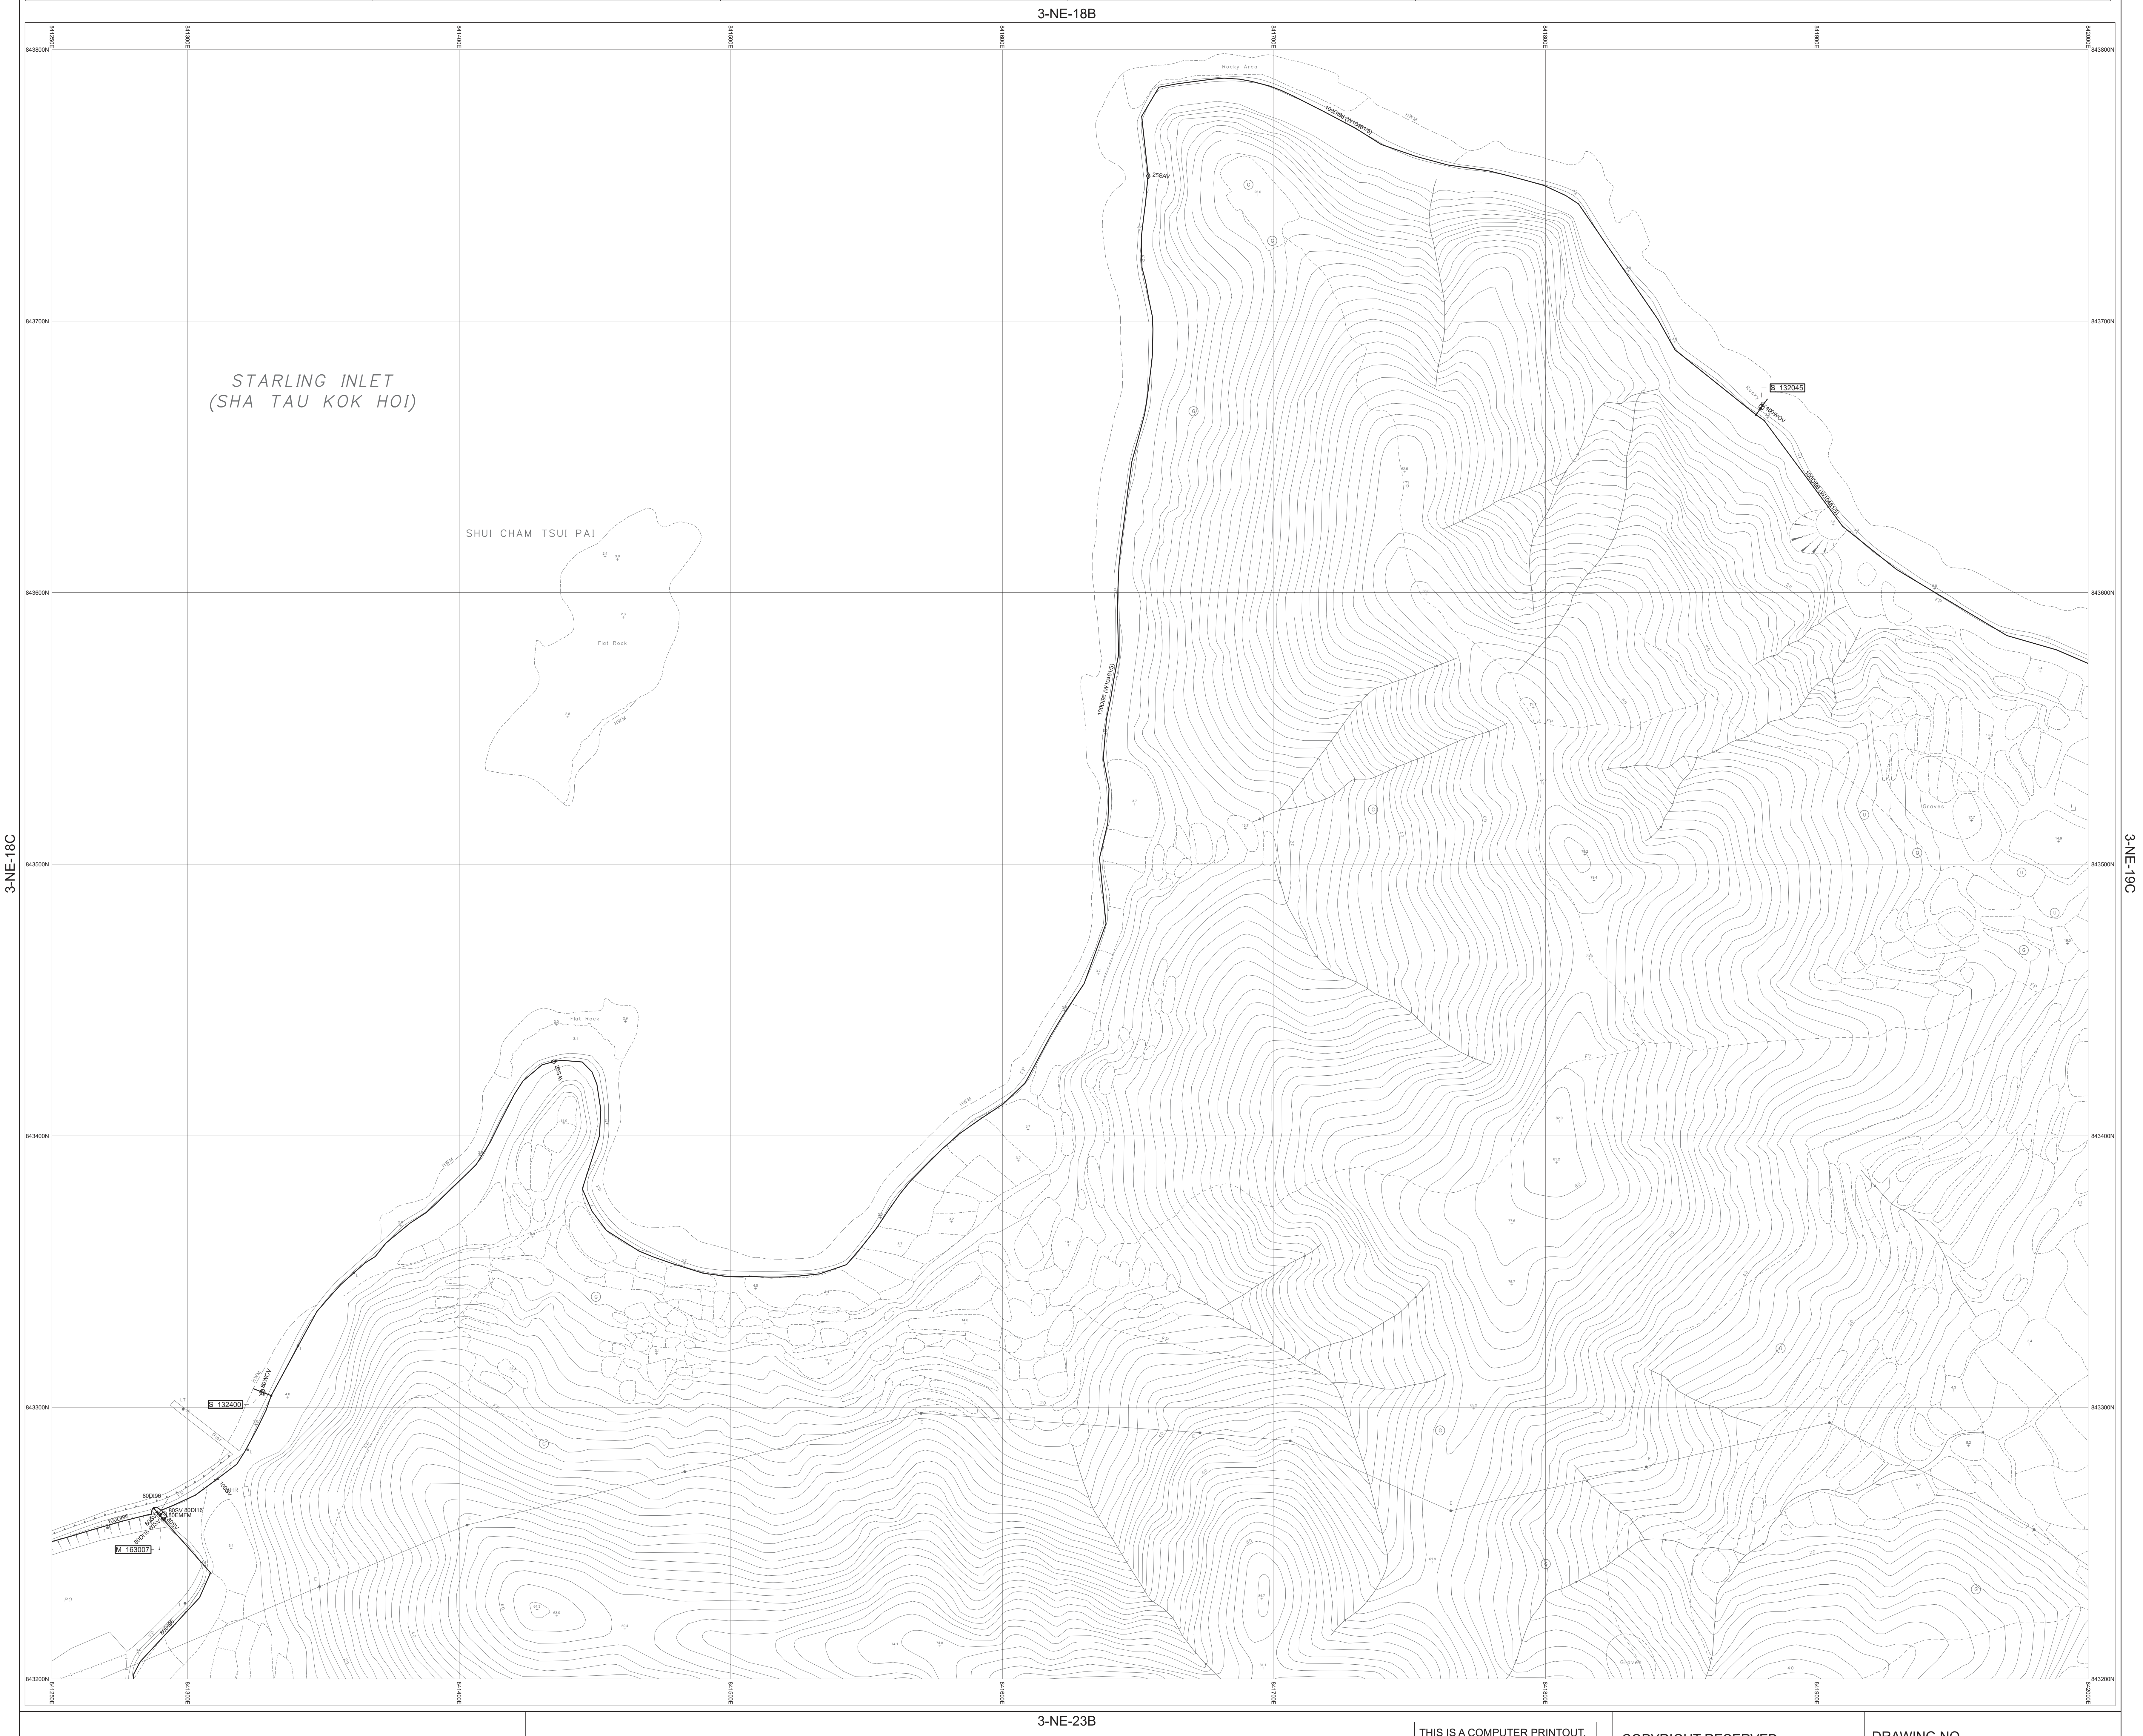
3-NE-18B
3-NE-23B
3-NE-18C
3-NE-19C
STARLING INLET
(SHA TAU KOK HOI)
SHUI CHAM TSUI PAI
Flat Rock
Rocky Area
HWM
100DI96 (W10461/5)
25SAV
S 132045
100WOV
S 132400
80WOV
100SV
80DI96
100DI96
80SV 80DI16
80EMFM
80SV
80DI16
M 163007
Pier
Graves
843200N
843300N
843700N
843800N
841250E
841300E
841400E
841700E
841800E
841900E
842000E

NOTES:
1. FOR MAINS RECORDS SIGN CONVENTIONS AND DESIGNATIONS SEE SKETCH NO.3988.
2. DIMENSIONS OF MAINS ARE IN MILLIMETRES UNLESS OTHERWISE SPECIFIED.
3. ALL LEVELS ARE IN METRES ABOVE PRINCIPAL DATUM.

Basemap Date Updated On: 11/04/2023

SCALE 1:1 000

METRES 20 10 0 20 40 60 80 100 METRES

THIS IS A COMPUTER PRINTOUT,
NO SIGNATURE IS REQUIRED.

FRESH WATER MAINS RECORD PLAN

FUNG HANG, SHA TAU KOK HOI

COPYRIGHT RESERVED

DATE REVISED : 01/08/2024

DRAWING NO.
W67880/ 3-NE-18D

SIGNED
C.S. CHIN
CE/MNE
DATE: 09/11/1998

Water Supplies Department
HONG KONG

© The Government of the Hong Kong SAR, Map reproduced with permission of the Director of Lands