INSET 'A'	INSET 'B'	INSET 'C'	INSET 'D'	INSET 'E'	INSET 'F'

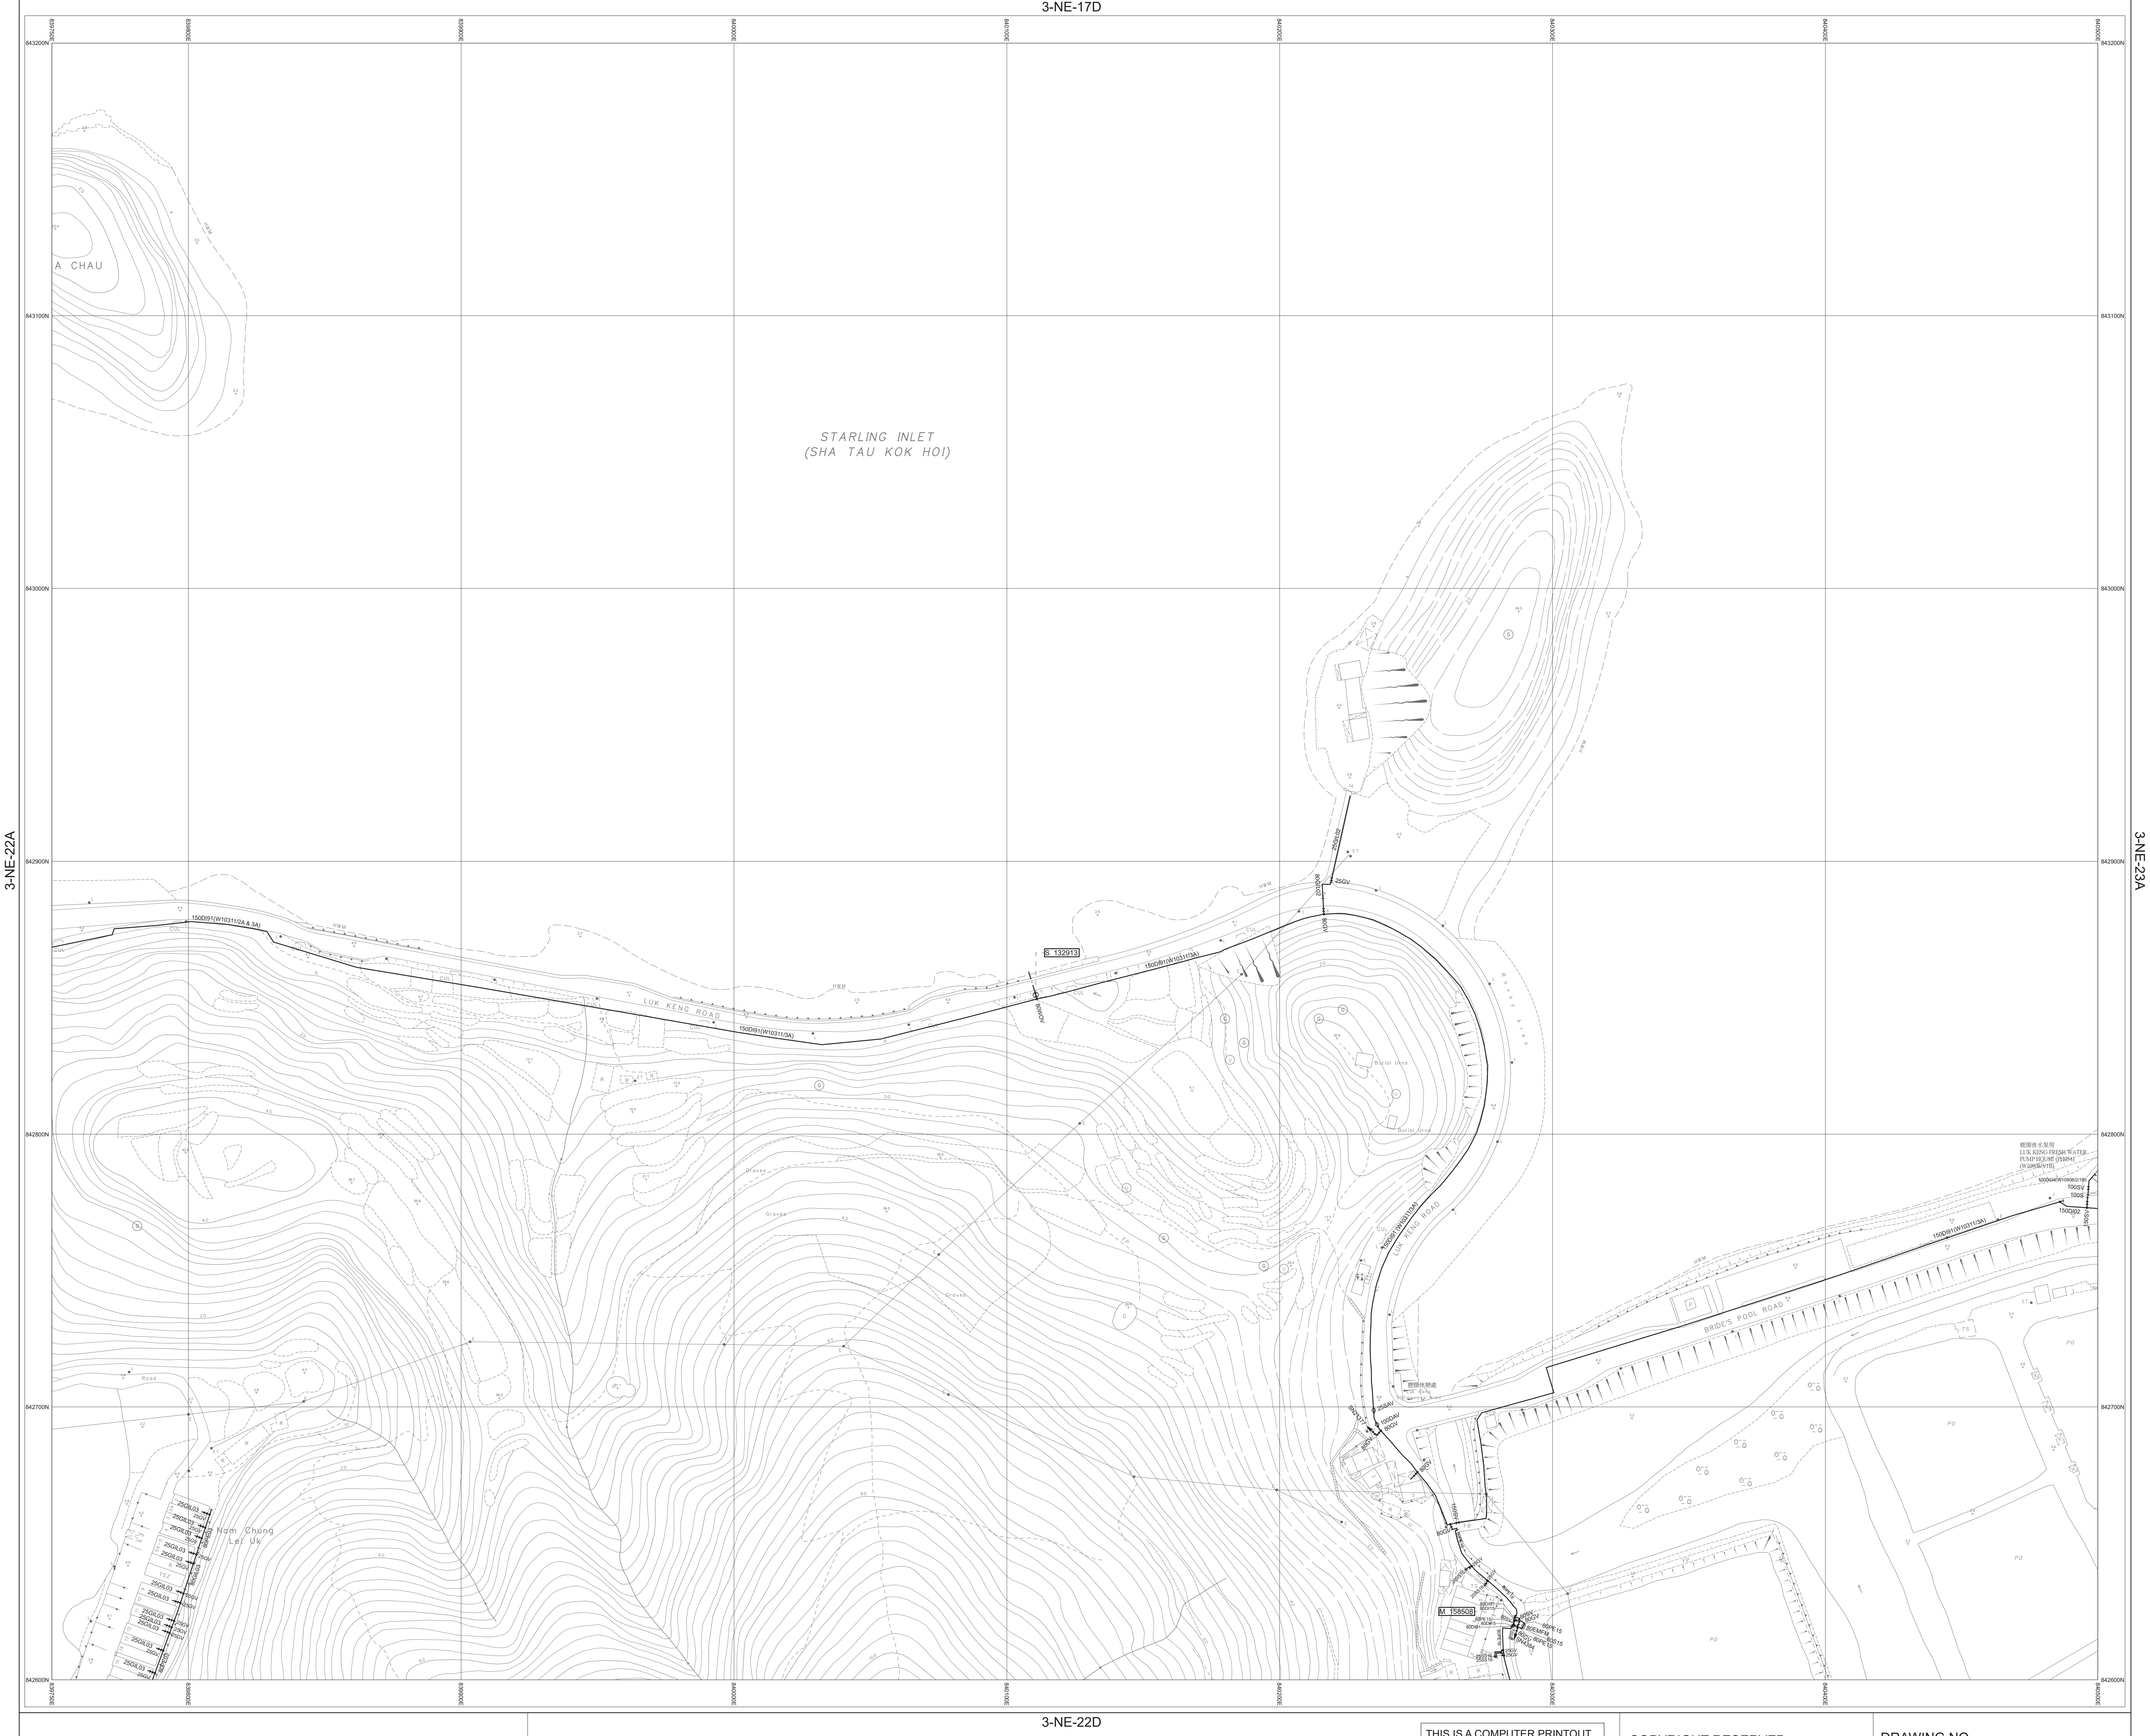
3-NE-17D
3-NE-22A
3-NE-23A
3-NE-22D
A CHAU
STARLING INLET
(SHA TAU KOK HOI)
LUK KENG ROAD
BRIDE'S POOL ROAD
Nam Chung
Lei Uk
S 132913
150DI91(W10311/3A)
80WOV
80GIL02
25GIL02
25GV
80GV
鹿頸食水泵房
LUK KENG FRESH WATER
PUMP HOUSE (PH054)
(W10908/3/1B)
100DI04(W10908/2/1B)
100SV
100S
150DI02
150SV
M 158508
80PE16
80SV
80GV
80PE15
80EMFM
80S15
SN4384
80DI91
80DI15
20SS16
25SS16
25GIL03
80GIL03
80PE03
842600N
842800N
839750E
839800E
839900E
840300E
840400E
840500E

NOTES:

1. FOR MAINS RECORDS SIGN CONVENTIONS AND DESIGNATIONS SEE SKETCH NO.3988.
2. DIMENSIONS OF MAINS ARE IN MILLIMETRES UNLESS OTHERWISE SPECIFIED.
3. ALL LEVELS ARE IN METRES ABOVE PRINCIPAL DATUM.

Basemap Date Updated On: 11/04/2023

SCALE 1:1 000

METRES 20 10 0 20 40 60 80 100 METRES

THIS IS A COMPUTER PRINTOUT,
NO SIGNATURE IS REQUIRED.

FRESH WATER MAINS RECORD PLAN

LUK KENG WONG UK, SHA TAU KOK HOI

COPYRIGHT RESERVED

DATE REVISED : 01/08/2024

SIGNED
C.S. CHIN
CE/MNE
DATE: 09/11/1998

DRAWING NO.
W67880/ 3-NE-22B

Water Supplies Department
HONG KONG

© The Government of the Hong Kong SAR, Map reproduced with permission of the Director of Lands