INSET 'A'

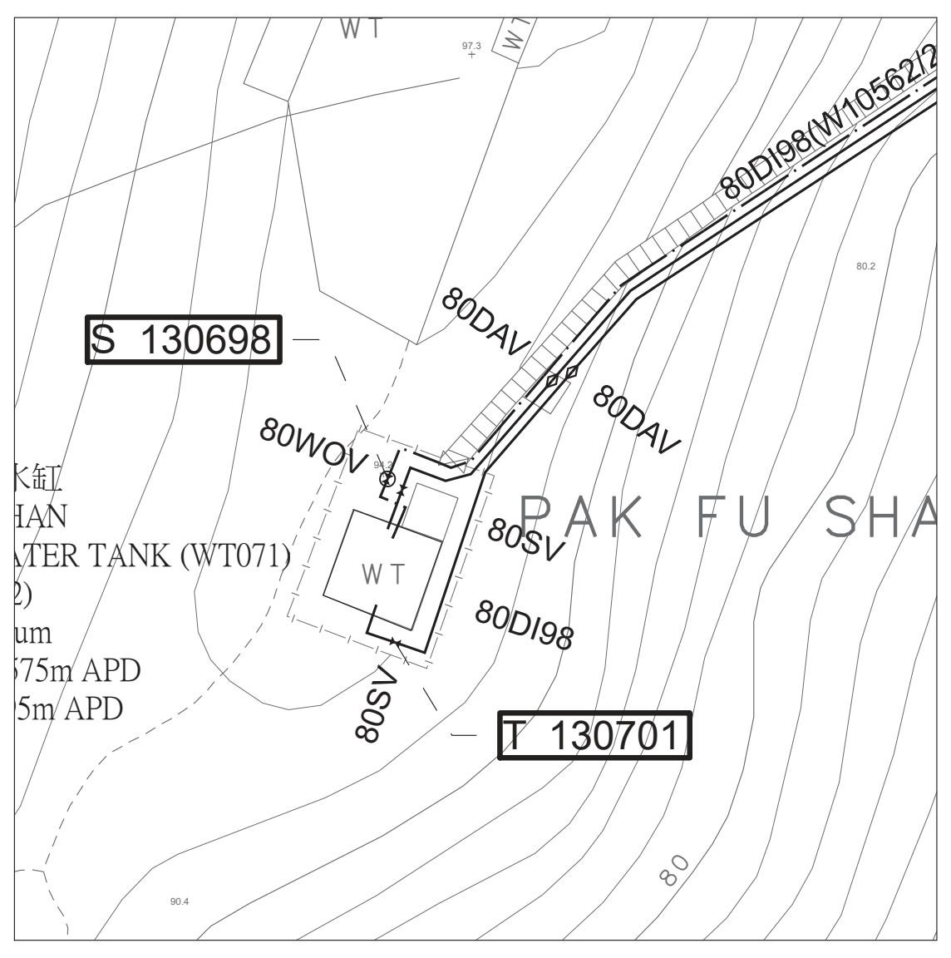
W T
80DI98(W10562/2
S 130698
80DAV
80DAV
80WOV
PAK FU SHA
W T
80SV
80DI98
80SV
T 130701
ATER TANK (WT071)
75m APD
5m APD
80

Scale 1:500

INSET 'B'

INSET 'C'

INSET 'D'

INSET 'E'

INSET 'F'

3-NW-4C

3-NW-8B

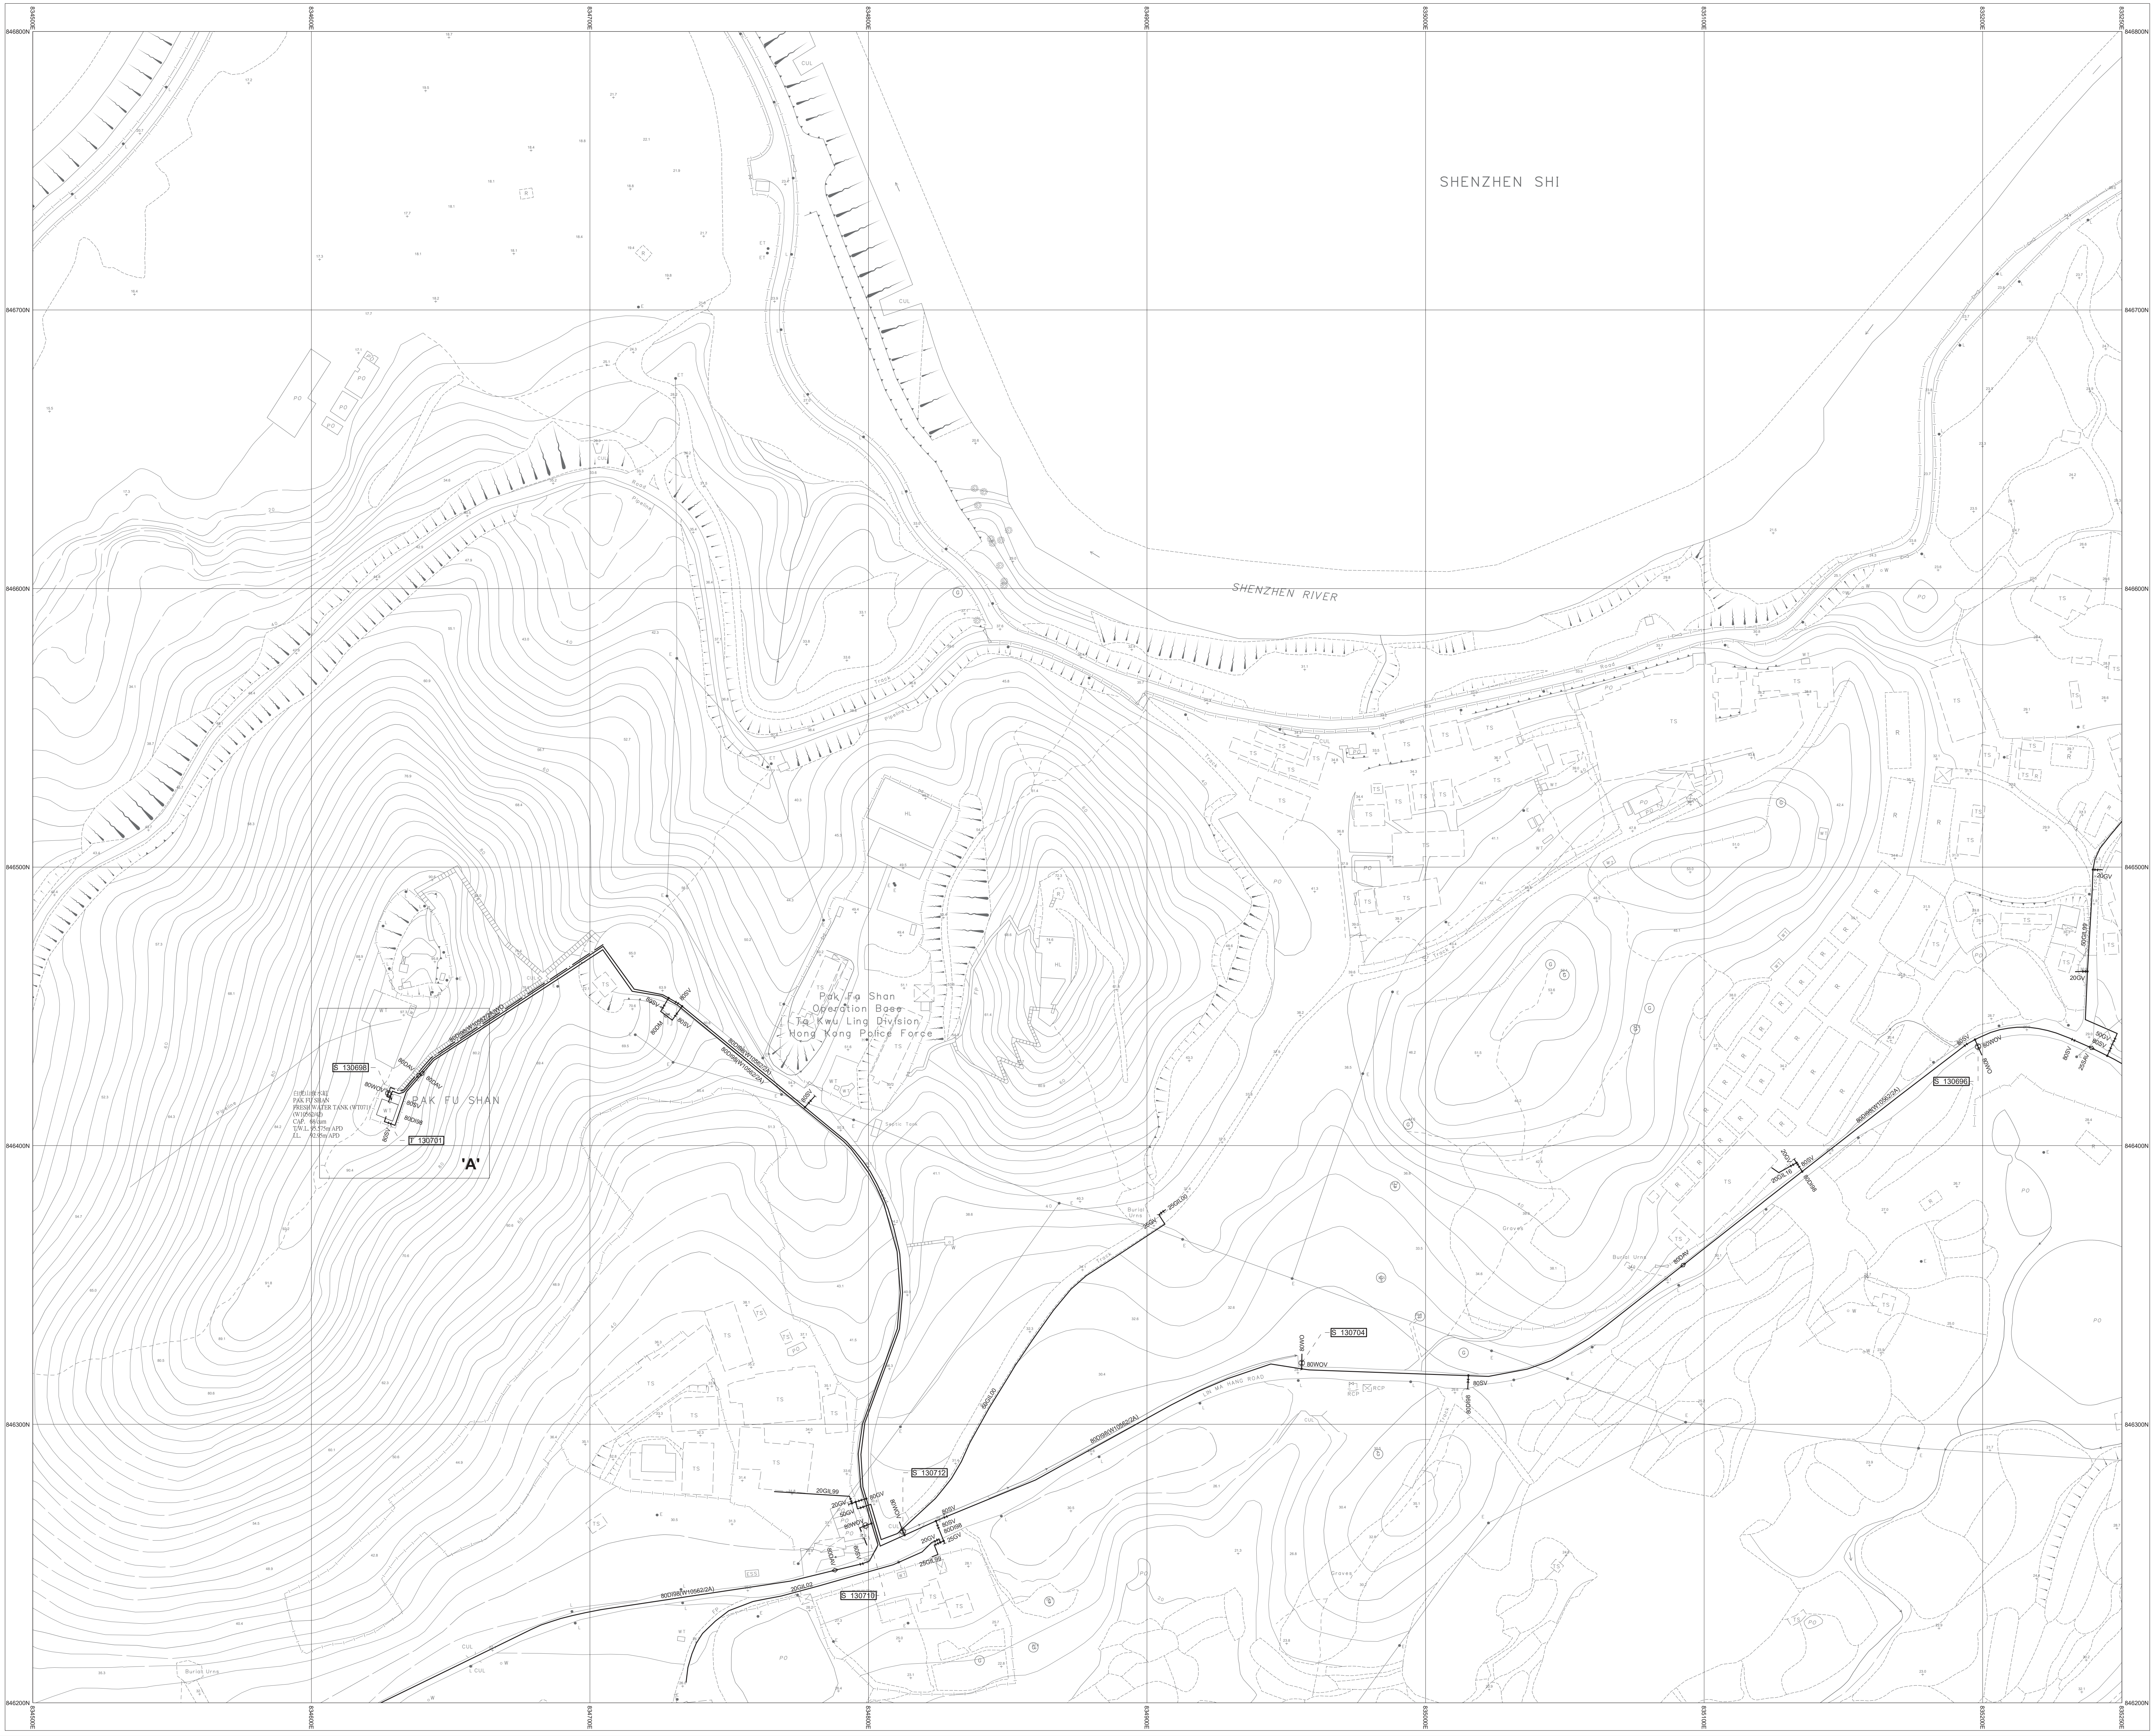
SHENZHEN SHI
SHENZHEN RIVER
Pak Fu Shan
Operation Base
Ta Kwu Ling Division
Hong Kong Police Force
PAK FU SHAN
S 130698
T 130701
'A'
S 130704
S 130696
LIN MA HANG ROAD
Burial Urns
846800N
846700N
846600N
846500N
846400N
846300N
846200N
834500E
834600E

3-NW-9B

3-NW-9C

NOTES:

1. FOR MAINS RECORDS SIGN CONVENTIONS AND DESIGNATIONS SEE SKETCH NO.3988.
2. DIMENSIONS OF MAINS ARE IN MILLIMETRES UNLESS OTHERWISE SPECIFIED.
3. ALL LEVELS ARE IN METRES ABOVE PRINCIPAL DATUM.

Basemap Date Updated On: 30/04/2019

SCALE 1:1 000

METRES 20 10 0 20 40 60 80 100 METRES

THIS IS A COMPUTER PRINTOUT,
NO SIGNATURE IS REQUIRED.

FRESH WATER MAINS RECORD PLAN

LIN MA HANG ROAD, PAK FU SHAN

COPYRIGHT RESERVED

DATE REVISED : 03/06/2024

DRAWING NO.

W67880/ 3-NW-9A

SIGNED C.S. CHIN
CE/MNE
DATE: 09/11/1998

Water Supplies Department
HONG KONG

© The Government of the Hong Kong SAR, Map reproduced with permission of the Director of Lands