INSET 'A'	INSET 'B'	INSET 'C'	INSET 'D'	INSET 'E'	INSET 'F'

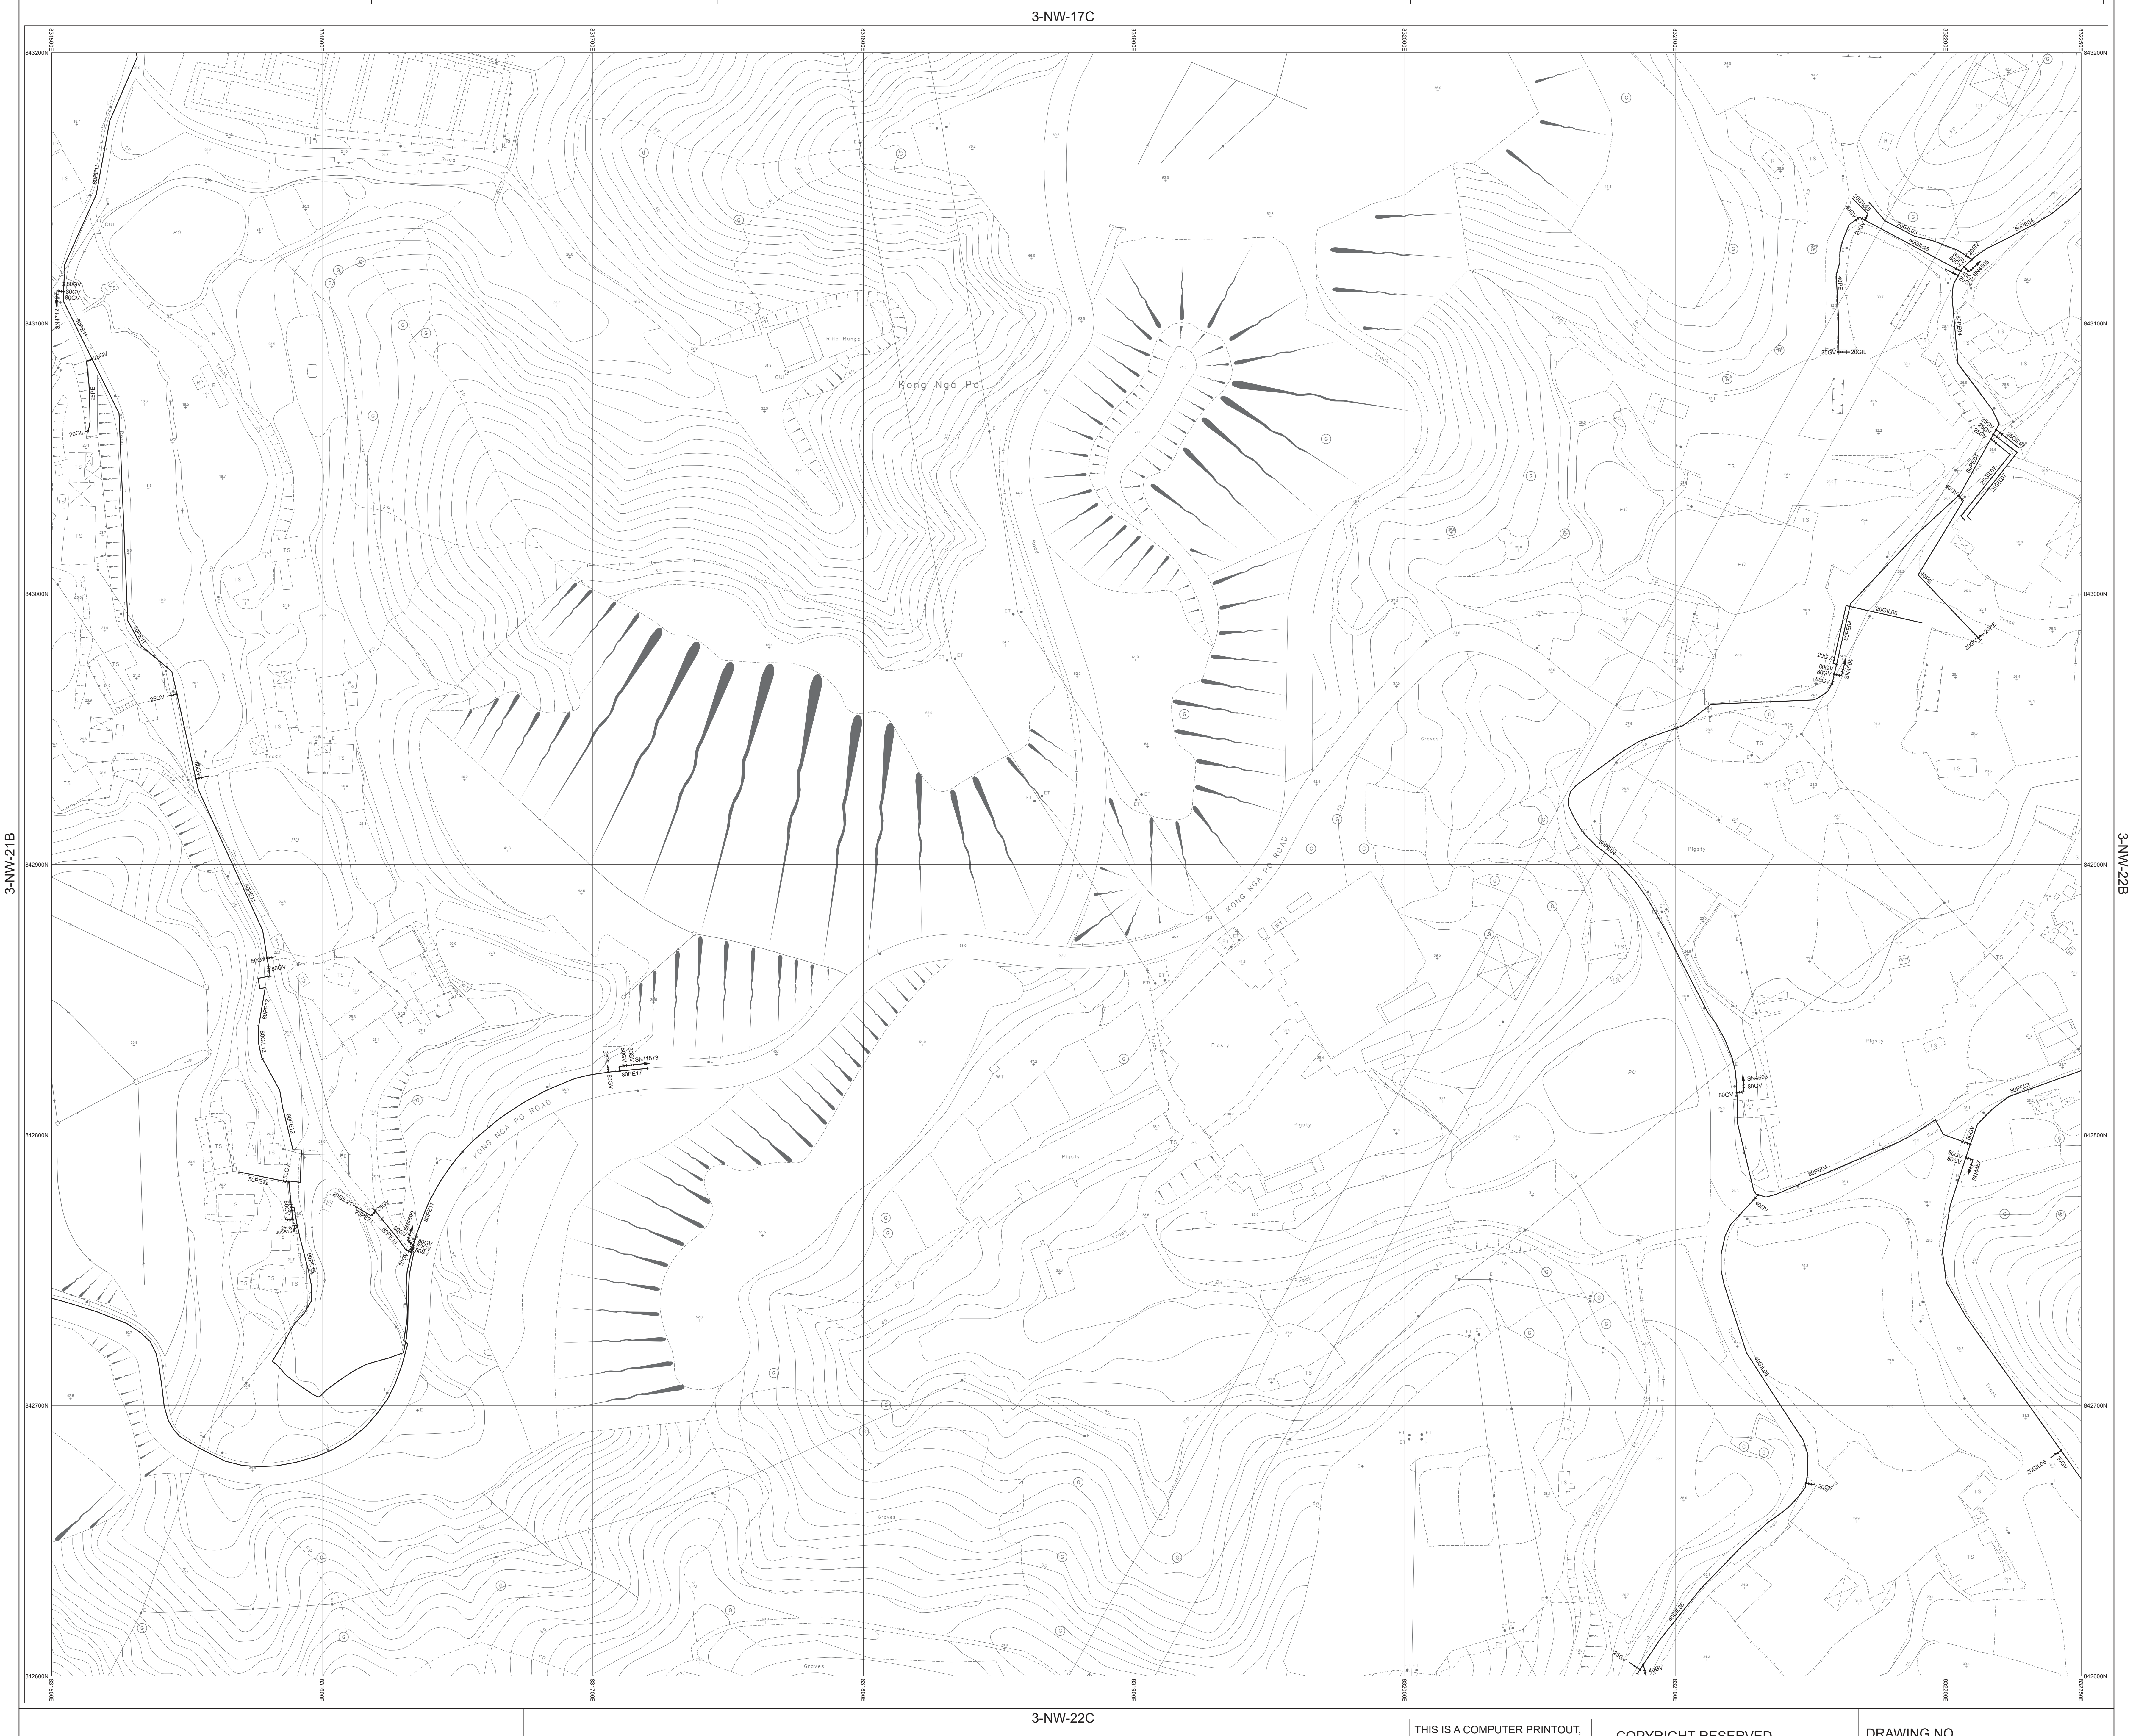
3-NW-17C
3-NW-21B
3-NW-22B
3-NW-22C
Kong Nga Po
KONG NGA PO ROAD
842600N
831500E
831600E
832000E
832100E
832200E
832250E
40GIL05
25GV
40GV

NOTES:

1. FOR MAINS RECORDS SIGN CONVENTIONS AND DESIGNATIONS SEE SKETCH NO.3988.
2. DIMENSIONS OF MAINS ARE IN MILLIMETRES UNLESS OTHERWISE SPECIFIED.
3. ALL LEVELS ARE IN METRES ABOVE PRINCIPAL DATUM.

Basemap Date Updated On: 30/04/2019

SCALE 1:1 000

METRES 20 10 0 20 40 60 80 100 METRES

THIS IS A COMPUTER PRINTOUT,
NO SIGNATURE IS REQUIRED.

FRESH WATER MAINS RECORD PLAN

KONG NGA PO, ALONG KONG NGA PO ROAD

COPYRIGHT RESERVED

DATE REVISED : 08/03/2023

SIGNED
M.T. NG
CE/NTE
DATE: 24/02/2004

DRAWING NO.
W67880/ 3-NW-22A

Water Supplies Department
HONG KONG

© The Government of the Hong Kong SAR, Map reproduced with permission of the Director of Lands