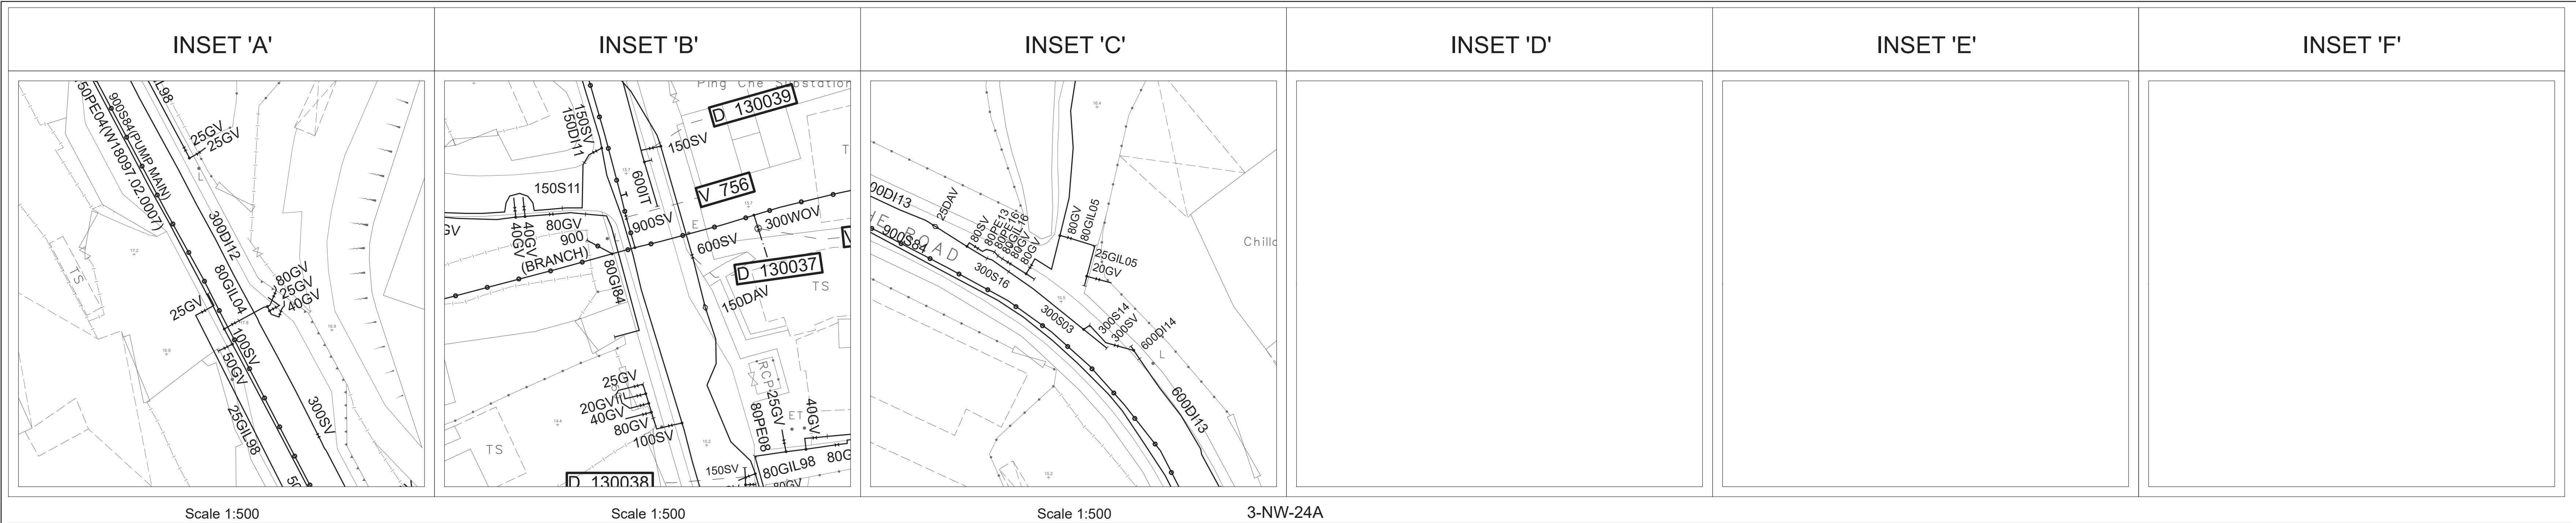
INSET 'A'
INSET 'B'
INSET 'C'
INSET 'D'
INSET 'E'
INSET 'F'
D 130039
V 756
D 130037
D 130038
Scale 1:500
Scale 1:500
Scale 1:500


3-NW-24A
3-NW-23D
3-NW-24D
3-SW-4A
'A'
'C'
Pok Hue Shan
The Baptist Convention of
H.K. Baptist Assembly
Football Field
Open Storage

NOTES:

1. FOR MAINS RECORDS SIGN CONVENTIONS AND DESIGNATIONS SEE SKETCH NO.3988.
2. DIMENSIONS OF MAINS ARE IN MILLIMETRES UNLESS OTHERWISE SPECIFIED.
3. ALL LEVELS ARE IN METRES ABOVE PRINCIPAL DATUM.

Basemap Date Updated On: 11/04/2023

SCALE 1:1 000

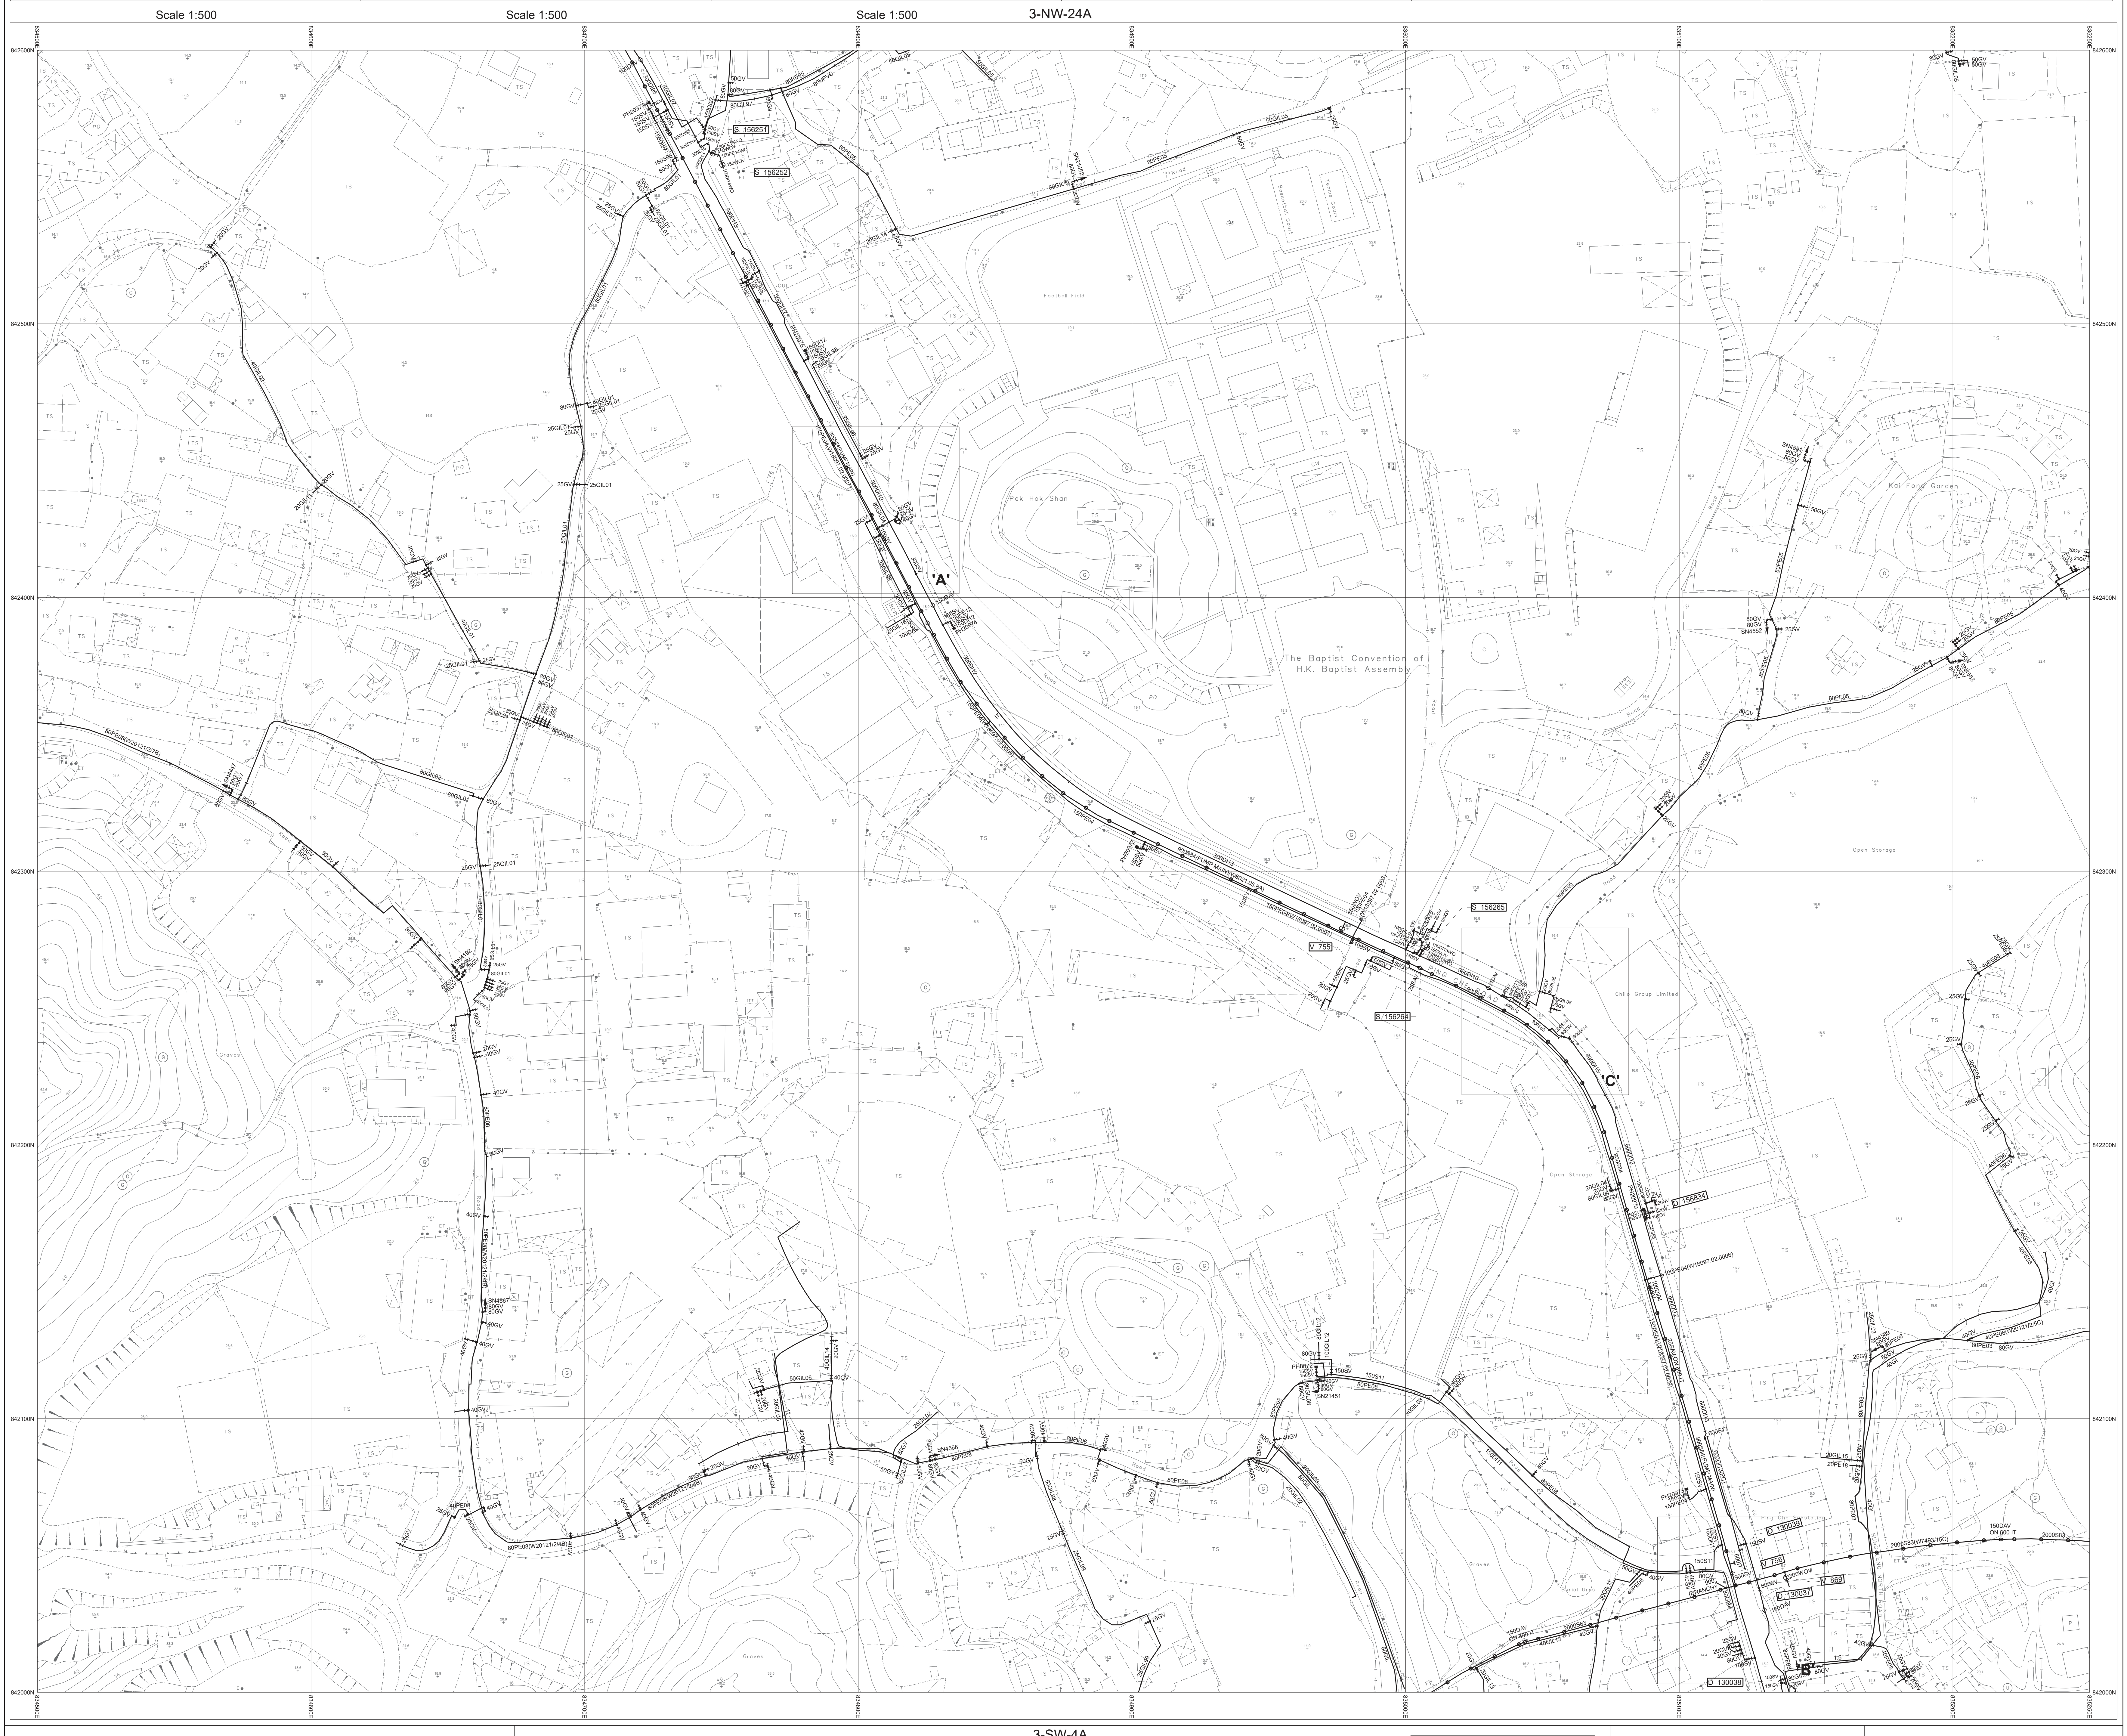METRES 20 10 0 20 40 60 80 100 METRES

THIS IS A COMPUTER PRINTOUT,
NO SIGNATURE IS REQUIRED.

FRESH WATER MAINS RECORD PLAN

BAPTIST ASSEMBLY, PING CHE ROAD

COPYRIGHT RESERVED

DATE REVISED : 03/10/2024

DRAWING NO.

W67880/ 3-NW-24C

SIGNED C.S. CHIN
CE/MNE
DATE: 09/11/1998

Water Supplies Department
HONG KONG

© The Government of the Hong Kong SAR, Map reproduced with permission of the Director of Lands