INSET 'A'

INSET 'B'

INSET 'C'

INSET 'D'

INSET 'E'

INSET 'F'

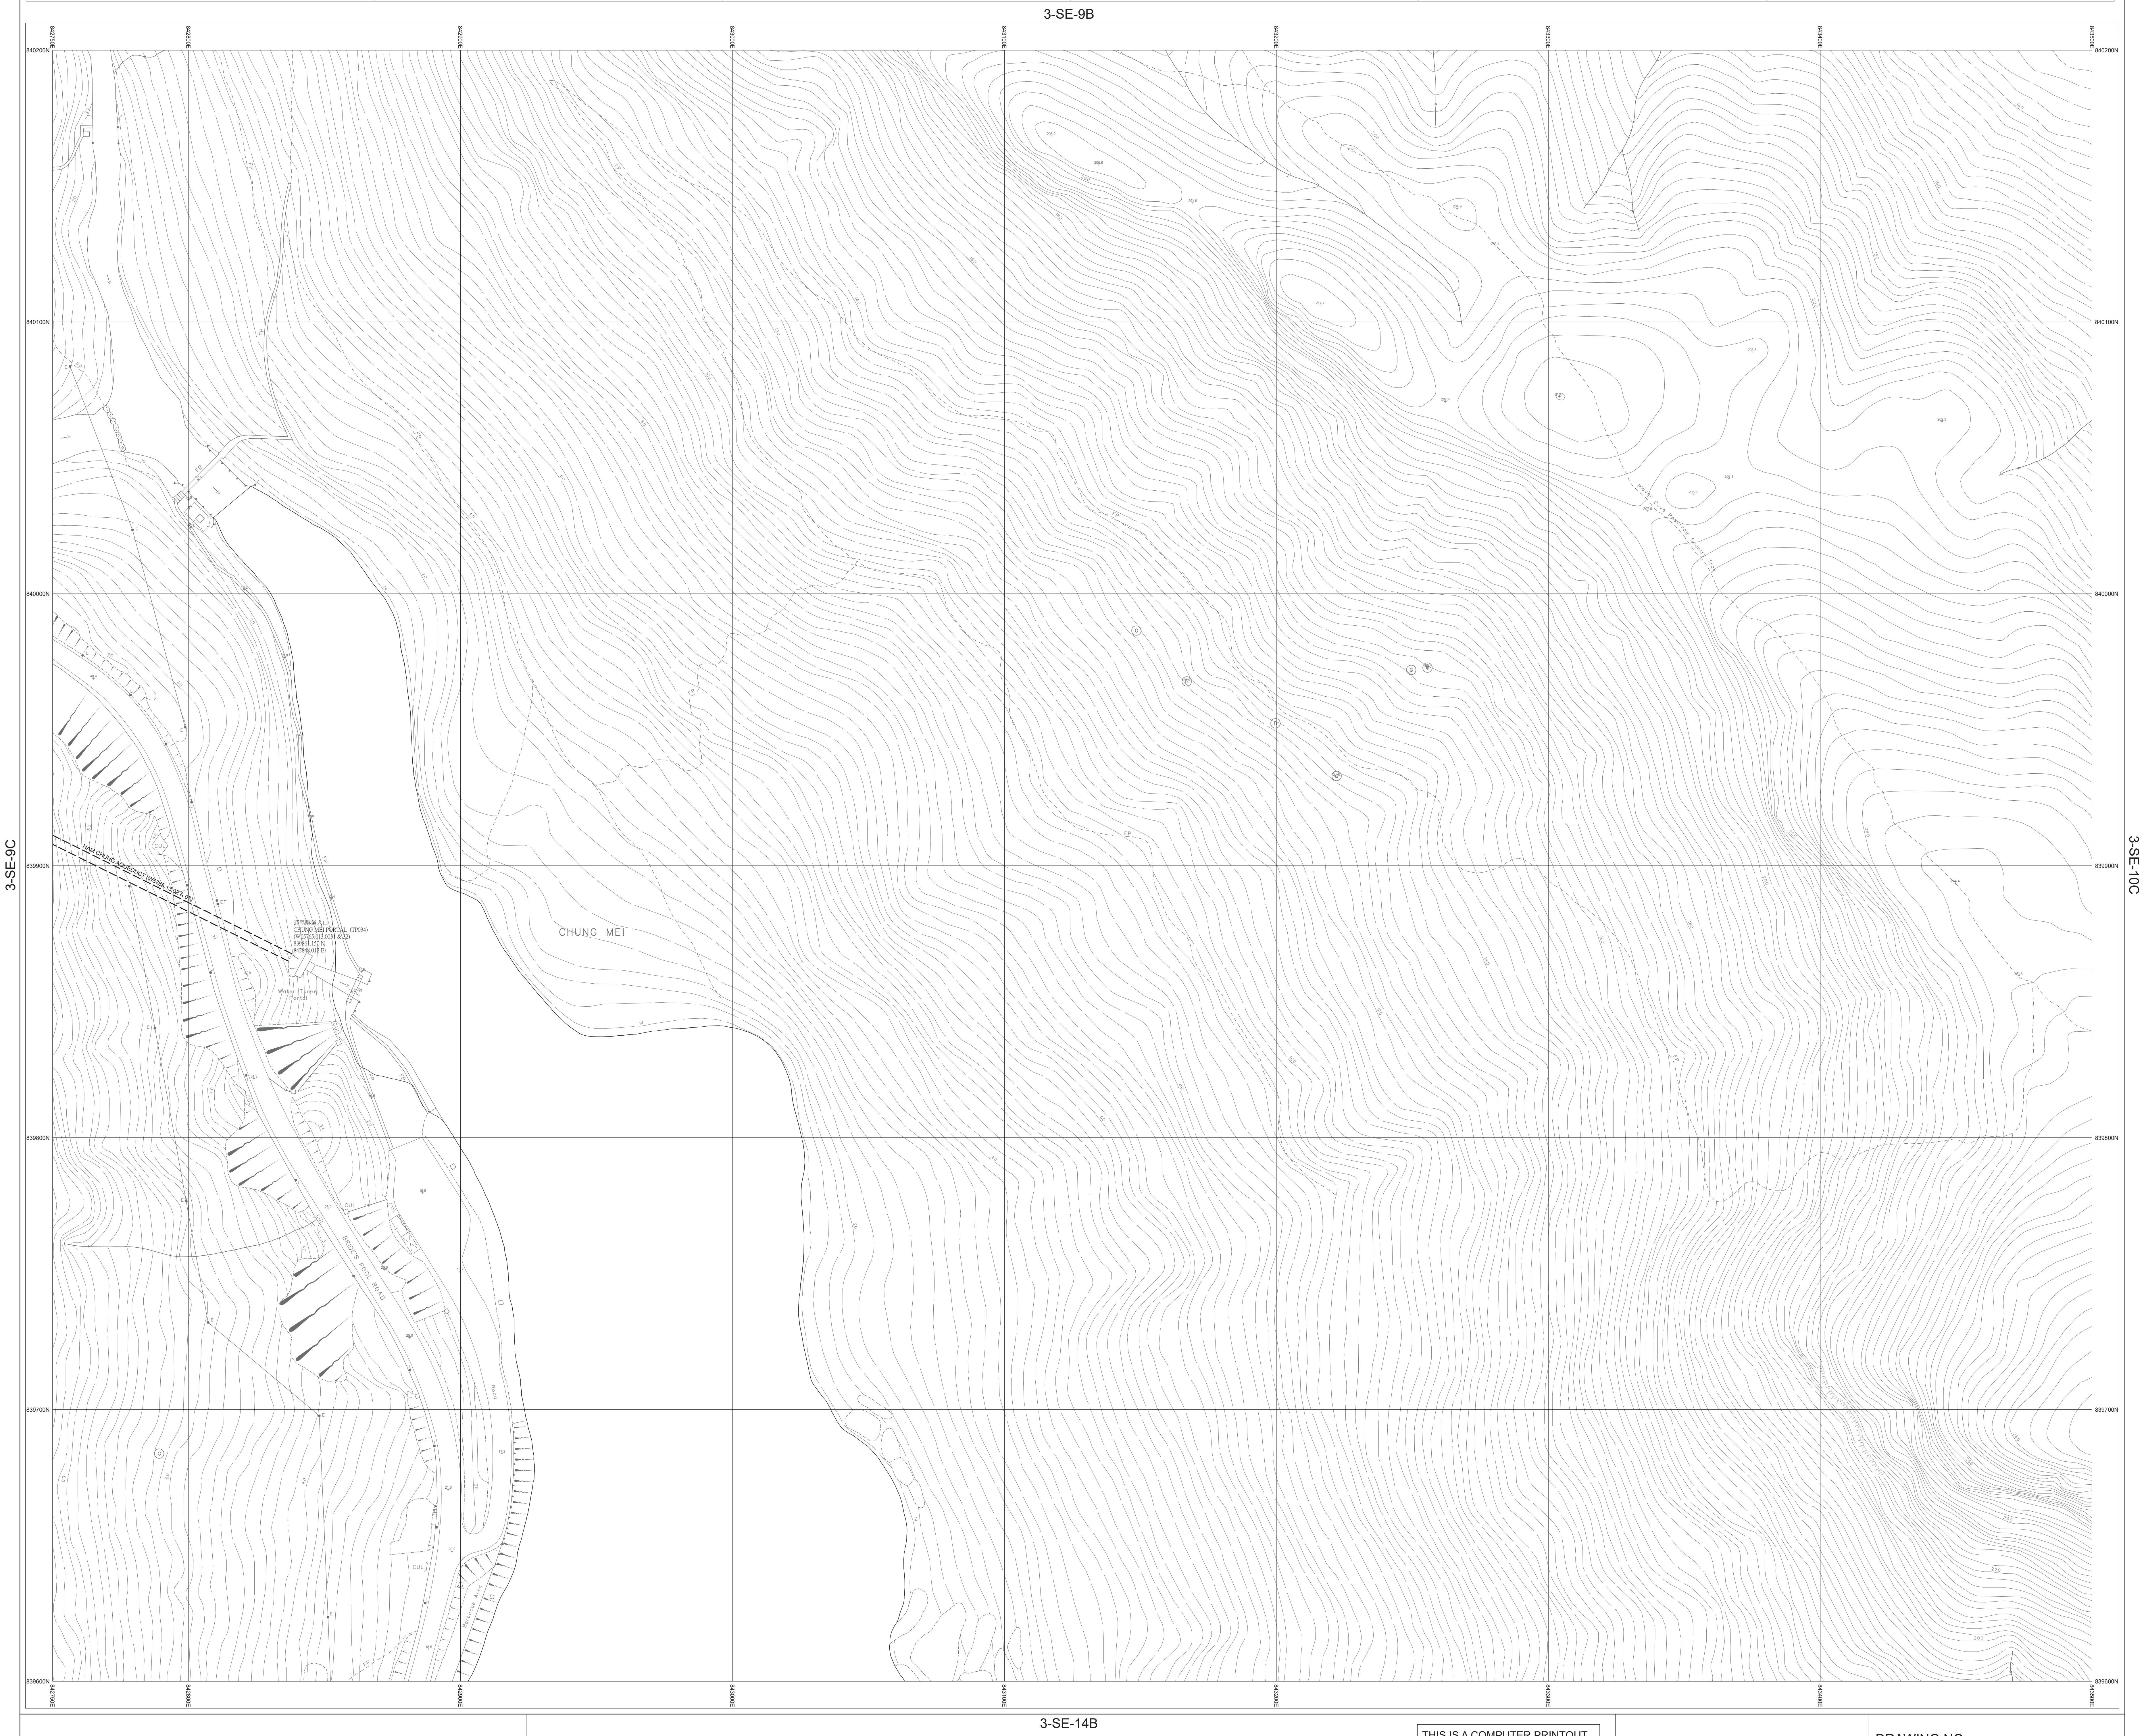
3-SE-9B
3-SE-9C
3-SE-10C
3-SE-14B
CHUNG MEI
NAM CHUNG AQUEDUCT (W5765.13.02 & 03)
涌尾隧道入口
CHUNG MEI PORTAL (TP034)
(W05765.013.0031 & 32)
839861.150 N
842848.012 E
Water Tunnel Portal
BRIDE'S POOL ROAD
Barbecue Area
CUL
FP
FB
839600N
839900N
842750E
842800E
842900E
843300E
843400E
843500E

NOTES:
1. FOR MAINS RECORDS SIGN CONVENTIONS AND DESIGNATIONS SEE SKETCH NO.3988.
2. DIMENSIONS OF MAINS ARE IN MILLIMETRES UNLESS OTHERWISE SPECIFIED.
3. ALL LEVELS ARE IN METRES ABOVE PRINCIPAL DATUM.

Basemap Date Updated On: 30/04/2019

SCALE 1:1 000

METRES 20 10 0 20 40 60 80 100 METRES

FRESH WATER MAINS RECORD PLAN

BRIDE'S POOL ROAD, CHUNG MEI

THIS IS A COMPUTER PRINTOUT,
NO SIGNATURE IS REQUIRED.

COPYRIGHT RESERVED

DATE REVISED : 19/04/2022

SIGNED
C.S. CHIN
CE/MNE
DATE: 09/11/1998

DRAWING NO.
W67880/ 3-SE-9D

Water Supplies Department
HONG KONG

© The Government of the Hong Kong SAR, Map reproduced with permission of the Director of Lands