INSET 'A'	INSET 'B'	INSET 'C'	INSET 'D'	INSET 'E'	INSET 'F'

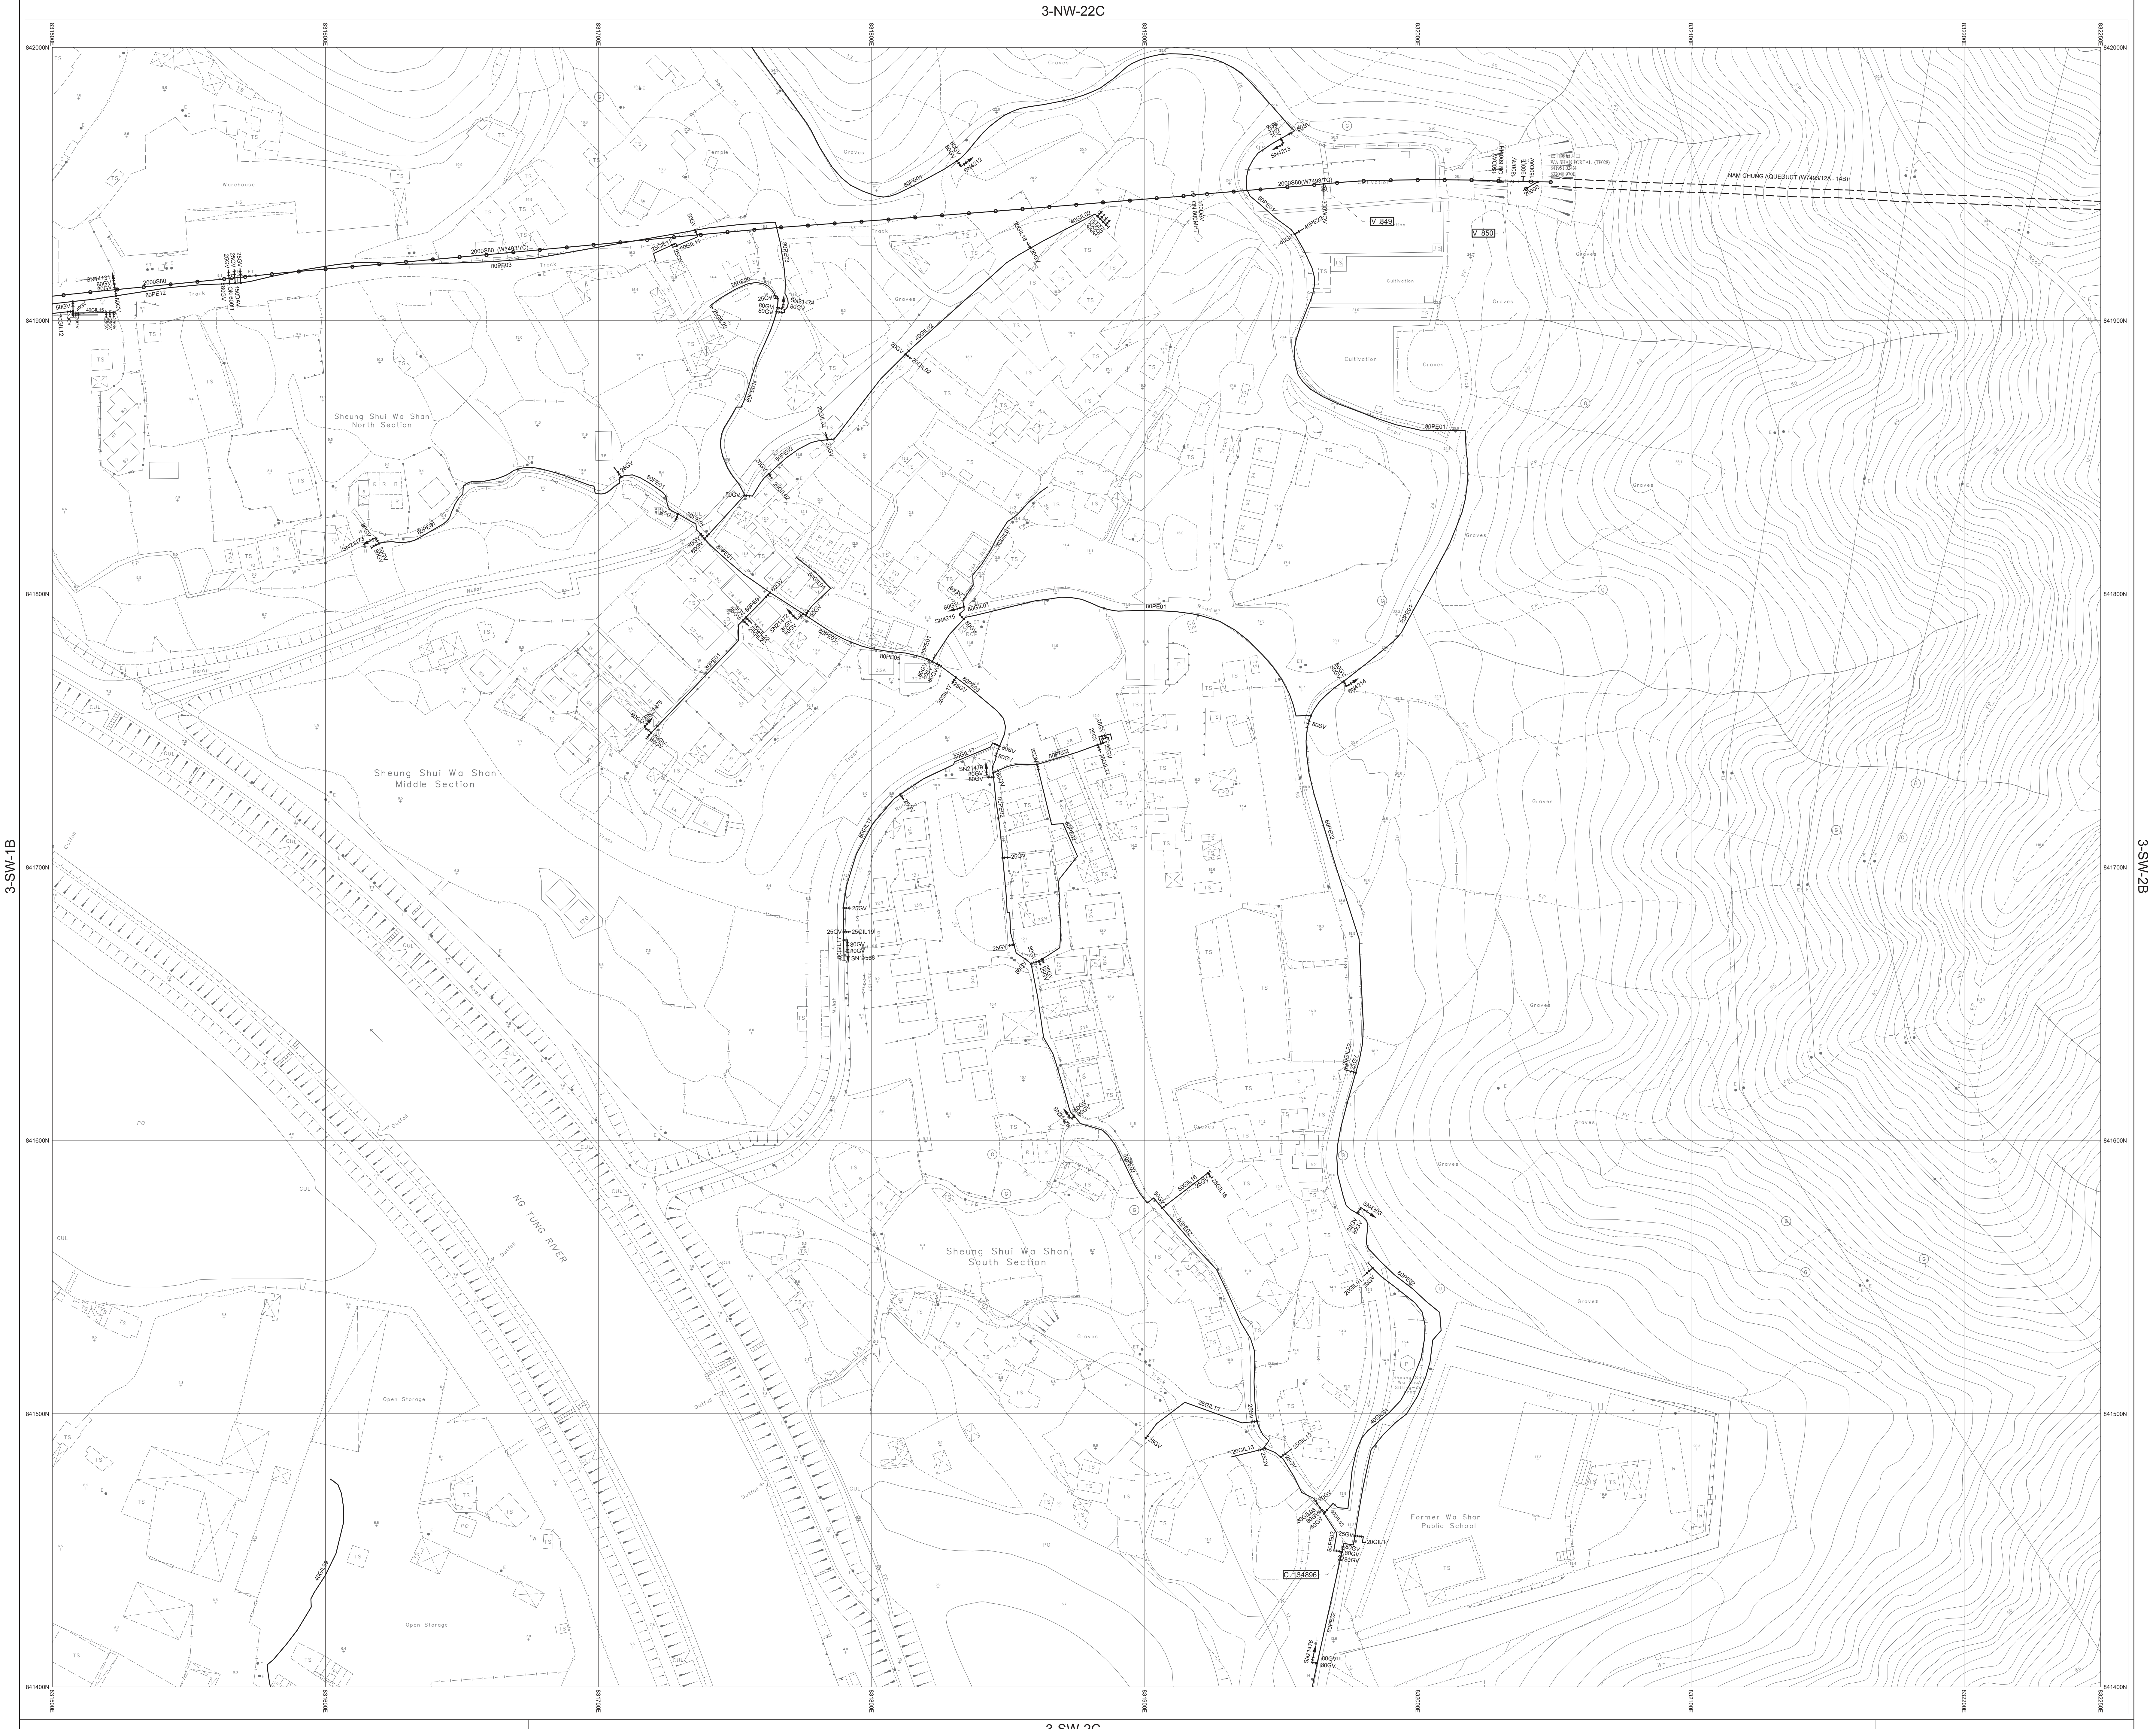
3-NW-22C
3-SW-1B
3-SW-2B
3-SW-2C
NAM CHUNG AQUEDUCT
Sheung Shui Wa Shan North Section
Sheung Shui Wa Shan Middle Section
Sheung Shui Wa Shan South Section
NG TUNG RIVER
Former Wa Shan Public School
Open Storage
831500E
831600E
831700E
841400N

NOTES:

1. FOR MAINS RECORDS SIGN CONVENTIONS AND DESIGNATIONS SEE SKETCH NO.3988.
2. DIMENSIONS OF MAINS ARE IN MILLIMETRES UNLESS OTHERWISE SPECIFIED.
3. ALL LEVELS ARE IN METRES ABOVE PRINCIPAL DATUM.

Basemap Date Updated On: 30/04/2019

SCALE 1:1 000

METRES 20 10 0 20 40 60 80 100 METRES

THIS IS A COMPUTER PRINTOUT, NO SIGNATURE IS REQUIRED.

FRESH WATER MAINS RECORD PLAN

NG TUNG HO, SHEUNG SHUI WA SHAN

COPYRIGHT RESERVED

DATE REVISED : 02/04/2024

DRAWING NO.

W67880/ 3-SW-2A

SIGNED C.S. CHIN
CE/MNE
DATE: 24/12/1998

Water Supplies Department
HONG KONG

© The Government of the Hong Kong SAR, Map reproduced with permission of the Director of Lands