INSET 'A'	INSET 'B'	INSET 'C'	INSET 'D'	INSET 'E'	INSET 'F'

3-SW-2A

3-SW-1D

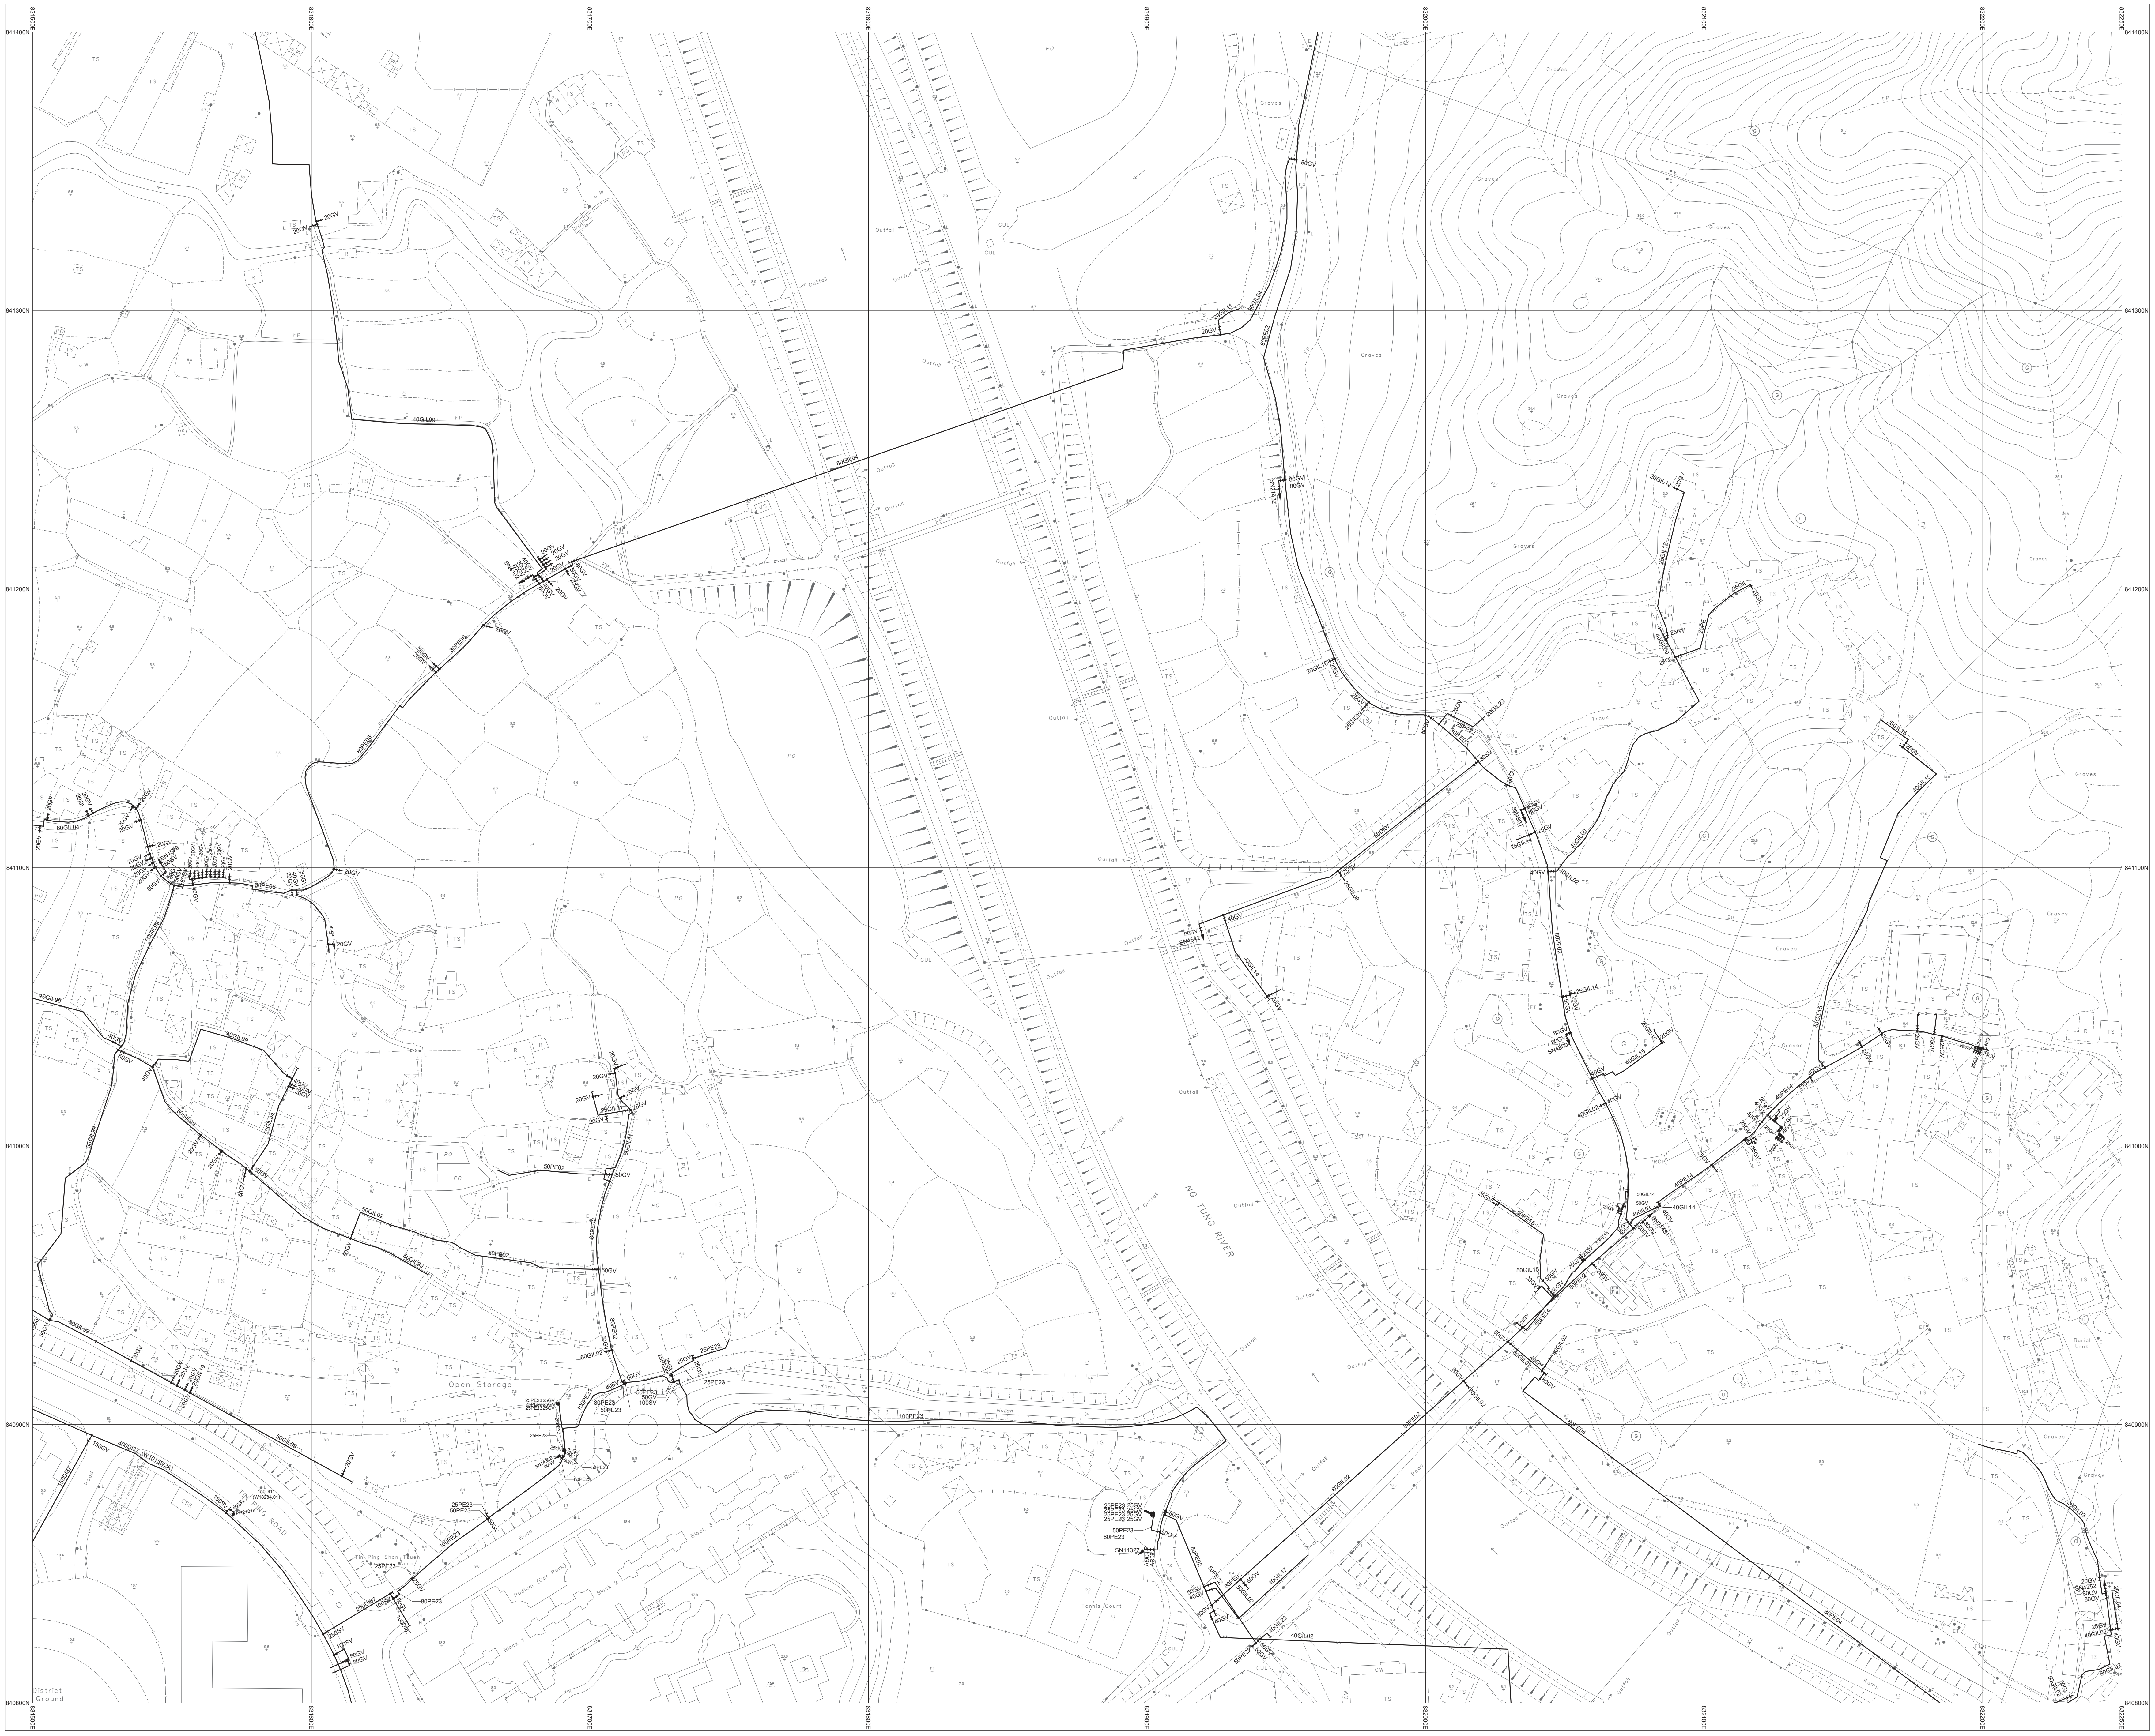
841400N
841300N
841200N
841100N
841000N
840900N
840800N
831500E
831600E
NG TUNG RIVER
Open Storage
District Ground
Graves
Outfall
250DI87
100SV
80GV
80PE23
100DI87
250SV
Block 1
Podium

3-SW-2D

3-SW-7A

NOTES:

1. FOR MAINS RECORDS SIGN CONVENTIONS AND DESIGNATIONS SEE SKETCH NO.3988.
2. DIMENSIONS OF MAINS ARE IN MILLIMETRES UNLESS OTHERWISE SPECIFIED.
3. ALL LEVELS ARE IN METRES ABOVE PRINCIPAL DATUM.

Basemap Date Updated On: 30/04/2019

SCALE 1:1 000

METRES 20 10 0 20 40 60 80 100 METRES

THIS IS A COMPUTER PRINTOUT,
NO SIGNATURE IS REQUIRED.

FRESH WATER MAINS RECORD PLAN

NG TUNG HO, TIN PING SHAN

COPYRIGHT RESERVED

DATE REVISED : 02/07/2024

DRAWING NO.
W67880/ 3-SW-2C

SIGNED
C.S. CHIN
CE/MNE
DATE: 24/12/1998

Water Supplies Department
HONG KONG

© The Government of the Hong Kong SAR, Map reproduced with permission of the Director of Lands