| INSET 'A' | INSET 'B' | INSET 'C' | INSET 'D' | INSET 'E' | INSET 'F' |
|---|---|---|---|---|---|

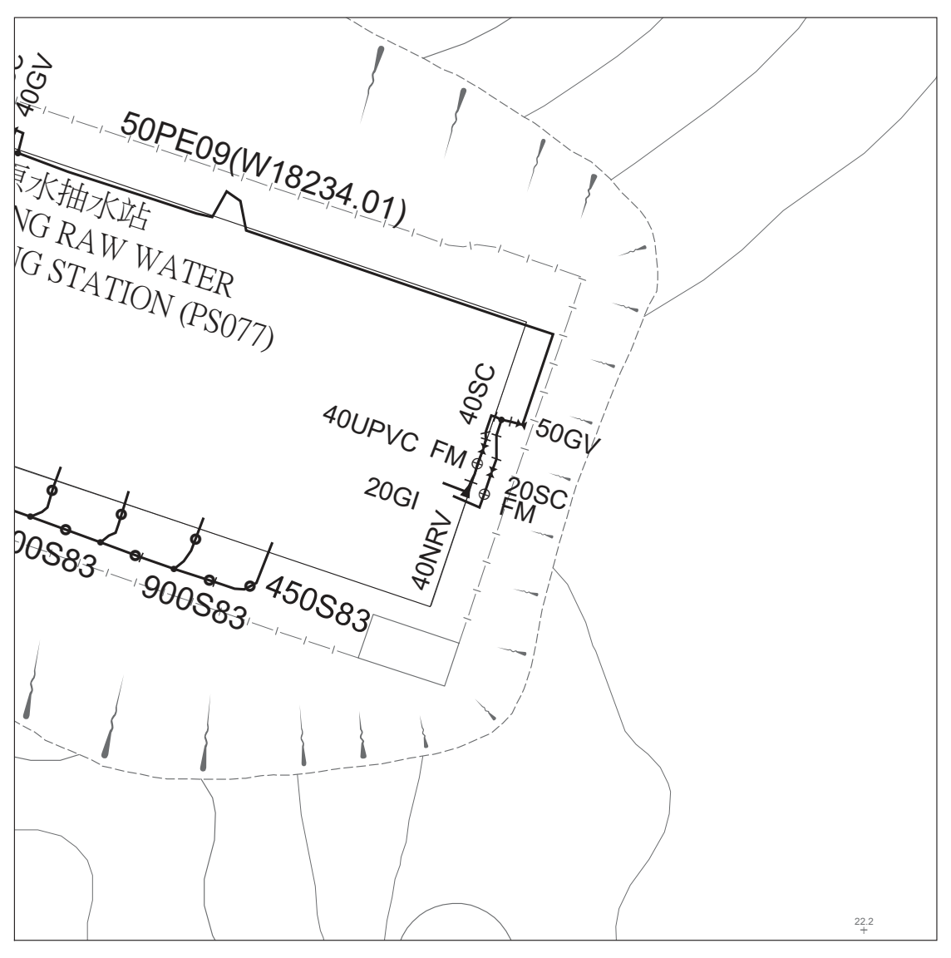
40GV
50PE09(W18234.01)
NG RAW WATER
G STATION (PS077)
40SC
40UPVC FM
50GV
20GI
20SC FM
40NRV
00S83
900S83
450S83

Scale 1:500

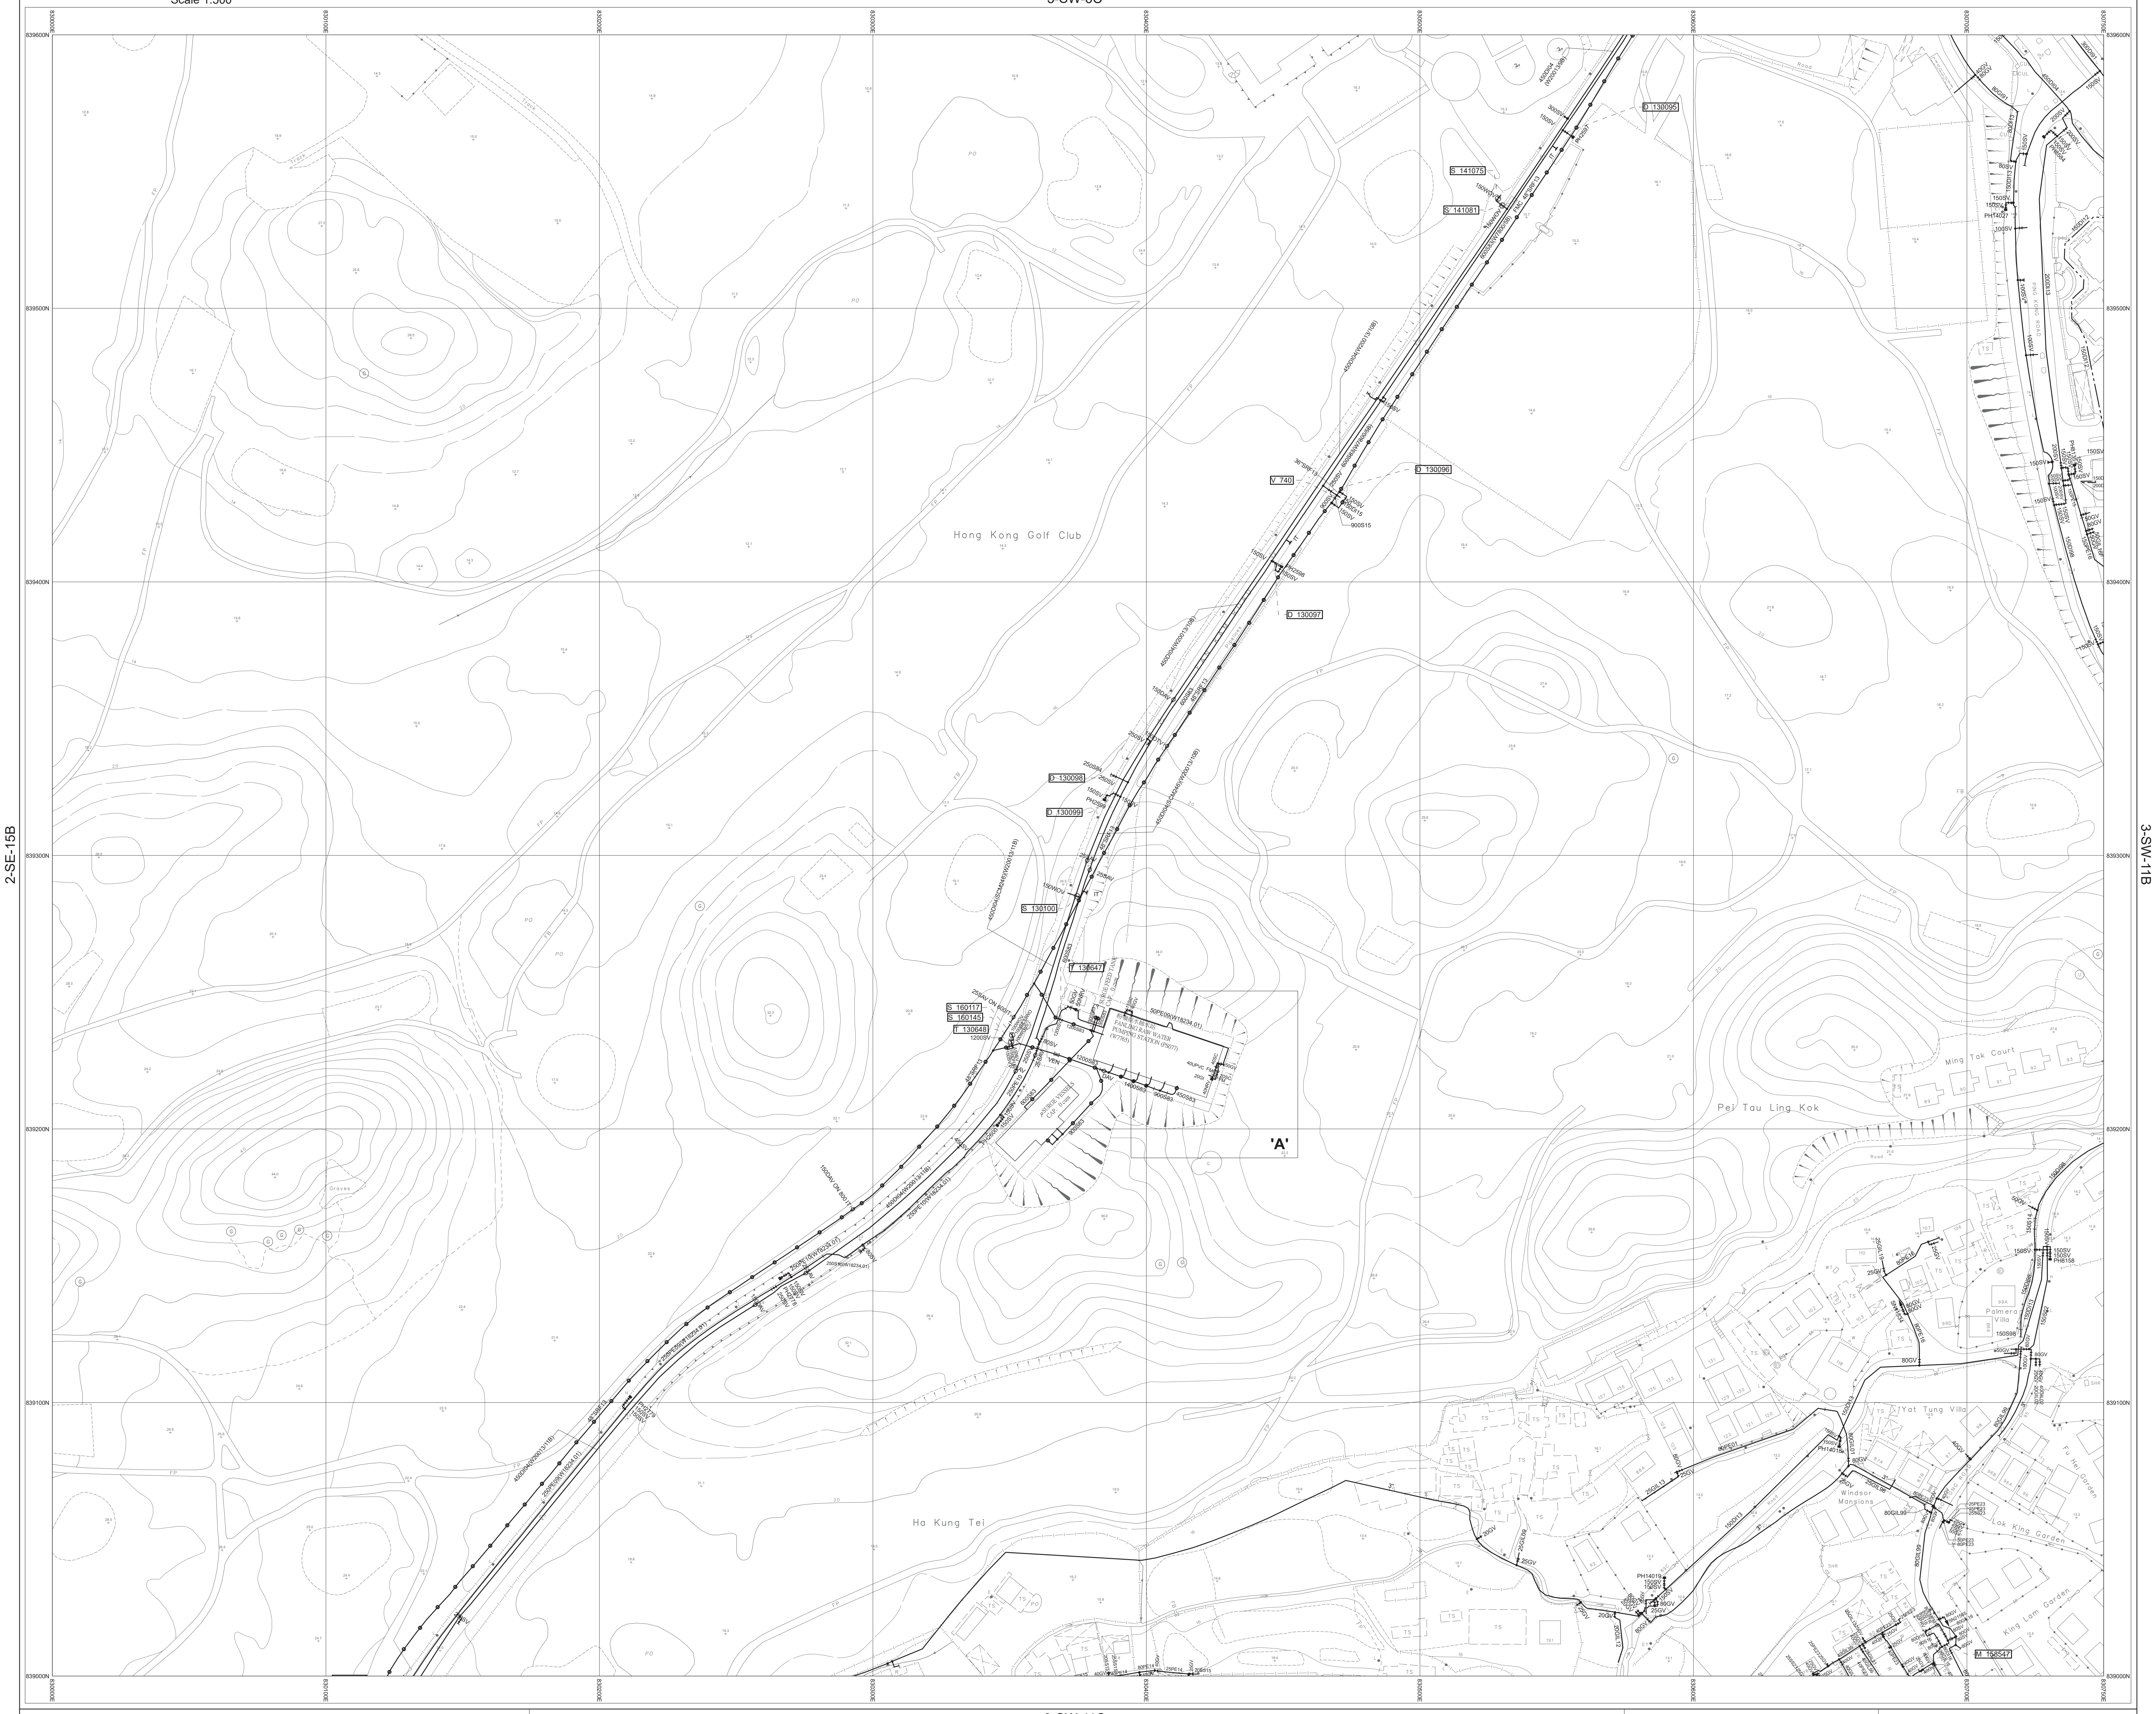
3-SW-6C
2-SE-15B
3-SW-11B
Hong Kong Golf Club
Ha Kung Tei
Pei Tau Ling Kok
Ming Tak Court
'A'
3-SW-11C

THIS IS A COMPUTER PRINTOUT,
NO SIGNATURE IS REQUIRED.

NOTES:
1. FOR MAINS RECORDS SIGN CONVENTIONS AND DESIGNATIONS SEE SKETCH NO.3988.
2. DIMENSIONS OF MAINS ARE IN MILLIMETRES UNLESS OTHERWISE SPECIFIED.
3. ALL LEVELS ARE IN METRES ABOVE PRINCIPAL DATUM.

Basemap Date Updated On: 30/04/2019

SCALE 1:1 000

METRES 20 10 0 20 40 60 80 100 METRES

# FRESH WATER MAINS RECORD PLAN

## GOLF COURSE, HA KUNG TEI

COPYRIGHT RESERVED

DATE REVISED : 02/07/2024

DRAWING NO.
W67880/ 3-SW-11A

SIGNED
C.S. CHIN
CE/MNE
DATE: 24/12/1998

Water Supplies Department
HONG KONG

© The Government of the Hong Kong SAR, Map reproduced with permission of the Director of Lands