INSET 'A'

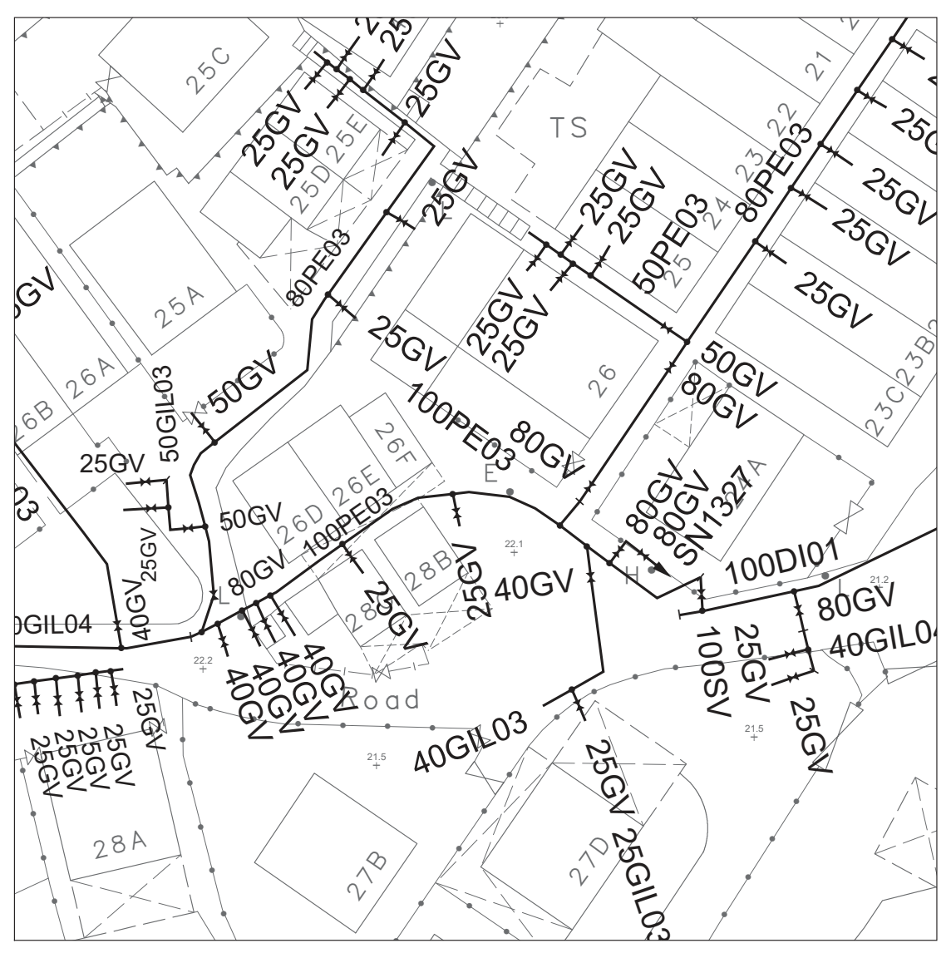
25GV
50GV
80PE03
100PE03
40GV
100DI01
80GV
40GIL04
100SV
40GIL03
25GIL03

Scale 1:500

INSET 'B'

INSET 'C'

INSET 'D'

INSET 'E'

INSET 'F'

3-SW-18A

3-SW-17D

3-SW-18D

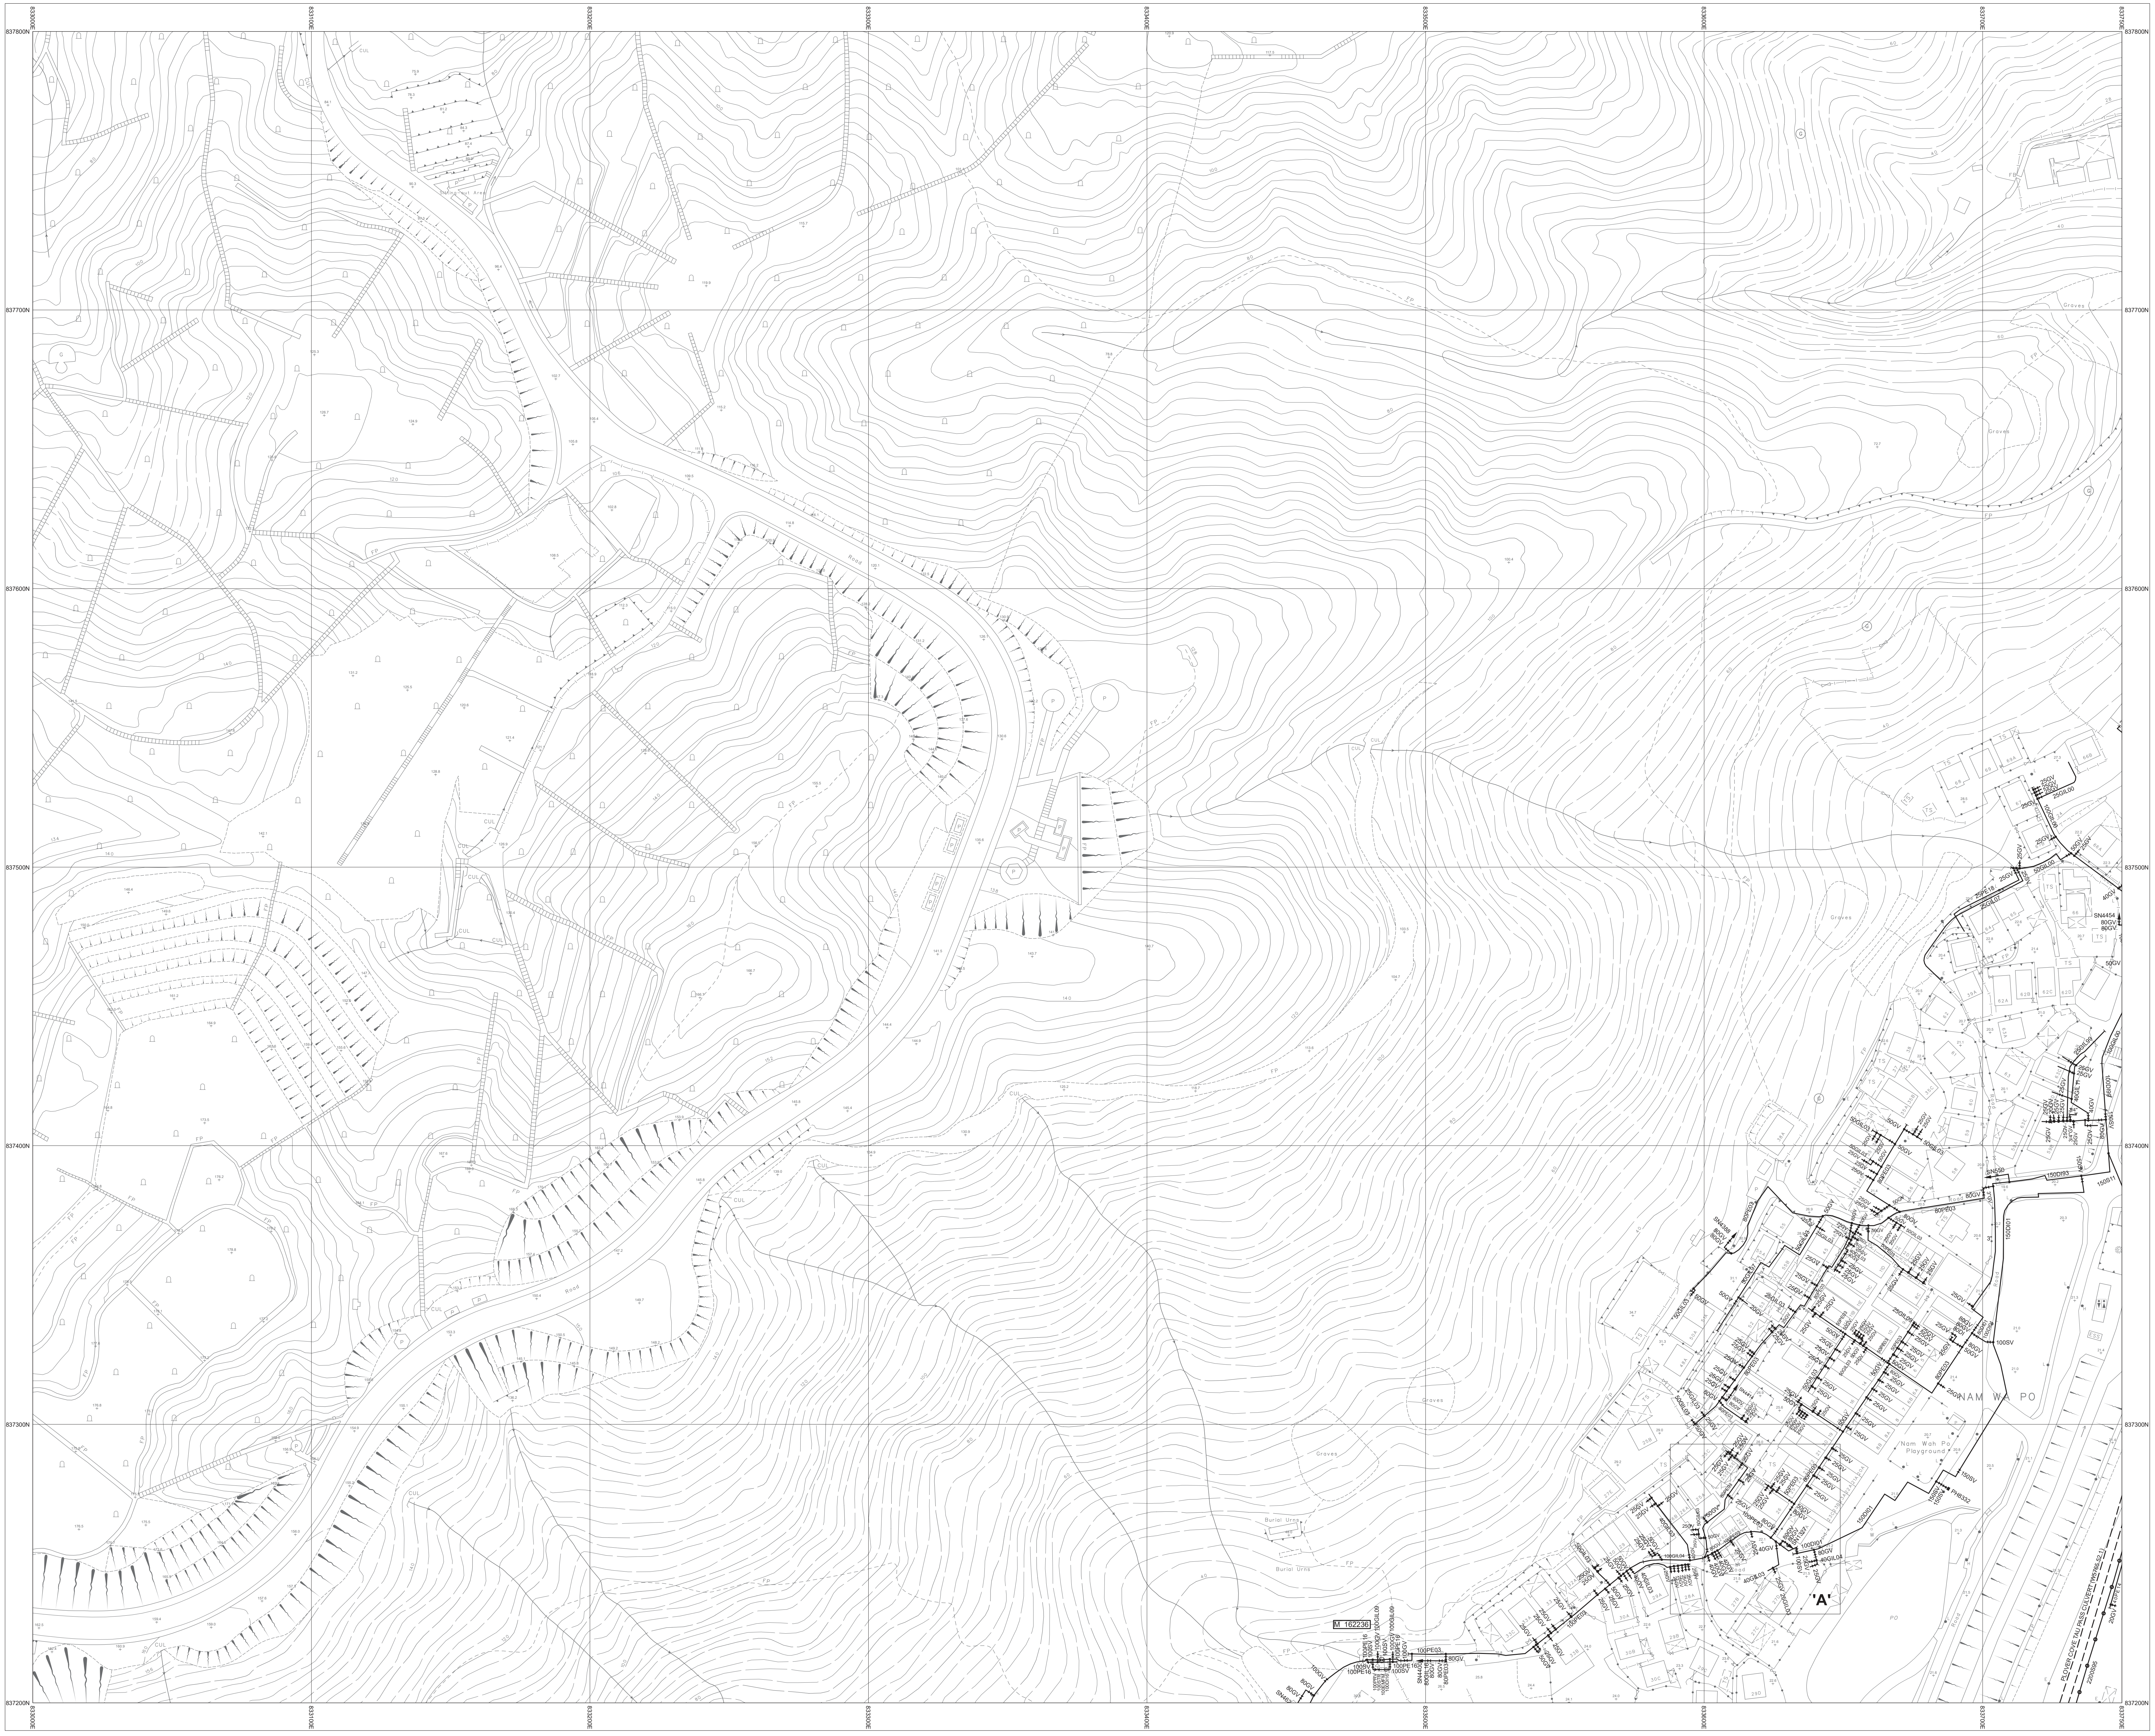
NAM WA PO
'A'
M 162236

3-SW-23A

NOTES:

1. FOR MAINS RECORDS SIGN CONVENTIONS AND DESIGNATIONS SEE SKETCH NO.3988.
2. DIMENSIONS OF MAINS ARE IN MILLIMETRES UNLESS OTHERWISE SPECIFIED.
3. ALL LEVELS ARE IN METRES ABOVE PRINCIPAL DATUM.

Basemap Date Updated On: 11/04/2023

SCALE 1:1 000

METRES 20 10 0 20 40 60 80 100 METRES

THIS IS A COMPUTER PRINTOUT,
NO SIGNATURE IS REQUIRED.

# FRESH WATER MAINS RECORD PLAN

## NAM WA PO, WO HOP SHEK

COPYRIGHT RESERVED

DATE REVISED : 03/10/2024

DRAWING NO.

W67880/ 3-SW-18C

SIGNED C.S. CHIN
CE/MNE
DATE: 24/12/1998

Water Supplies Department
HONG KONG

© The Government of the Hong Kong SAR, Map reproduced with permission of the Director of Lands