INSET 'A'

INSET 'B'

INSET 'C'

INSET 'D'

INSET 'E'

INSET 'F'

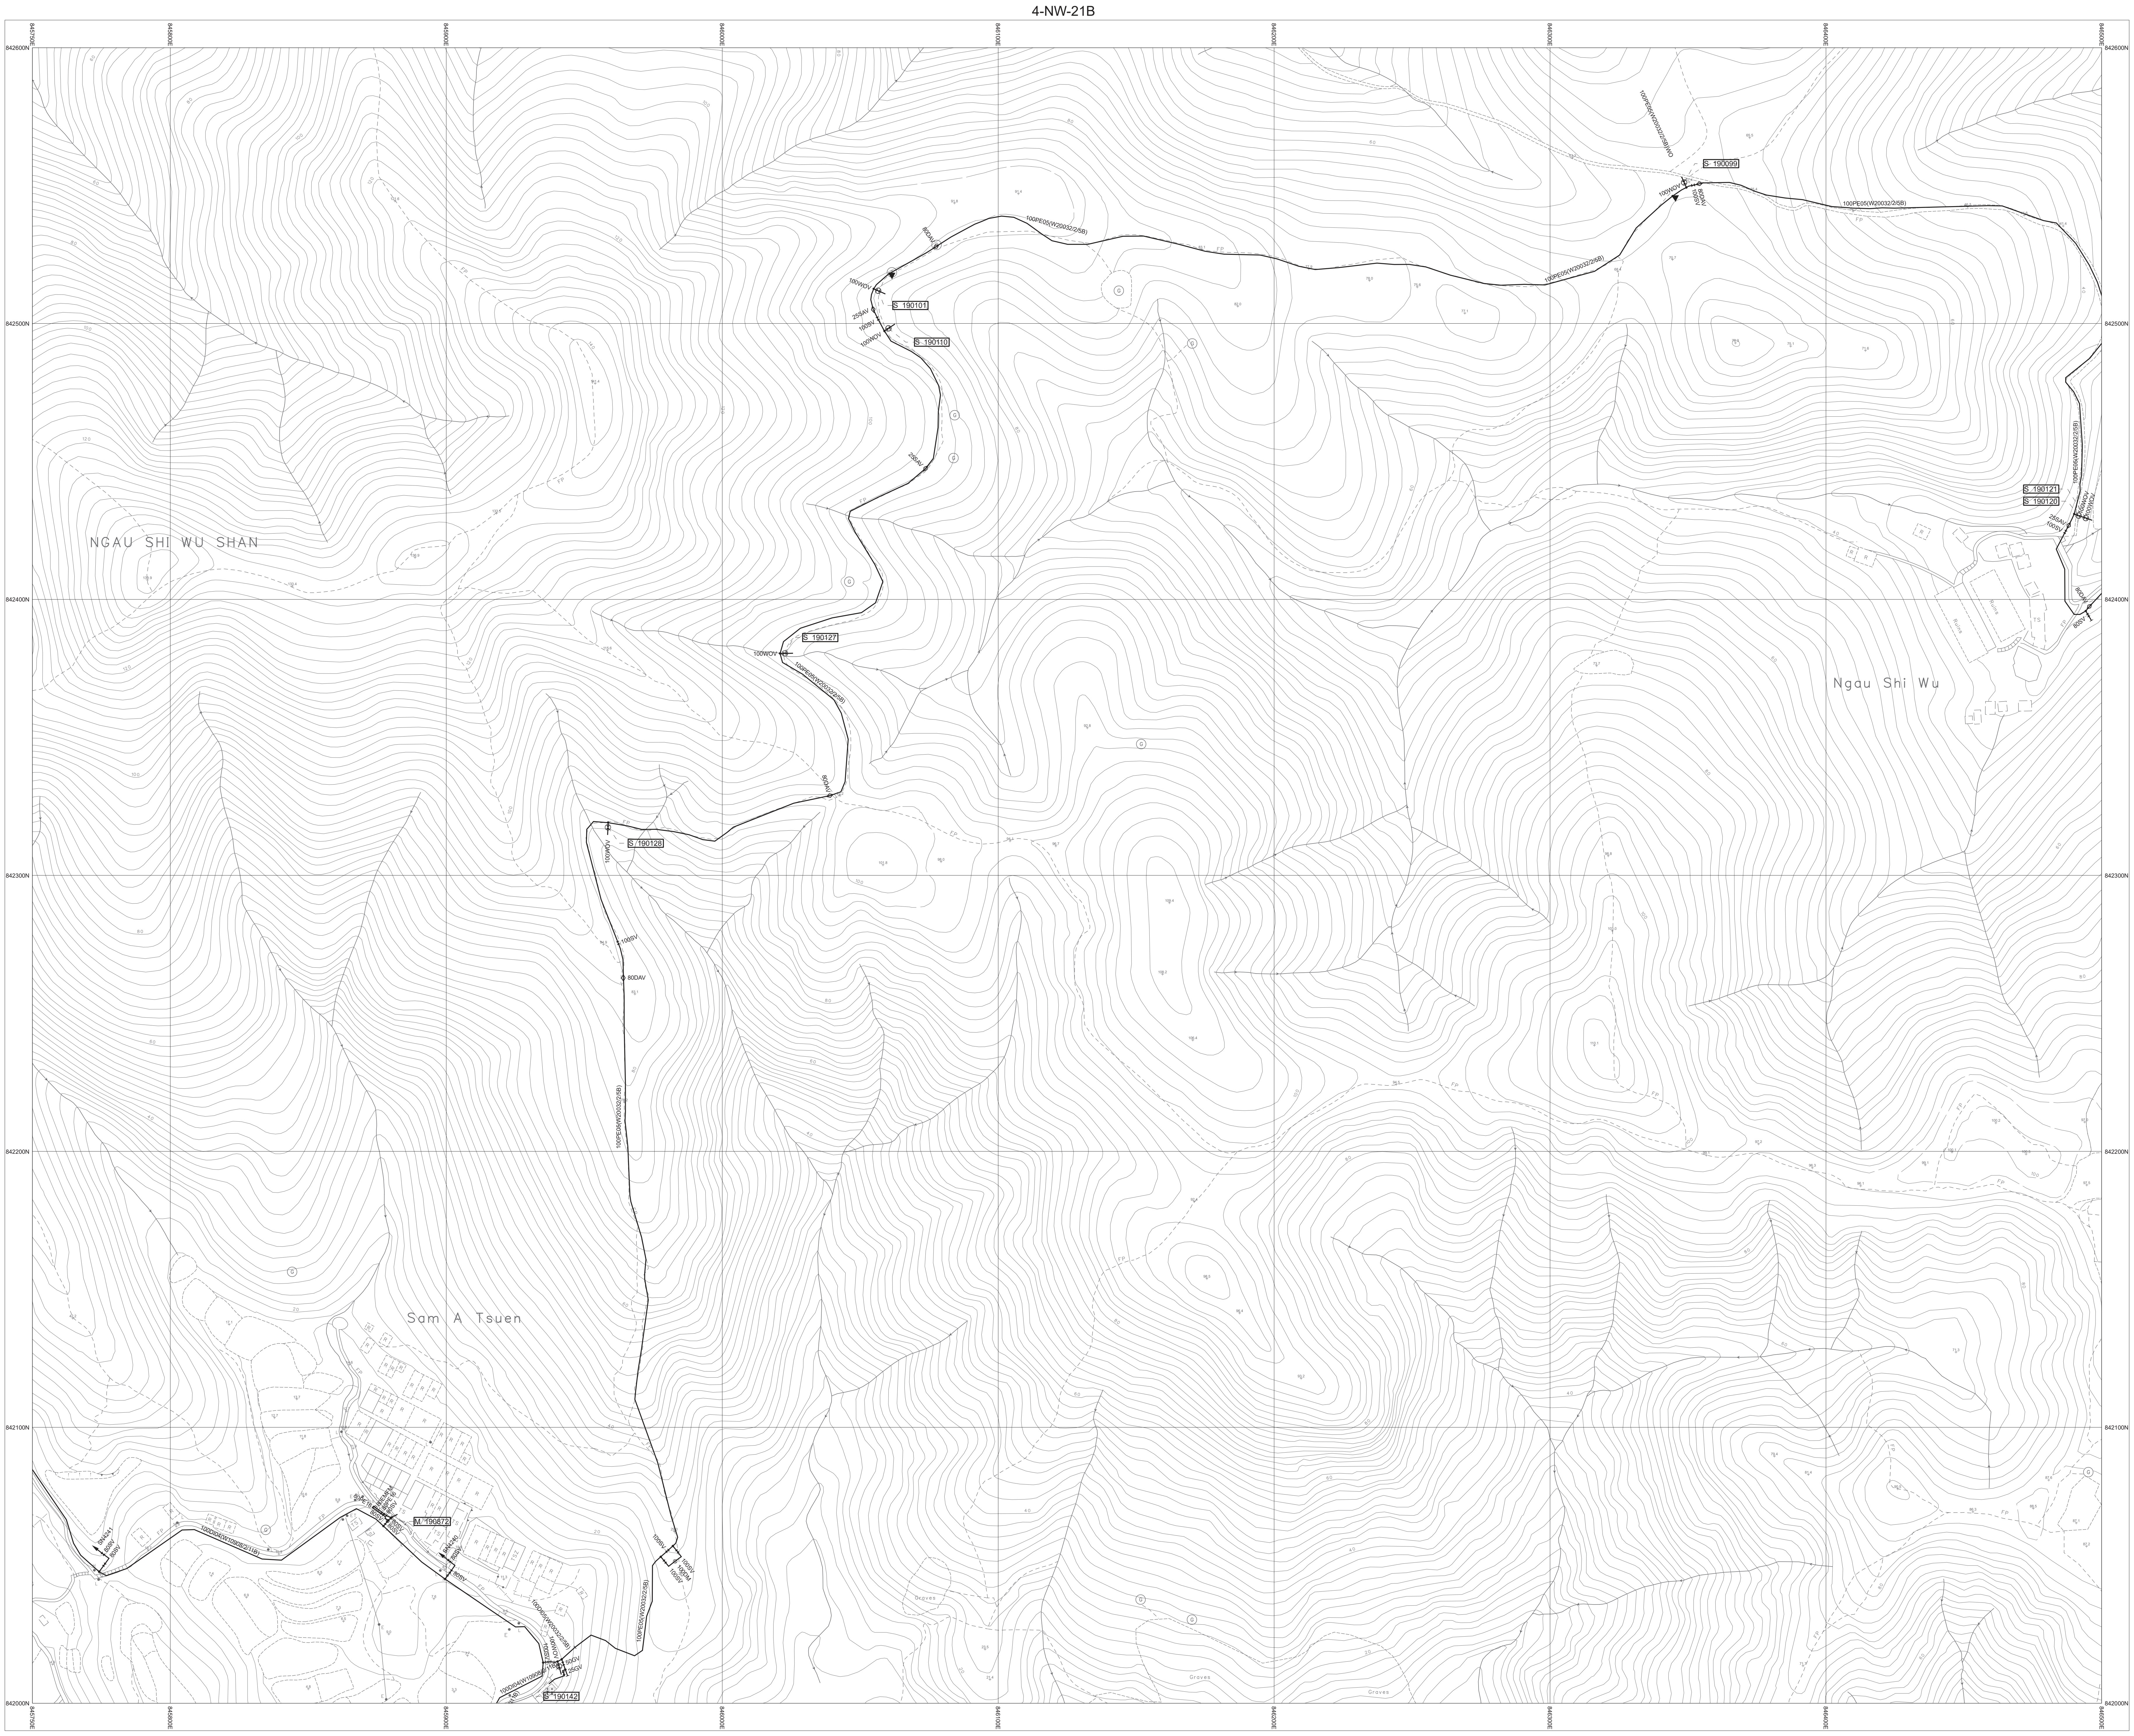

NOTES:

1. FOR MAINS RECORDS SIGN CONVENTIONS AND DESIGNATIONS SEE SKETCH NO.3988.
2. DIMENSIONS OF MAINS ARE IN MILLIMETRES UNLESS OTHERWISE SPECIFIED.
3. ALL LEVELS ARE IN METRES ABOVE PRINCIPAL DATUM.

Basemap Date Updated On: 30/04/2019

SCALE 1:1 000

METRES 20 10 0 20 40 60 80 100 METRES

THIS IS A COMPUTER PRINTOUT,
NO SIGNATURE IS REQUIRED.

# FRESH WATER MAINS RECORD PLAN

SAM A TSUEN, NGAU SHI WU

COPYRIGHT RESERVED

DATE REVISED : 19/04/2022

DRAWING NO.
W67880/ 4-NW-21D

SIGNED
C.S. CHIN
CE/MNE
DATE: 30/07/2001

Water Supplies Department
HONG KONG

© The Government of the Hong Kong SAR, Map reproduced with permission of the Director of Lands