INSET 'A'

INSET 'B'

INSET 'C'

INSET 'D'

INSET 'E'

INSET 'F'

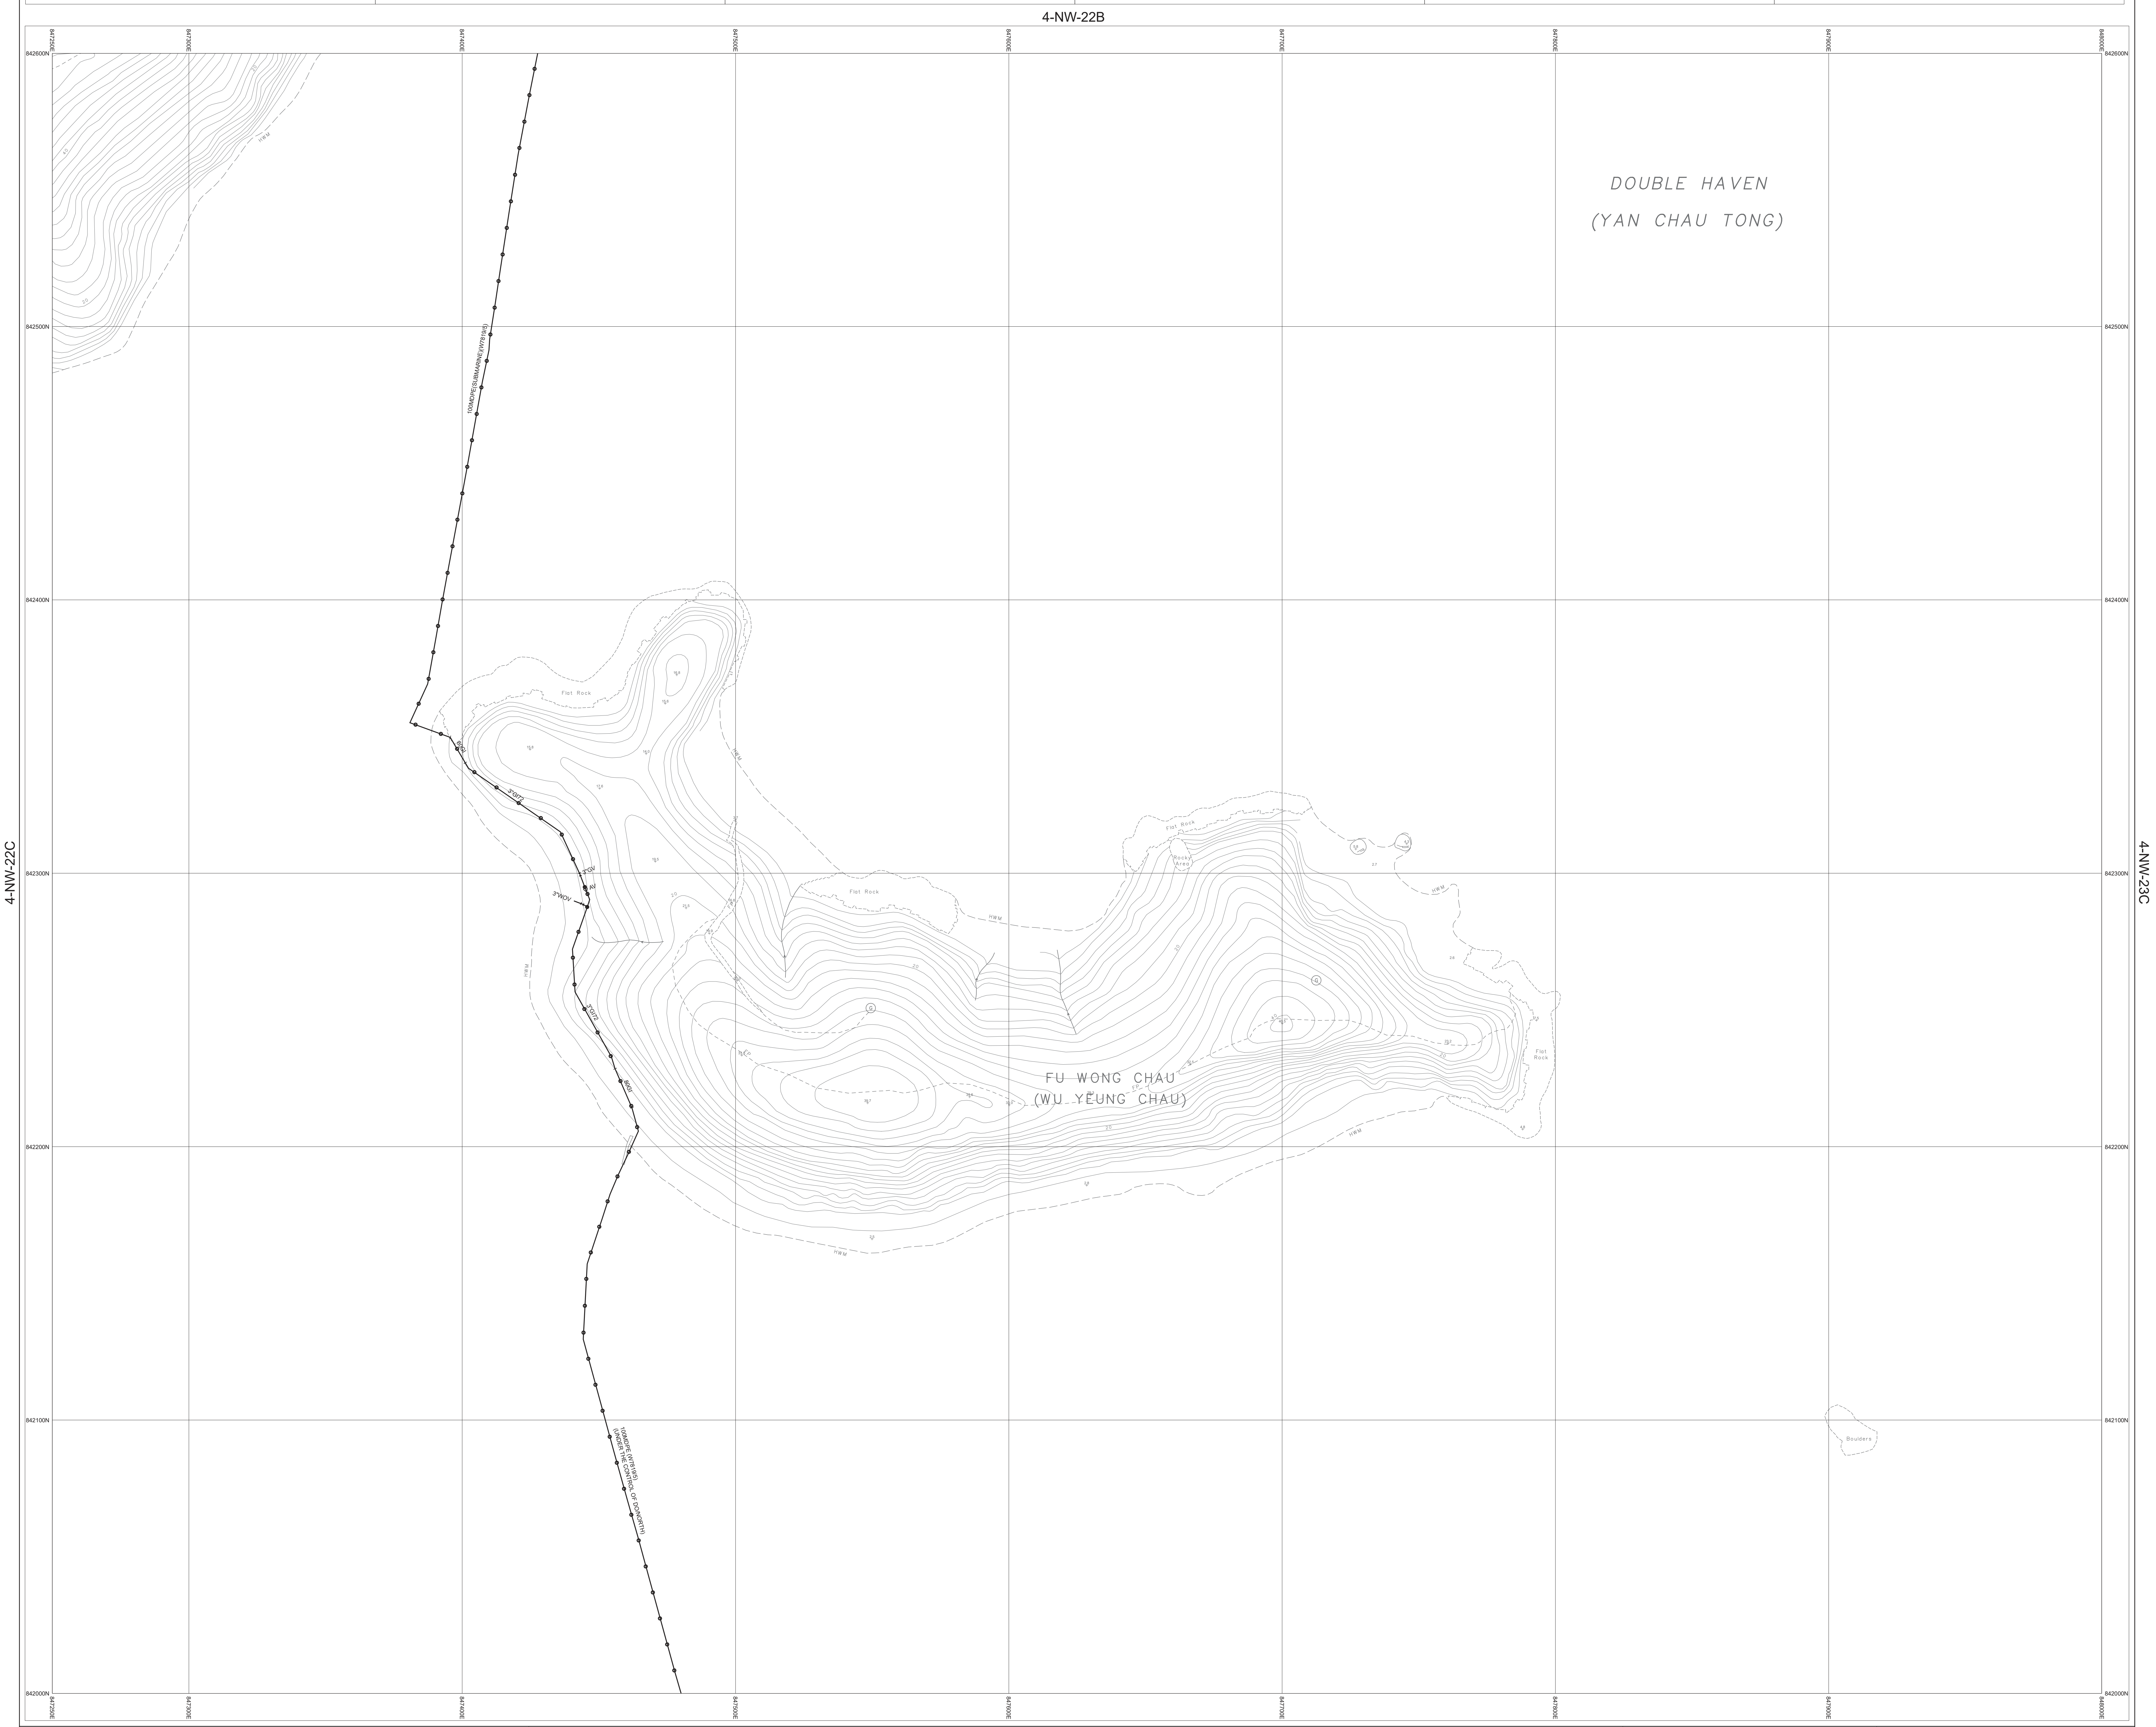
4-NW-22B
4-NW-22C
4-NW-23C
4-SW-2B
DOUBLE HAVEN
(YAN CHAU TONG)
FU WONG CHAU
(WU YEUNG CHAU)
100MDPE(SUBMARINE)(W7819/5)
100MDPE (W7819/5)
(UNDER THE CONTROL OF DO/NORTH)
Flat Rock
Boulders
842600N
842500N
842400N
842300N
842200N
842100N
842000N
847250E
847300E
847400E
847500E
847600E
847700E
847800E
847900E
848000E

NOTES:

1. FOR MAINS RECORDS SIGN CONVENTIONS AND DESIGNATIONS SEE SKETCH NO.3988.
2. DIMENSIONS OF MAINS ARE IN MILLIMETRES UNLESS OTHERWISE SPECIFIED.
3. ALL LEVELS ARE IN METRES ABOVE PRINCIPAL DATUM.

Basemap Date Updated On: 30/04/2019

SCALE 1:1 000

METRES 20 10 0 20 40 60 80 100 METRES

THIS IS A COMPUTER PRINTOUT,
NO SIGNATURE IS REQUIRED.

FRESH WATER MAINS RECORD PLAN

FU WONG CHAU, YAN CHAU TONG

COPYRIGHT RESERVED

DATE REVISED : 19/04/2022

DRAWING NO.

W67880/ 4-NW-22D

SIGNED

C.S. CHIN
CE/MNE

DATE: 09/11/1998

Water Supplies Department
HONG KONG

© The Government of the Hong Kong SAR, Map reproduced with permission of the Director of Lands