INSET 'A'	INSET 'B'	INSET 'C'	INSET 'D'	INSET 'E'	INSET 'F'

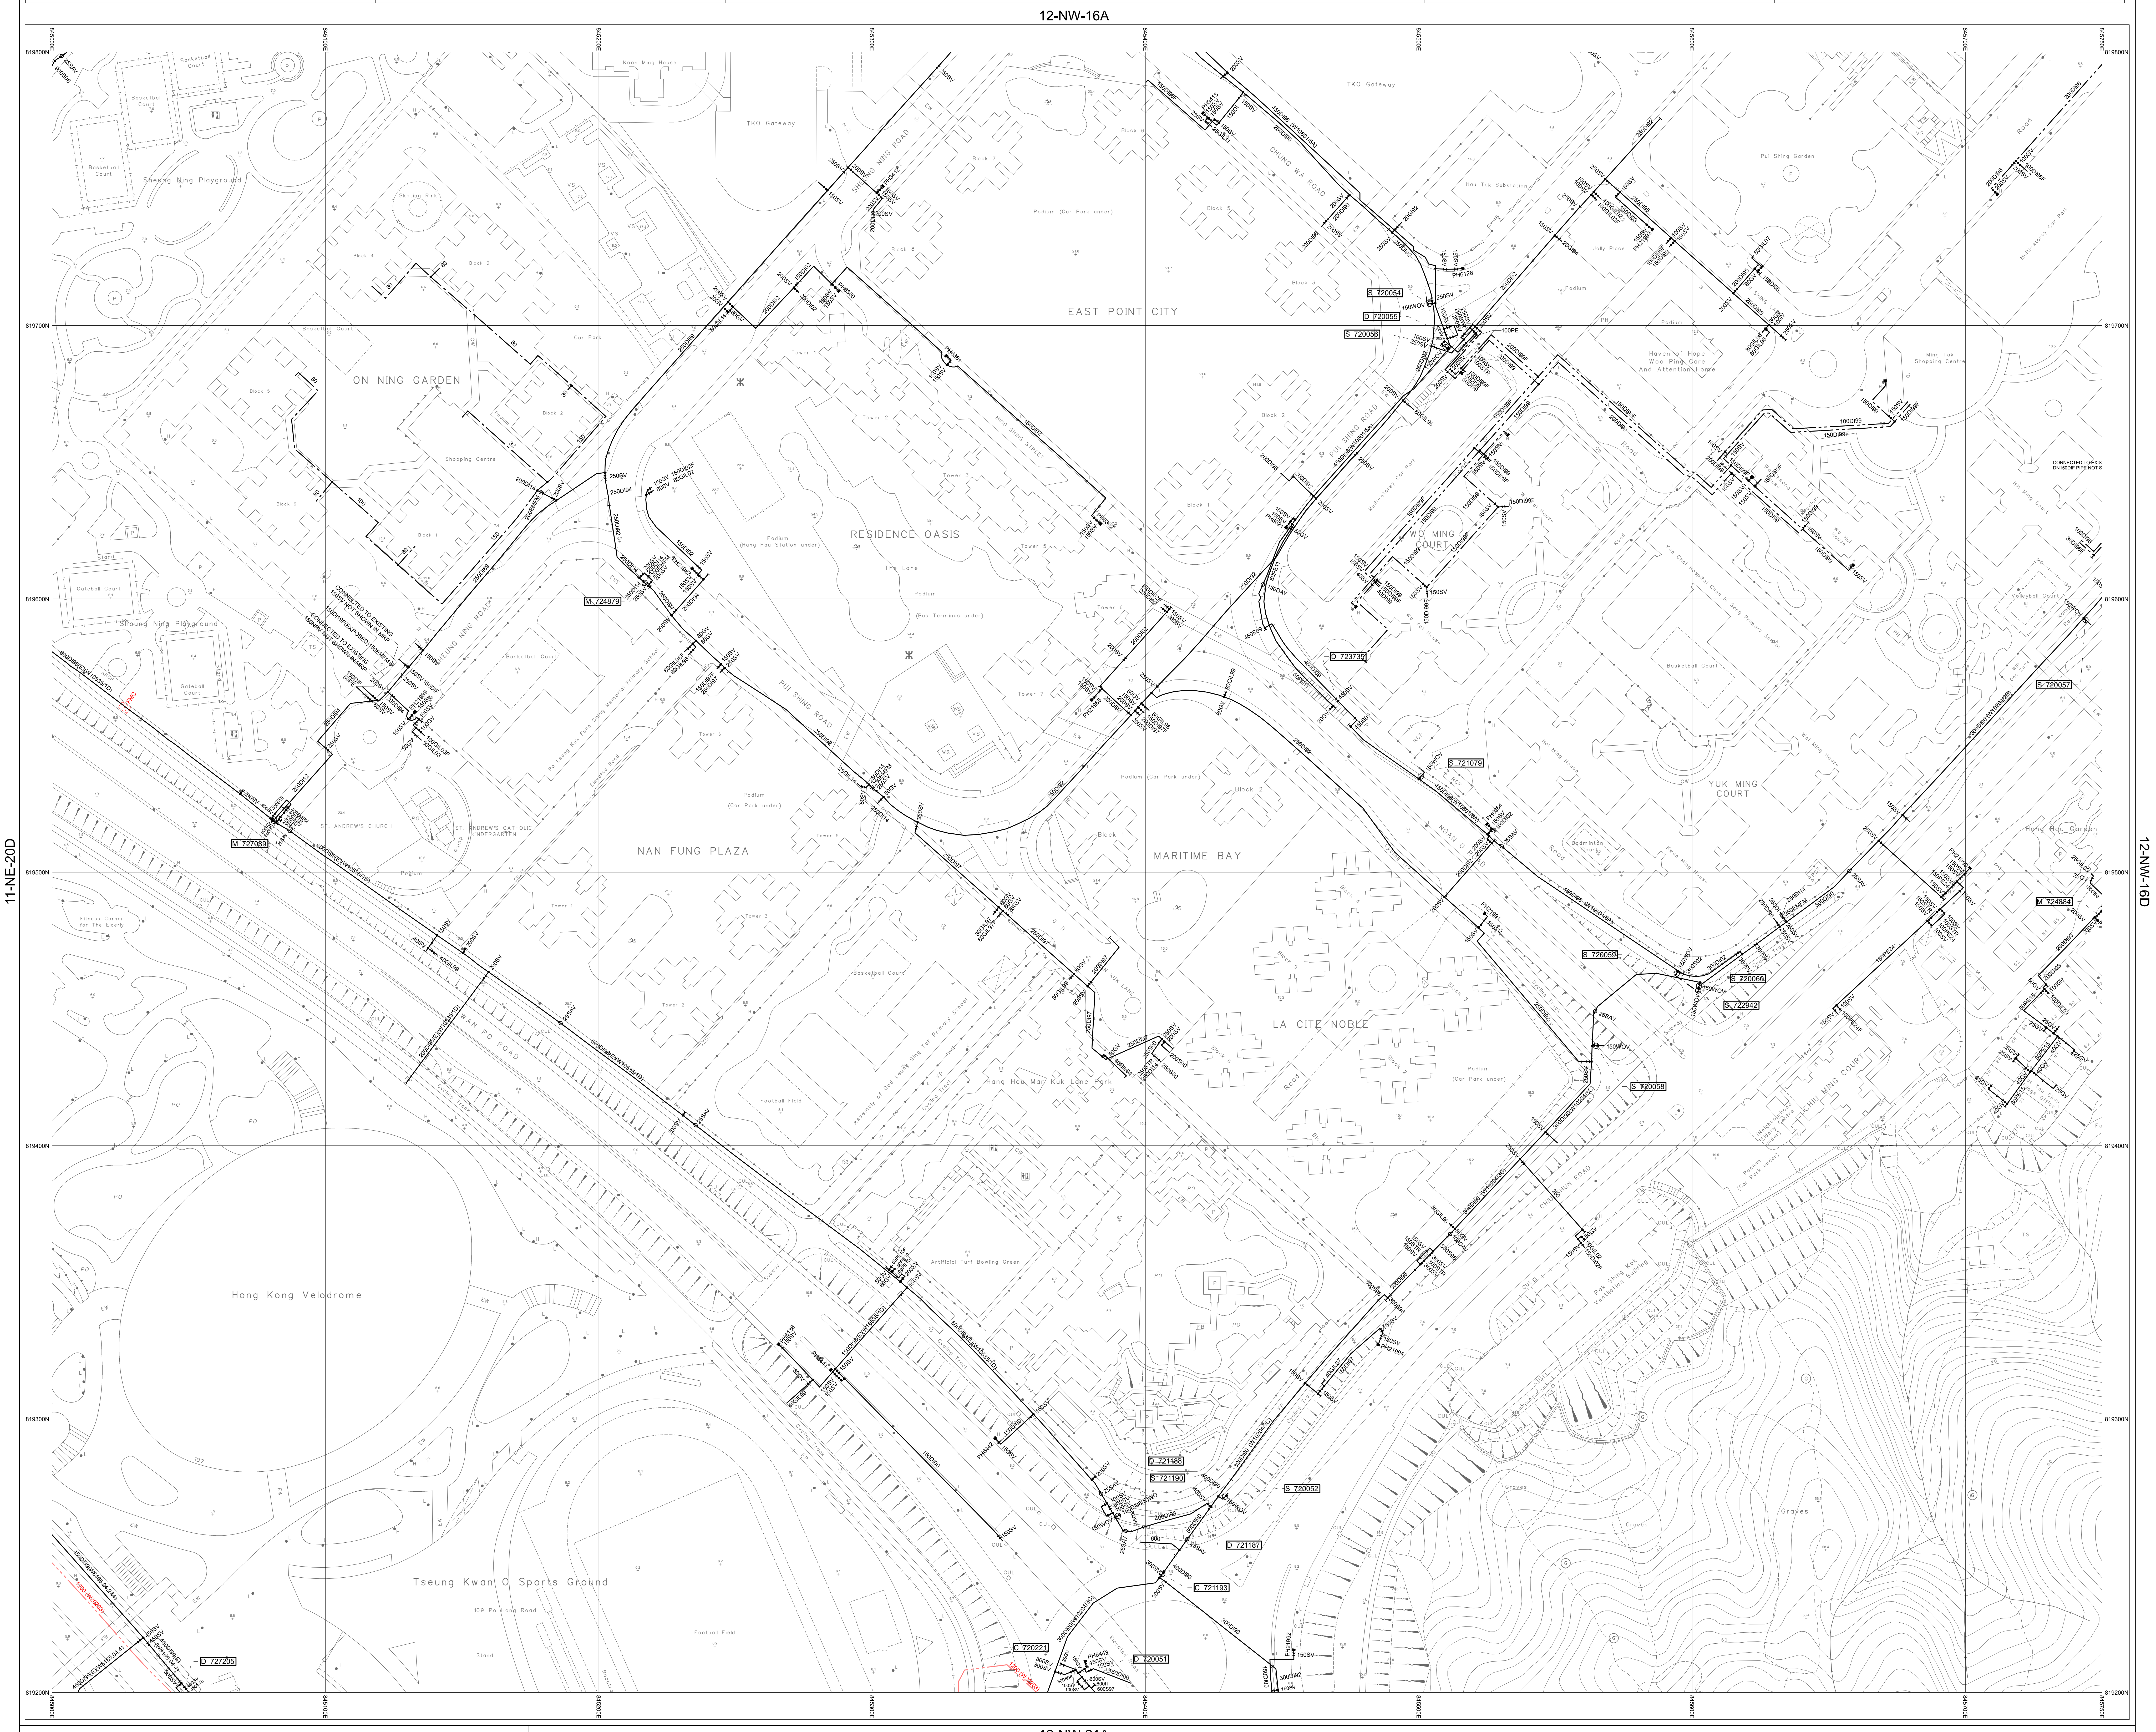

12-NW-16A
11-NE-20D
12-NW-16D
12-NW-21A
Sheung Ning Playground
ON NING GARDEN
TKO Gateway
EAST POINT CITY
RESIDENCE OASIS
NAN FUNG PLAZA
MARITIME BAY
LA CITE NOBLE
WO MING COURT
YUK MING COURT
Pui Shing Garden
Haven of Hope Woo Ping Care And Attention Home
ST. ANDREW'S CHURCH
ST. ANDREW'S CATHOLIC KINDERGARTEN
Hang Hau Man Kuk Lane Park
Hong Kong Velodrome
Tseung Kwan O Sports Ground
CHUNG WA ROAD
PO SHING ROAD
WAN PO ROAD
NGAN O ROAD
B 720054
D 720055
B 720056
M 724878
M 727089
D 723732
B 721079
B 720057
M 724884
B 720068
D 727205
C 720221
D 720051

12-NW-21A

NOTES:

1. FOR MAINS RECORDS SIGN CONVENTIONS AND DESIGNATIONS SEE SKETCH NO.3988.
2. DIMENSIONS OF MAINS ARE IN MILLIMETRES UNLESS OTHERWISE SPECIFIED.
3. ALL LEVELS ARE IN METRES ABOVE PRINCIPAL DATUM.

Basemap Date Updated On: 05/01/2026

SCALE 1:1 000

METRES 20 10 0 20 40 60 80 100 METRES

FRESH WATER MAINS RECORD PLAN

HANG HAU ROAD, TSEUNG KWAN O

THIS IS A COMPUTER PRINTOUT,
NO SIGNATURE IS REQUIRED.

COPYRIGHT RESERVED

DATE REVISED : 03/06/2026

DRAWING NO.

W67880/ 12-NW-16C

SIGNED
C.H. NG
CE/MSE
DATE: 10/06/1999

Water Supplies Department
HONG KONG

© The Government of the Hong Kong SAR, Map reproduced with permission of the Director of Lands