
| INSET 'A' | INSET 'B' | INSET 'C' | INSET 'D' | INSET 'E' | INSET 'F' |
|---|---|---|---|---|---|
| | | | | | |

8-SE-2D

8-SE-7A

8-SE-8A

8-SE-7D

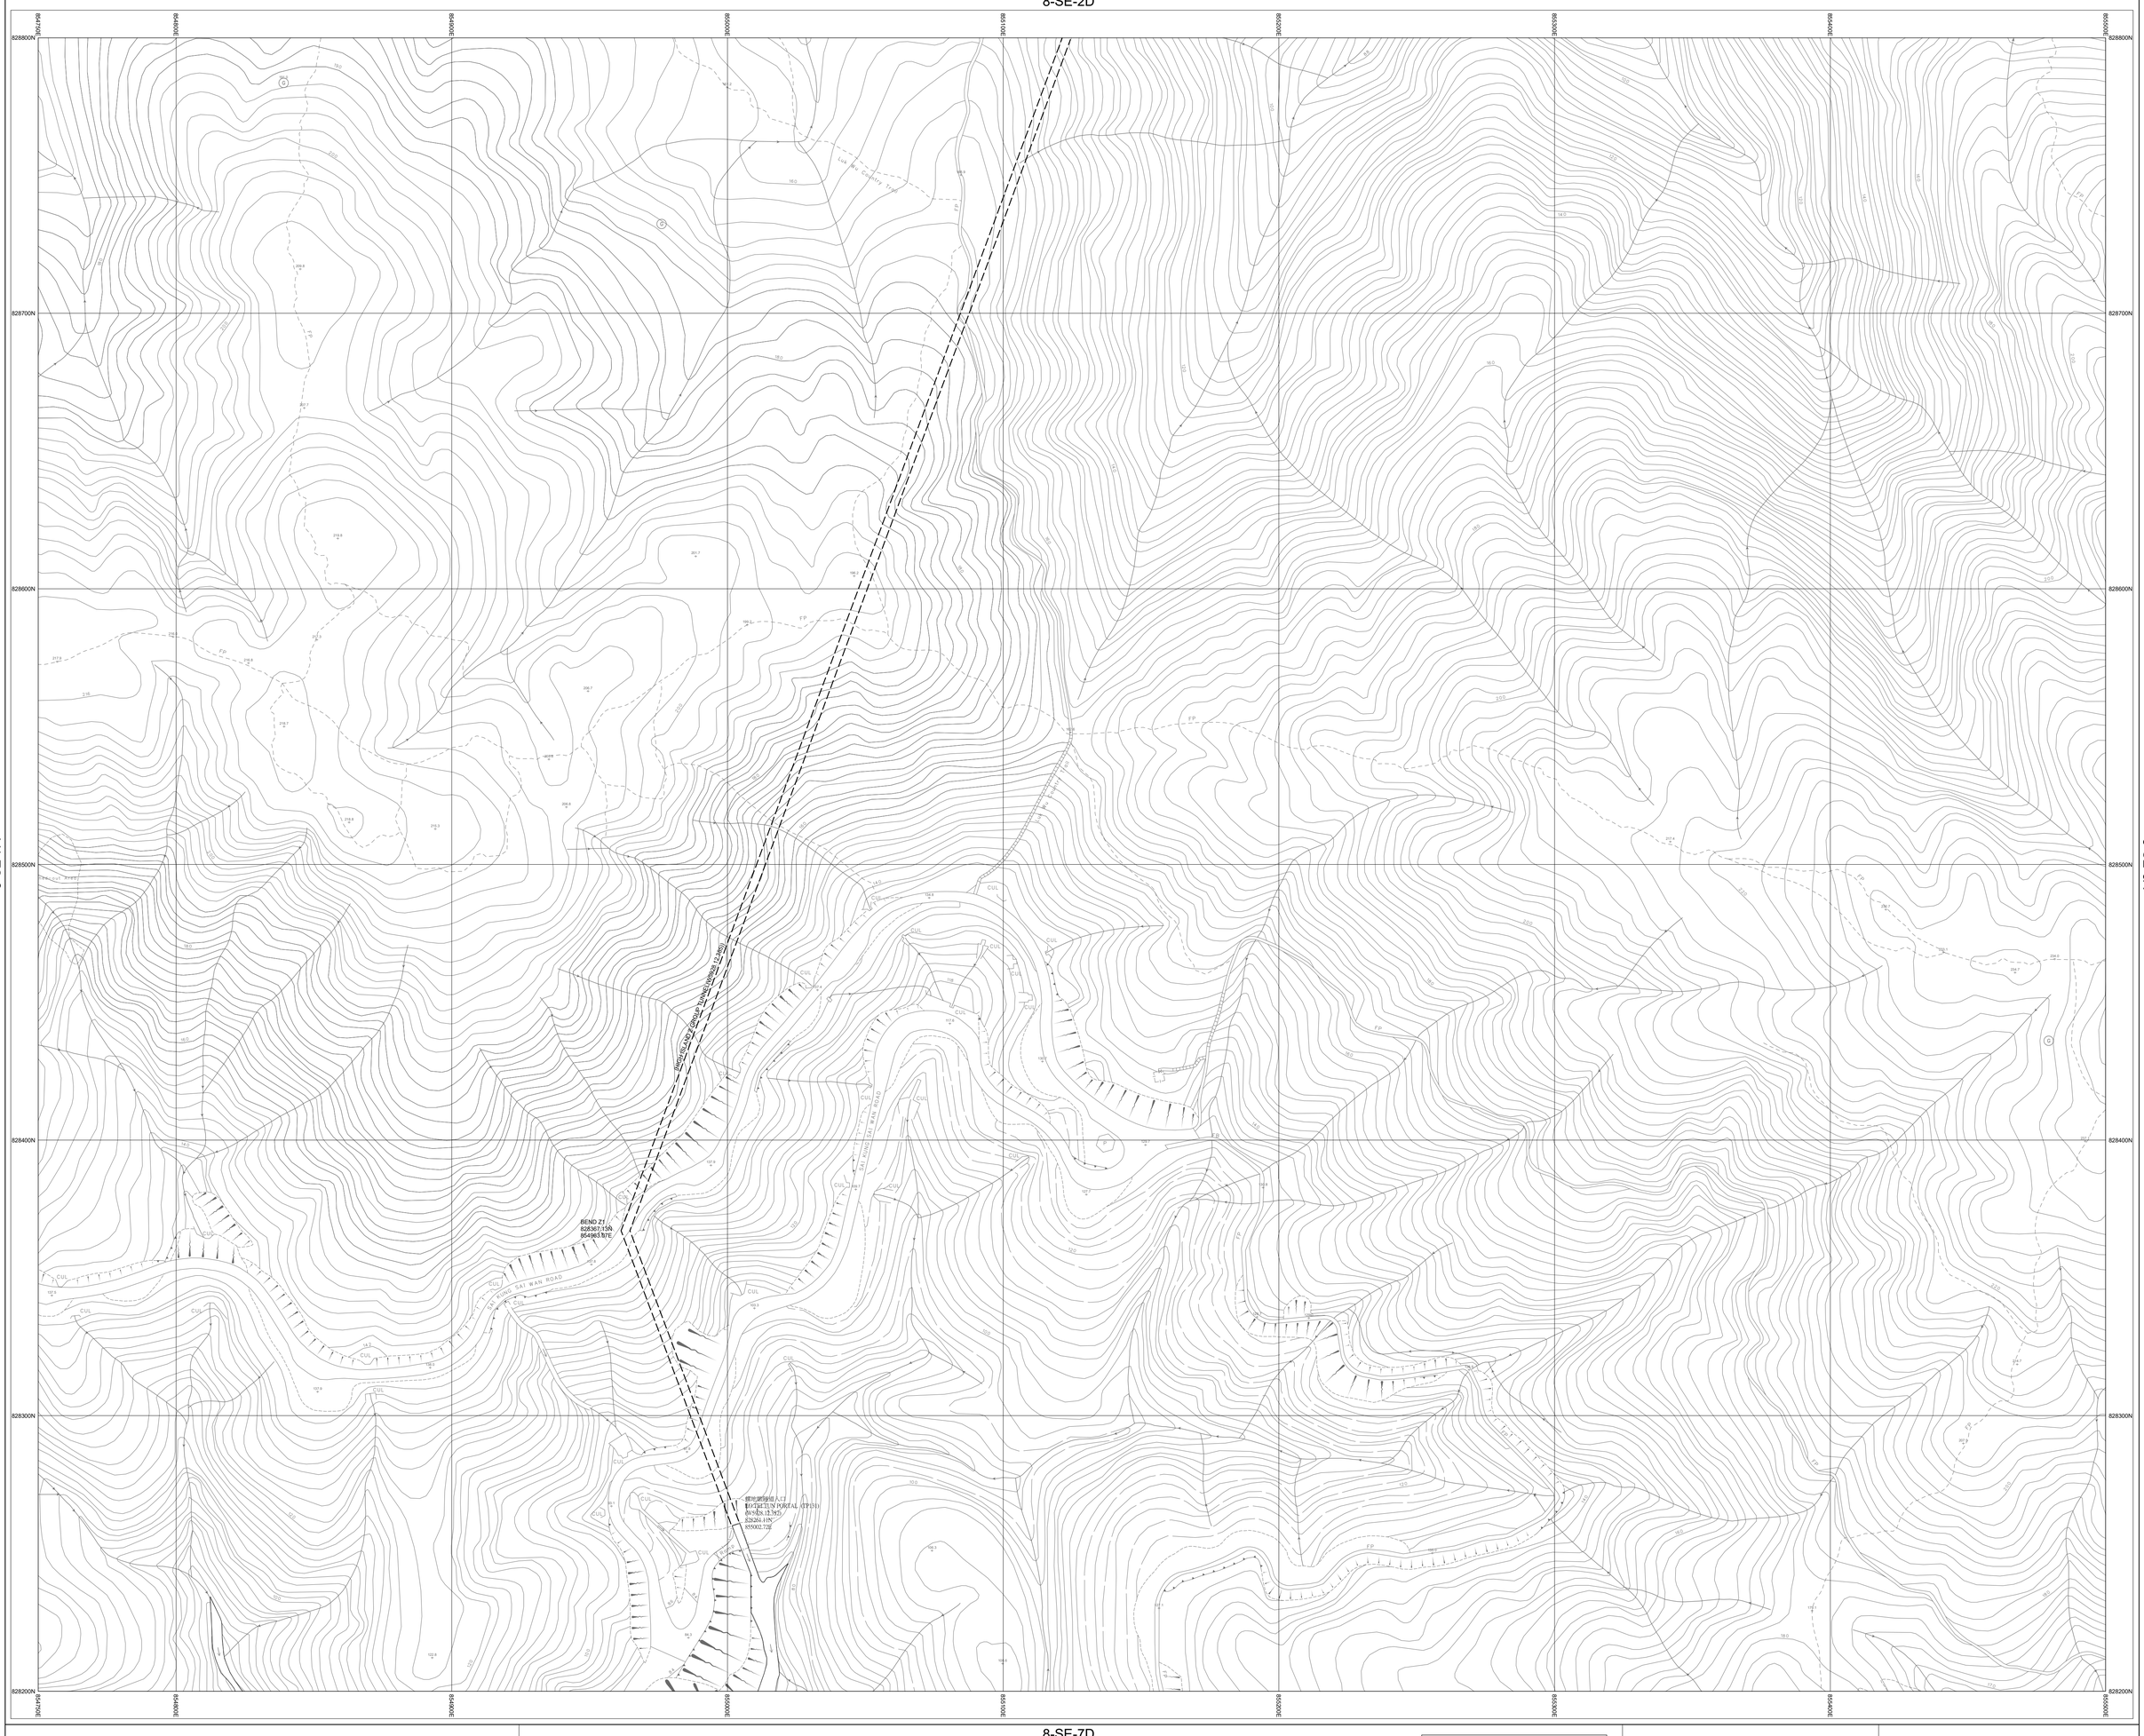


NOTES:

1. FOR MAINS RECORDS SIGN CONVENTIONS AND DESIGNATIONS SEE SKETCH NO.3988.
2. DIMENSIONS OF MAINS ARE IN MILLIMETRES UNLESS OTHERWISE SPECIFIED.
3. ALL LEVELS ARE IN METRES ABOVE PRINCIPAL DATUM.

Basemap Date Updated On: 23/12/2024

SCALE 1:1 000

METRES 20 10 0 20 40 60 80 100 METRES

# FRESH WATER MAINS RECORD PLAN

HIGH ISLAND Z GROUP TUNNEL

THIS IS A COMPUTER PRINTOUT, NO SIGNATURE IS REQUIRED.

COPYRIGHT RESERVED

DATE REVISED : 31/12/2024

DRAWING NO.

W67880/ 8-SE-7B

SIGNED

C.H. NG
CE/MSE

DATE: 01/02/2001

Water Supplies Department
HONG KONG

© The Government of the Hong Kong SAR, Map reproduced with permission of the Director of Lands