INSET 'A'	INSET 'B'	INSET 'C'	INSET 'D'	INSET 'E'	INSET 'F'

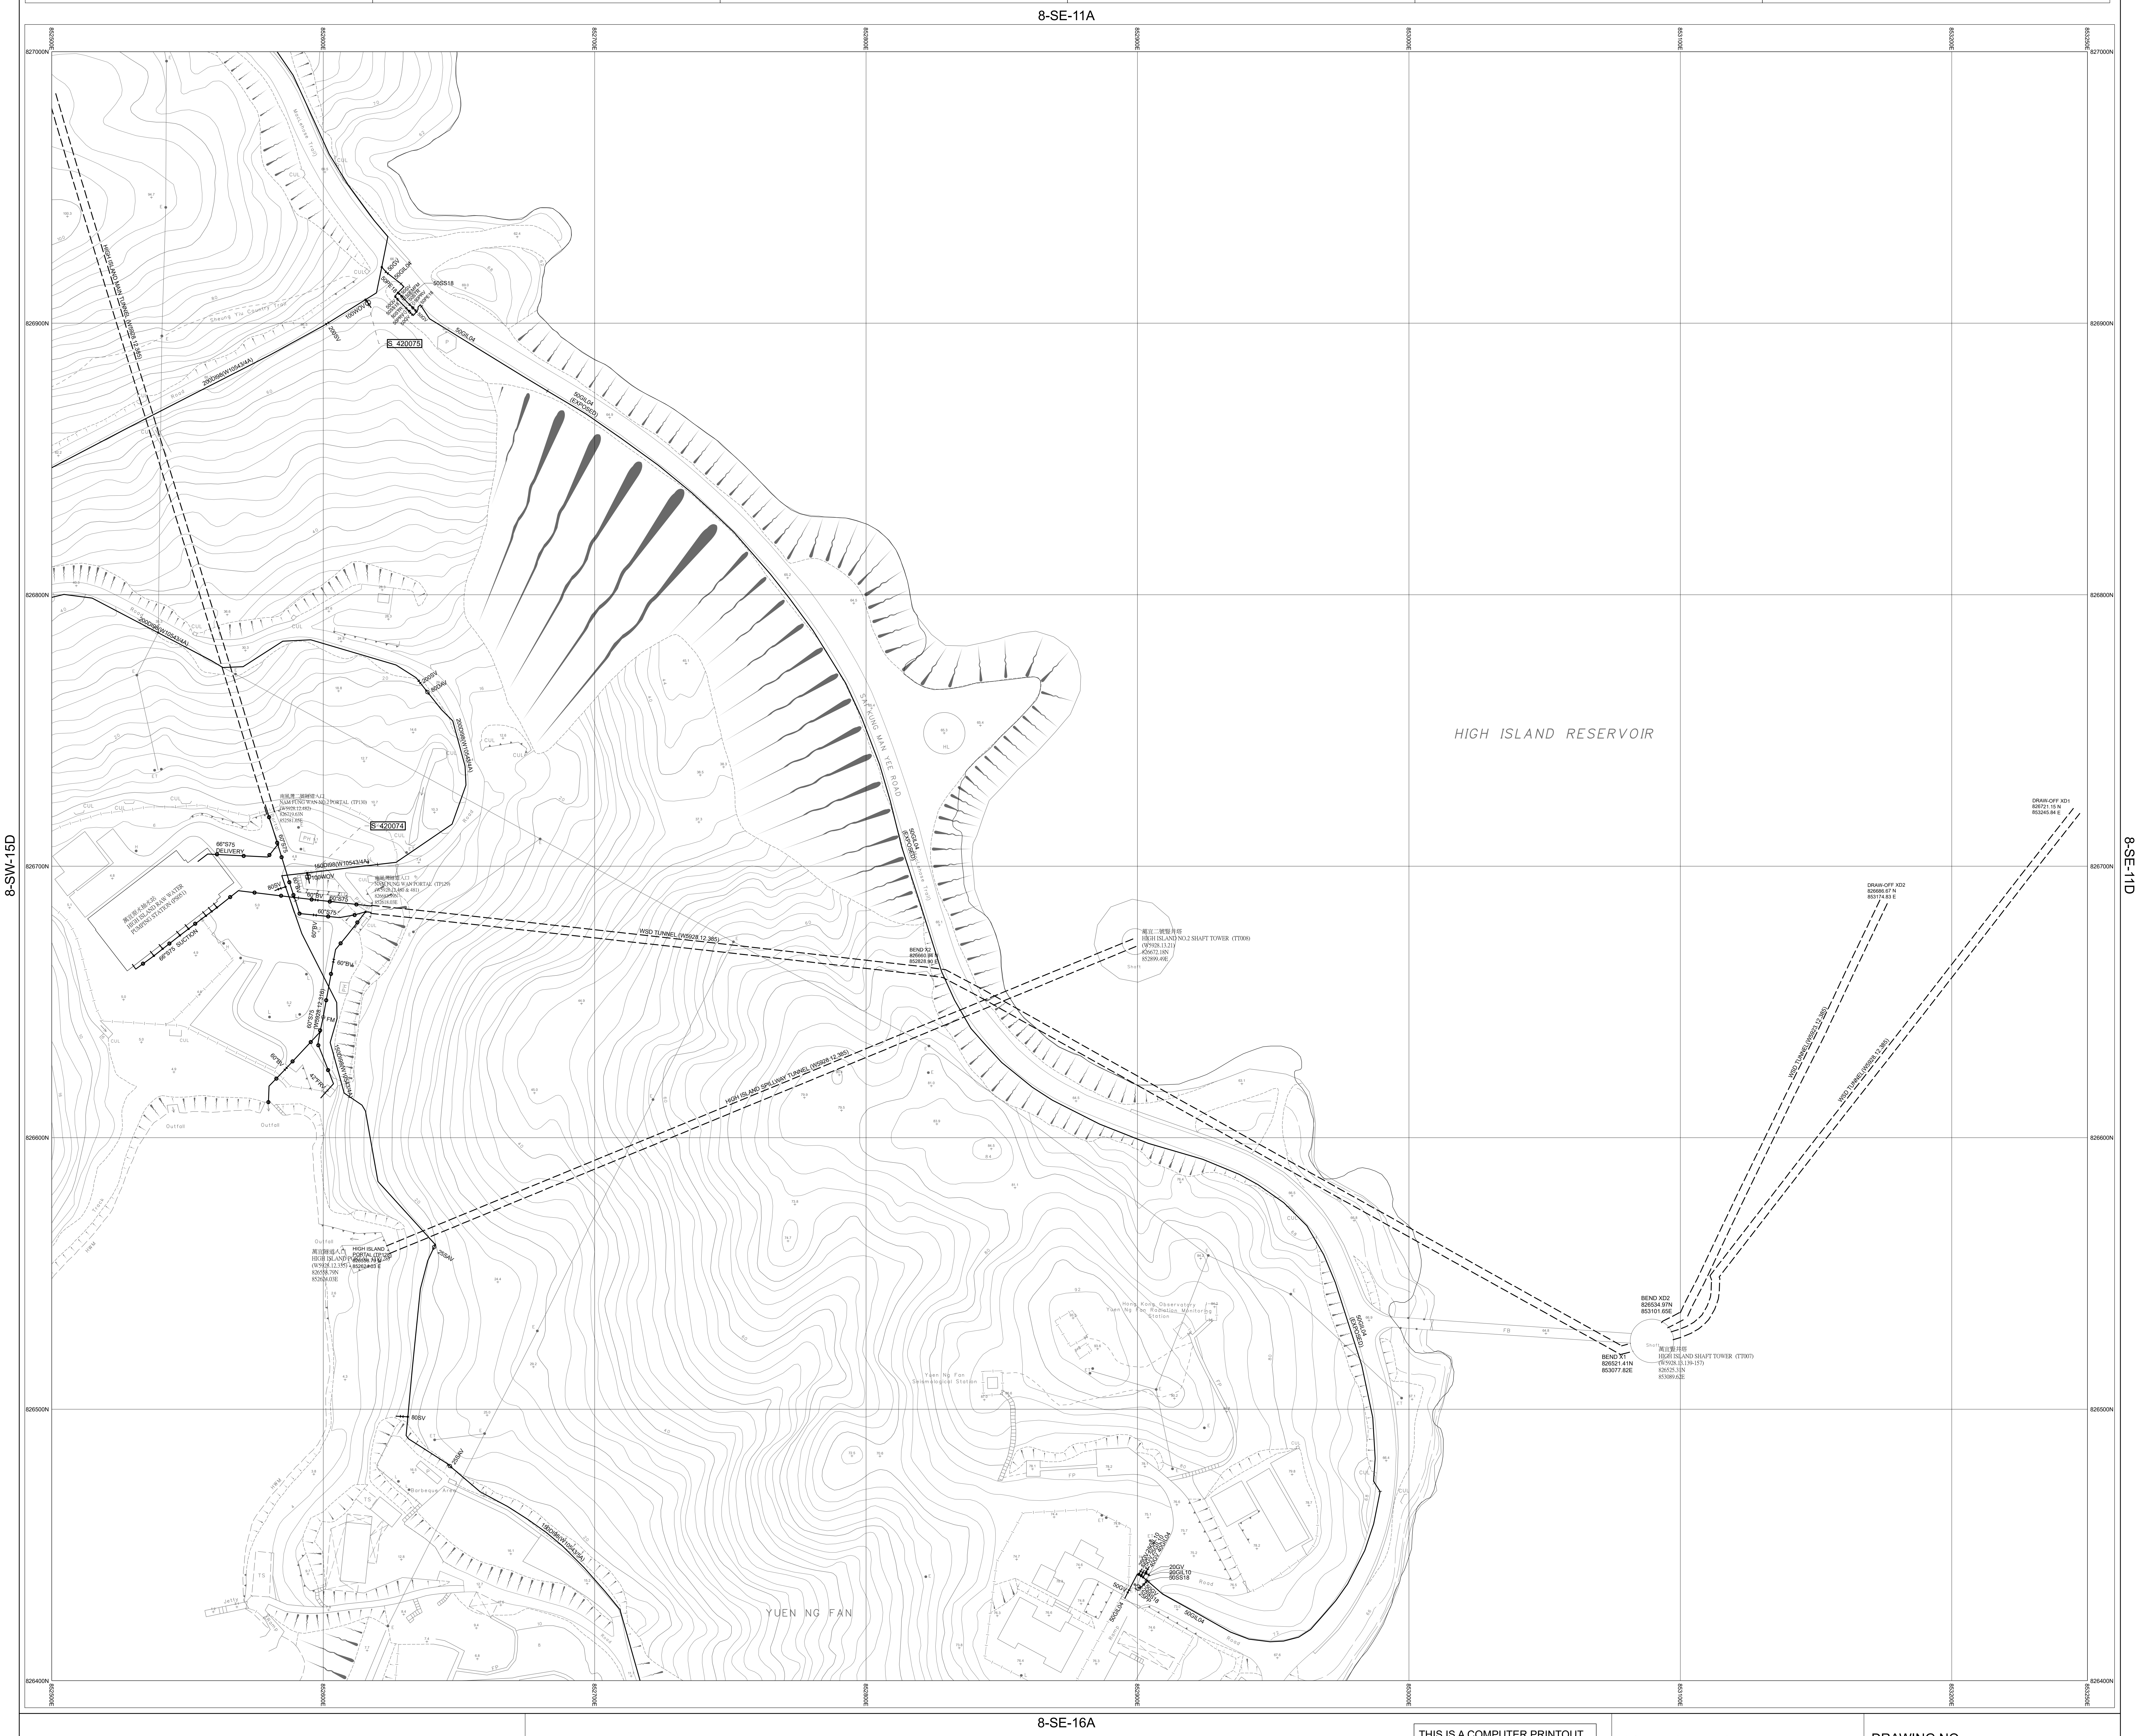
8-SE-11A
8-SW-15D
8-SE-11D
8-SE-16A
827000N
826900N
826800N
826700N
826600N
826500N
826400N
852900E
HIGH ISLAND RESERVOIR
YUEN NG FAN
(MacLehose Trail)
Sheung Yiu Country Trail
S 420075
S 420074
50SS18
50GV
50GIL04
50PE18
50EMFM
50STR
50PRV
100WOV
200SV
80DAV
200DI98(W10543/4A)
150DI98(W10543/4A)
50GIL04 (EXPOSED)
南風灣二號隧道入口
NAM FUNG WAN NO.2 PORTAL (TP130)
(W5928.12.482)
826719.63N
852581.65E
南風灣隧道入口
NAM FUNG WAN PORTAL (TP129)
(W5928.12.480 & 481)
826683.99N
852618.03E
萬宜原水抽水站
HIGH ISLAND RAW WATER PUMPING STATION (PS051)
66"S75 DELIVERY
66"S75 SUCTION
60"S75
60"BV
80SV
60"S75 (W5928.12.316)
FM
42"FRV
Outfall
Track
HWM
萬宜隧道入口
HIGH ISLAND PORTAL (TP128)
(W5928.12.335)
826558.79N
852624.03E
25SAV
80SV
WSD TUNNEL (W5928.12.385)
HIGH ISLAND SPILLWAY TUNNEL (W5928.12.385)
BEND X2
826660.94 N
852828.90 E
萬宜二號豎井塔
HIGH ISLAND NO.2 SHAFT TOWER (TT008)
(W5928.13.21)
826672.18N
852899.49E
Shaft
BEND X1
826521.41N
853077.82E
BEND XD2
826534.97N
853101.65E
萬宜豎井塔
HIGH ISLAND SHAFT TOWER (TT007)
(W5928.13.139-157)
826525.31N
853089.62E
WSD TUNNEL(W5923.12.385)
WSD TUNNEL(W5928.12.385)
DRAW-OFF XD2
826686.67 N
853174.83 E
DRAW-OFF XD1
826721.15 N
853245.84 E
25GV
25GIL10
40GV
40GIL04
20GV
20GIL10
25SS18
25PP
Ramp
Road
FP

8-SE-16A

NOTES:

1. FOR MAINS RECORDS SIGN CONVENTIONS AND DESIGNATIONS SEE SKETCH NO.3988.
2. DIMENSIONS OF MAINS ARE IN MILLIMETRES UNLESS OTHERWISE SPECIFIED.
3. ALL LEVELS ARE IN METRES ABOVE PRINCIPAL DATUM.

Basemap Date Updated On: 23/12/2024

SCALE 1:1 000

METRES 20 10 0 20 40 60 80 100 METRES

THIS IS A COMPUTER PRINTOUT,
NO SIGNATURE IS REQUIRED.

FRESH WATER MAINS RECORD PLAN

HIGH ISLAND RESERVOIR

COPYRIGHT RESERVED

DATE REVISED : 31/12/2024

DRAWING NO.

W67880/ 8-SE-11C

SIGNED
C.H. NG
CE/MSE
DATE: 10/06/1999

Water Supplies Department
HONG KONG

© The Government of the Hong Kong SAR, Map reproduced with permission of the Director of Lands