INSET 'A'	INSET 'B'	INSET 'C'	INSET 'D'	INSET 'E'	INSET 'F'

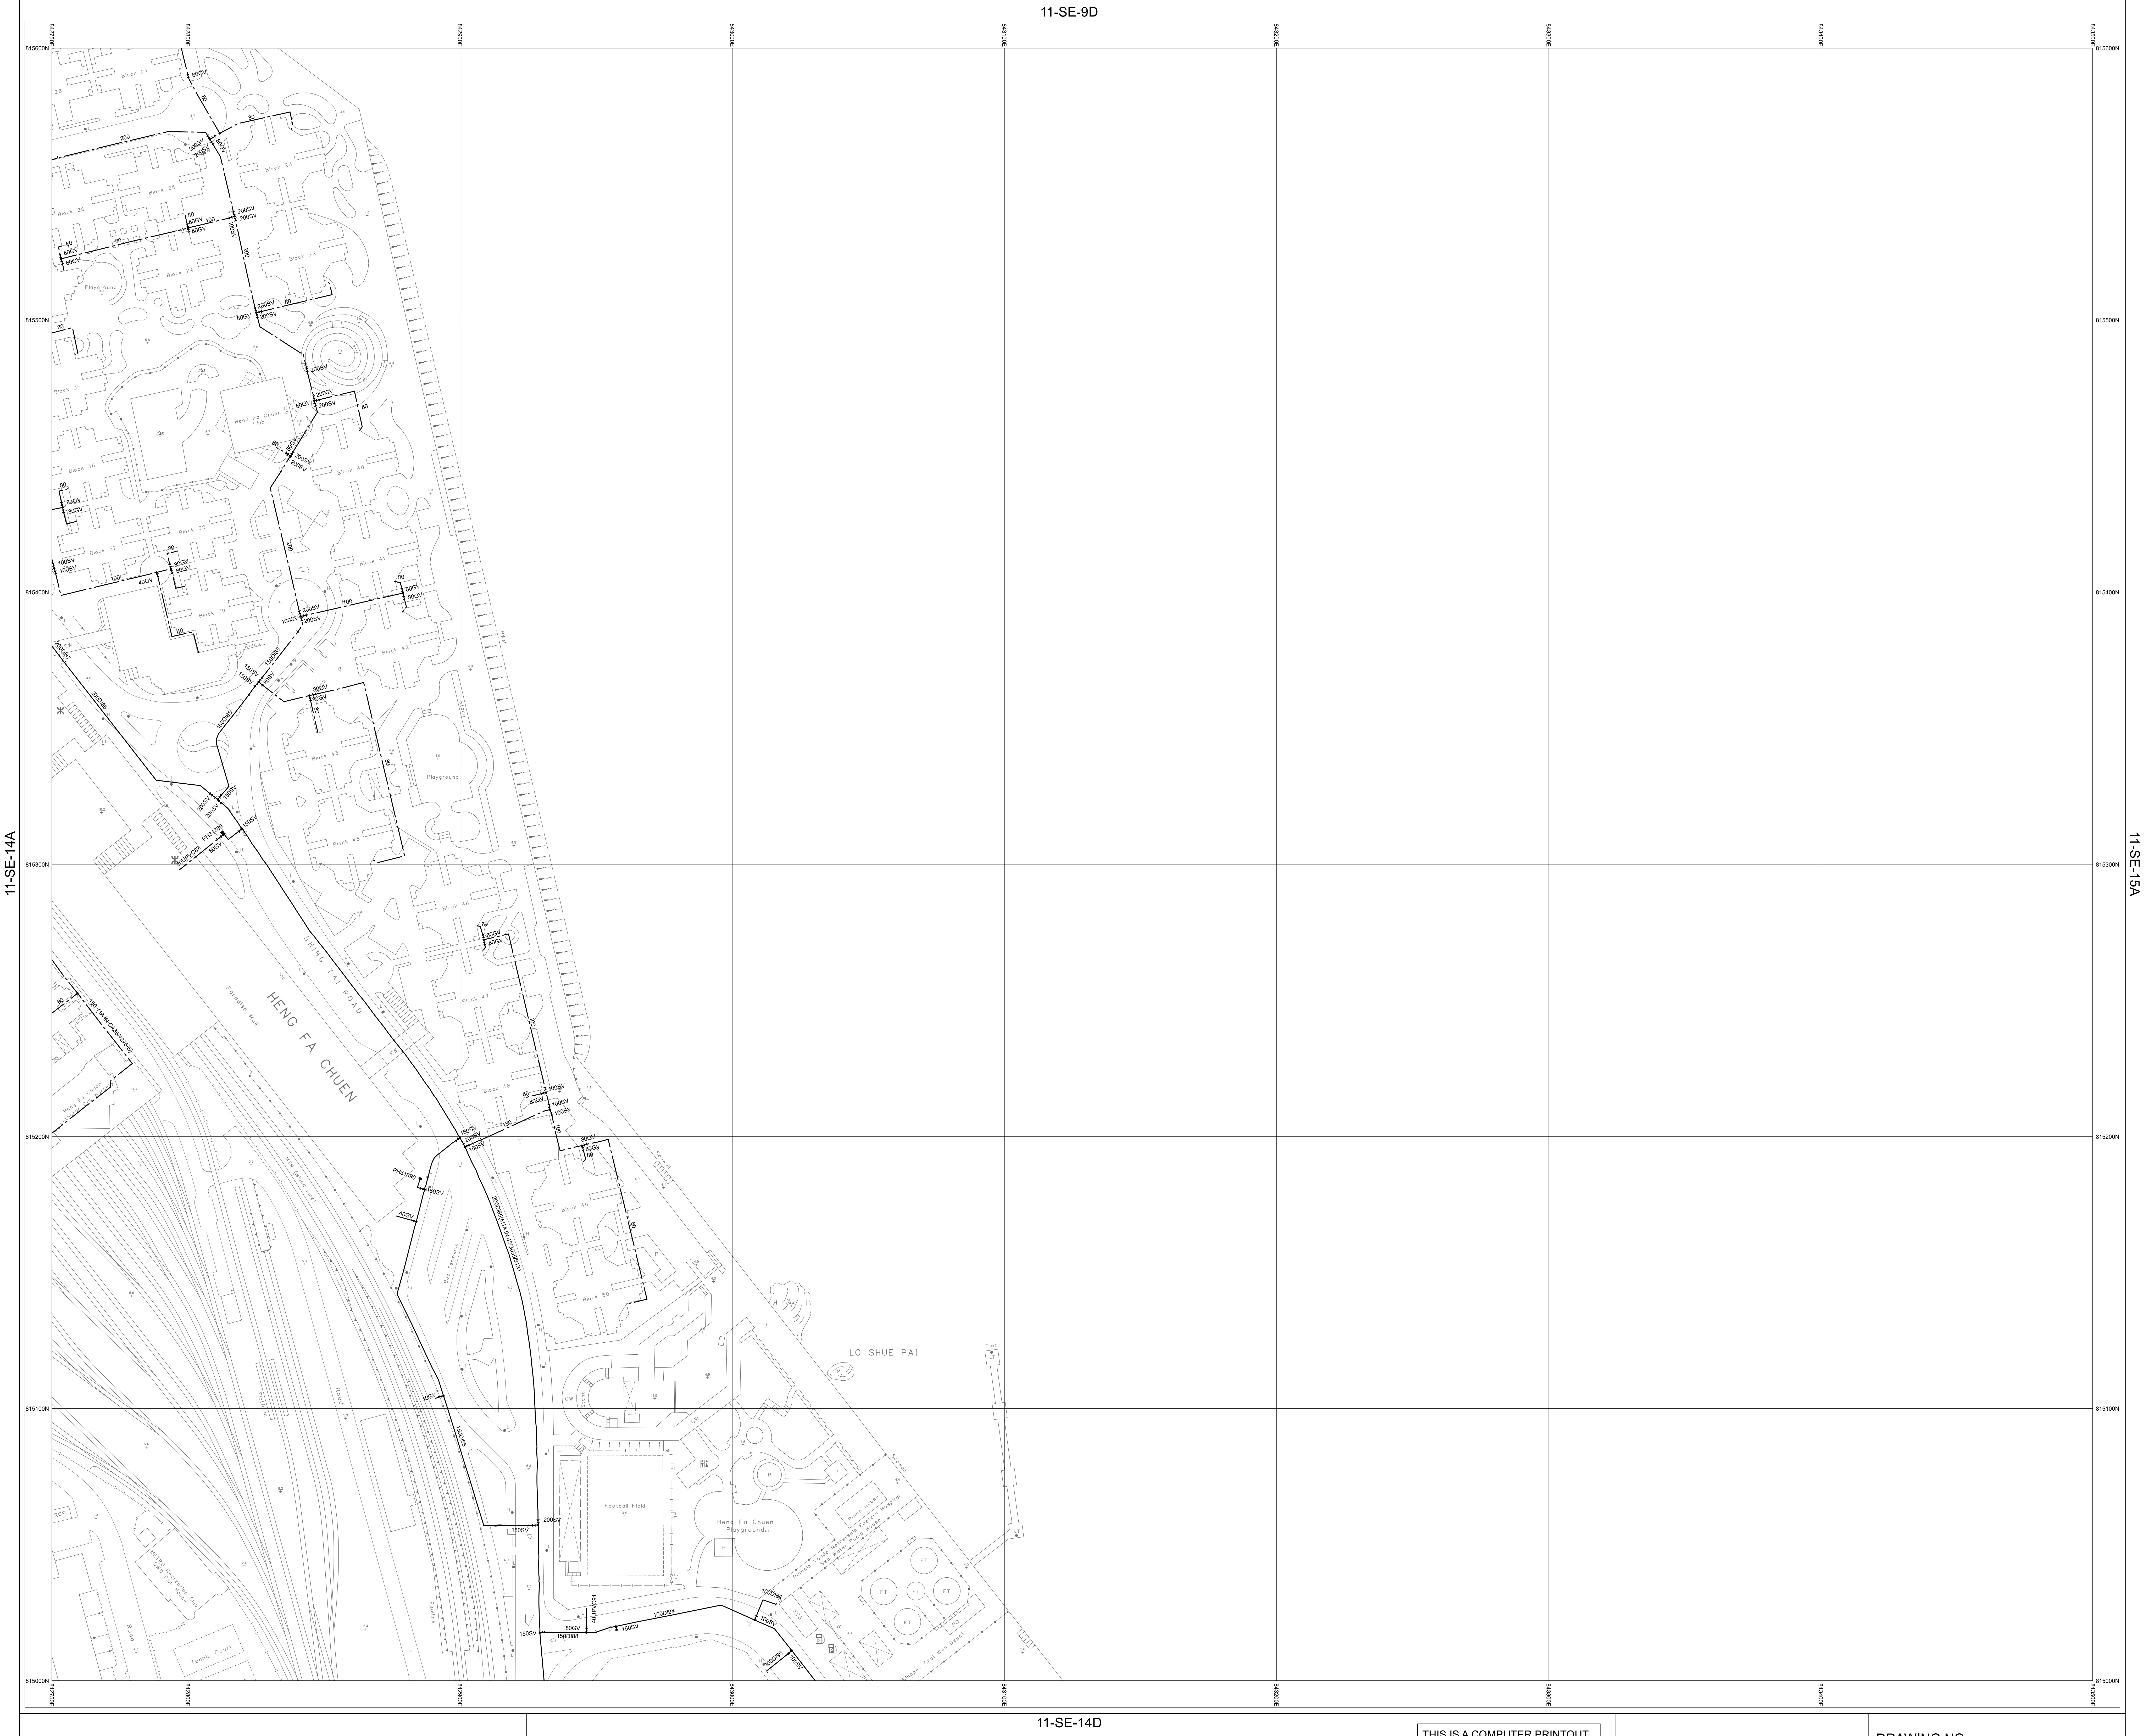
11-SE-9D
11-SE-14A
11-SE-15A
11-SE-14D
HENG FA CHUEN
SHING TAI ROAD
LO SHUE PAI
Heng Fa Chuen Playground
Football Field
Tennis Court
815600N
815500N
815400N
815300N
815200N
815100N
815000N
842750E
842800E
842900E
843000E
843100E
843200E
843300E
843400E
843500E

NOTES:
1. FOR MAINS RECORDS SIGN CONVENTIONS AND DESIGNATIONS SEE SKETCH NO.3988.
2. DIMENSIONS OF MAINS ARE IN MILLIMETRES UNLESS OTHERWISE SPECIFIED.
3. ALL LEVELS ARE IN METRES ABOVE PRINCIPAL DATUM.

Basemap Date Updated On: 05/01/2026

SCALE 1:1 000

METRES 20 10 0 20 40 60 80 100 METRES

THIS IS A COMPUTER PRINTOUT,
NO SIGNATURE IS REQUIRED.

SALT WATER MAINS RECORD PLAN

LO SHUE PAI, LEI YUE MUN BAY

COPYRIGHT RESERVED

DATE REVISED : 03/06/2026

DRAWING NO.
W67881/ 11-SE-14B

SIGNED
S.Y. KWAN
CE/HK
DATE: 07/09/1998

Water Supplies Department
HONG KONG

© The Government of the Hong Kong SAR, Map reproduced with permission of the Director of Lands