INSET 'A'	INSET 'B'	INSET 'C'	INSET 'D'	INSET 'E'	INSET 'F'

7-SE-10A

7-SE-9D

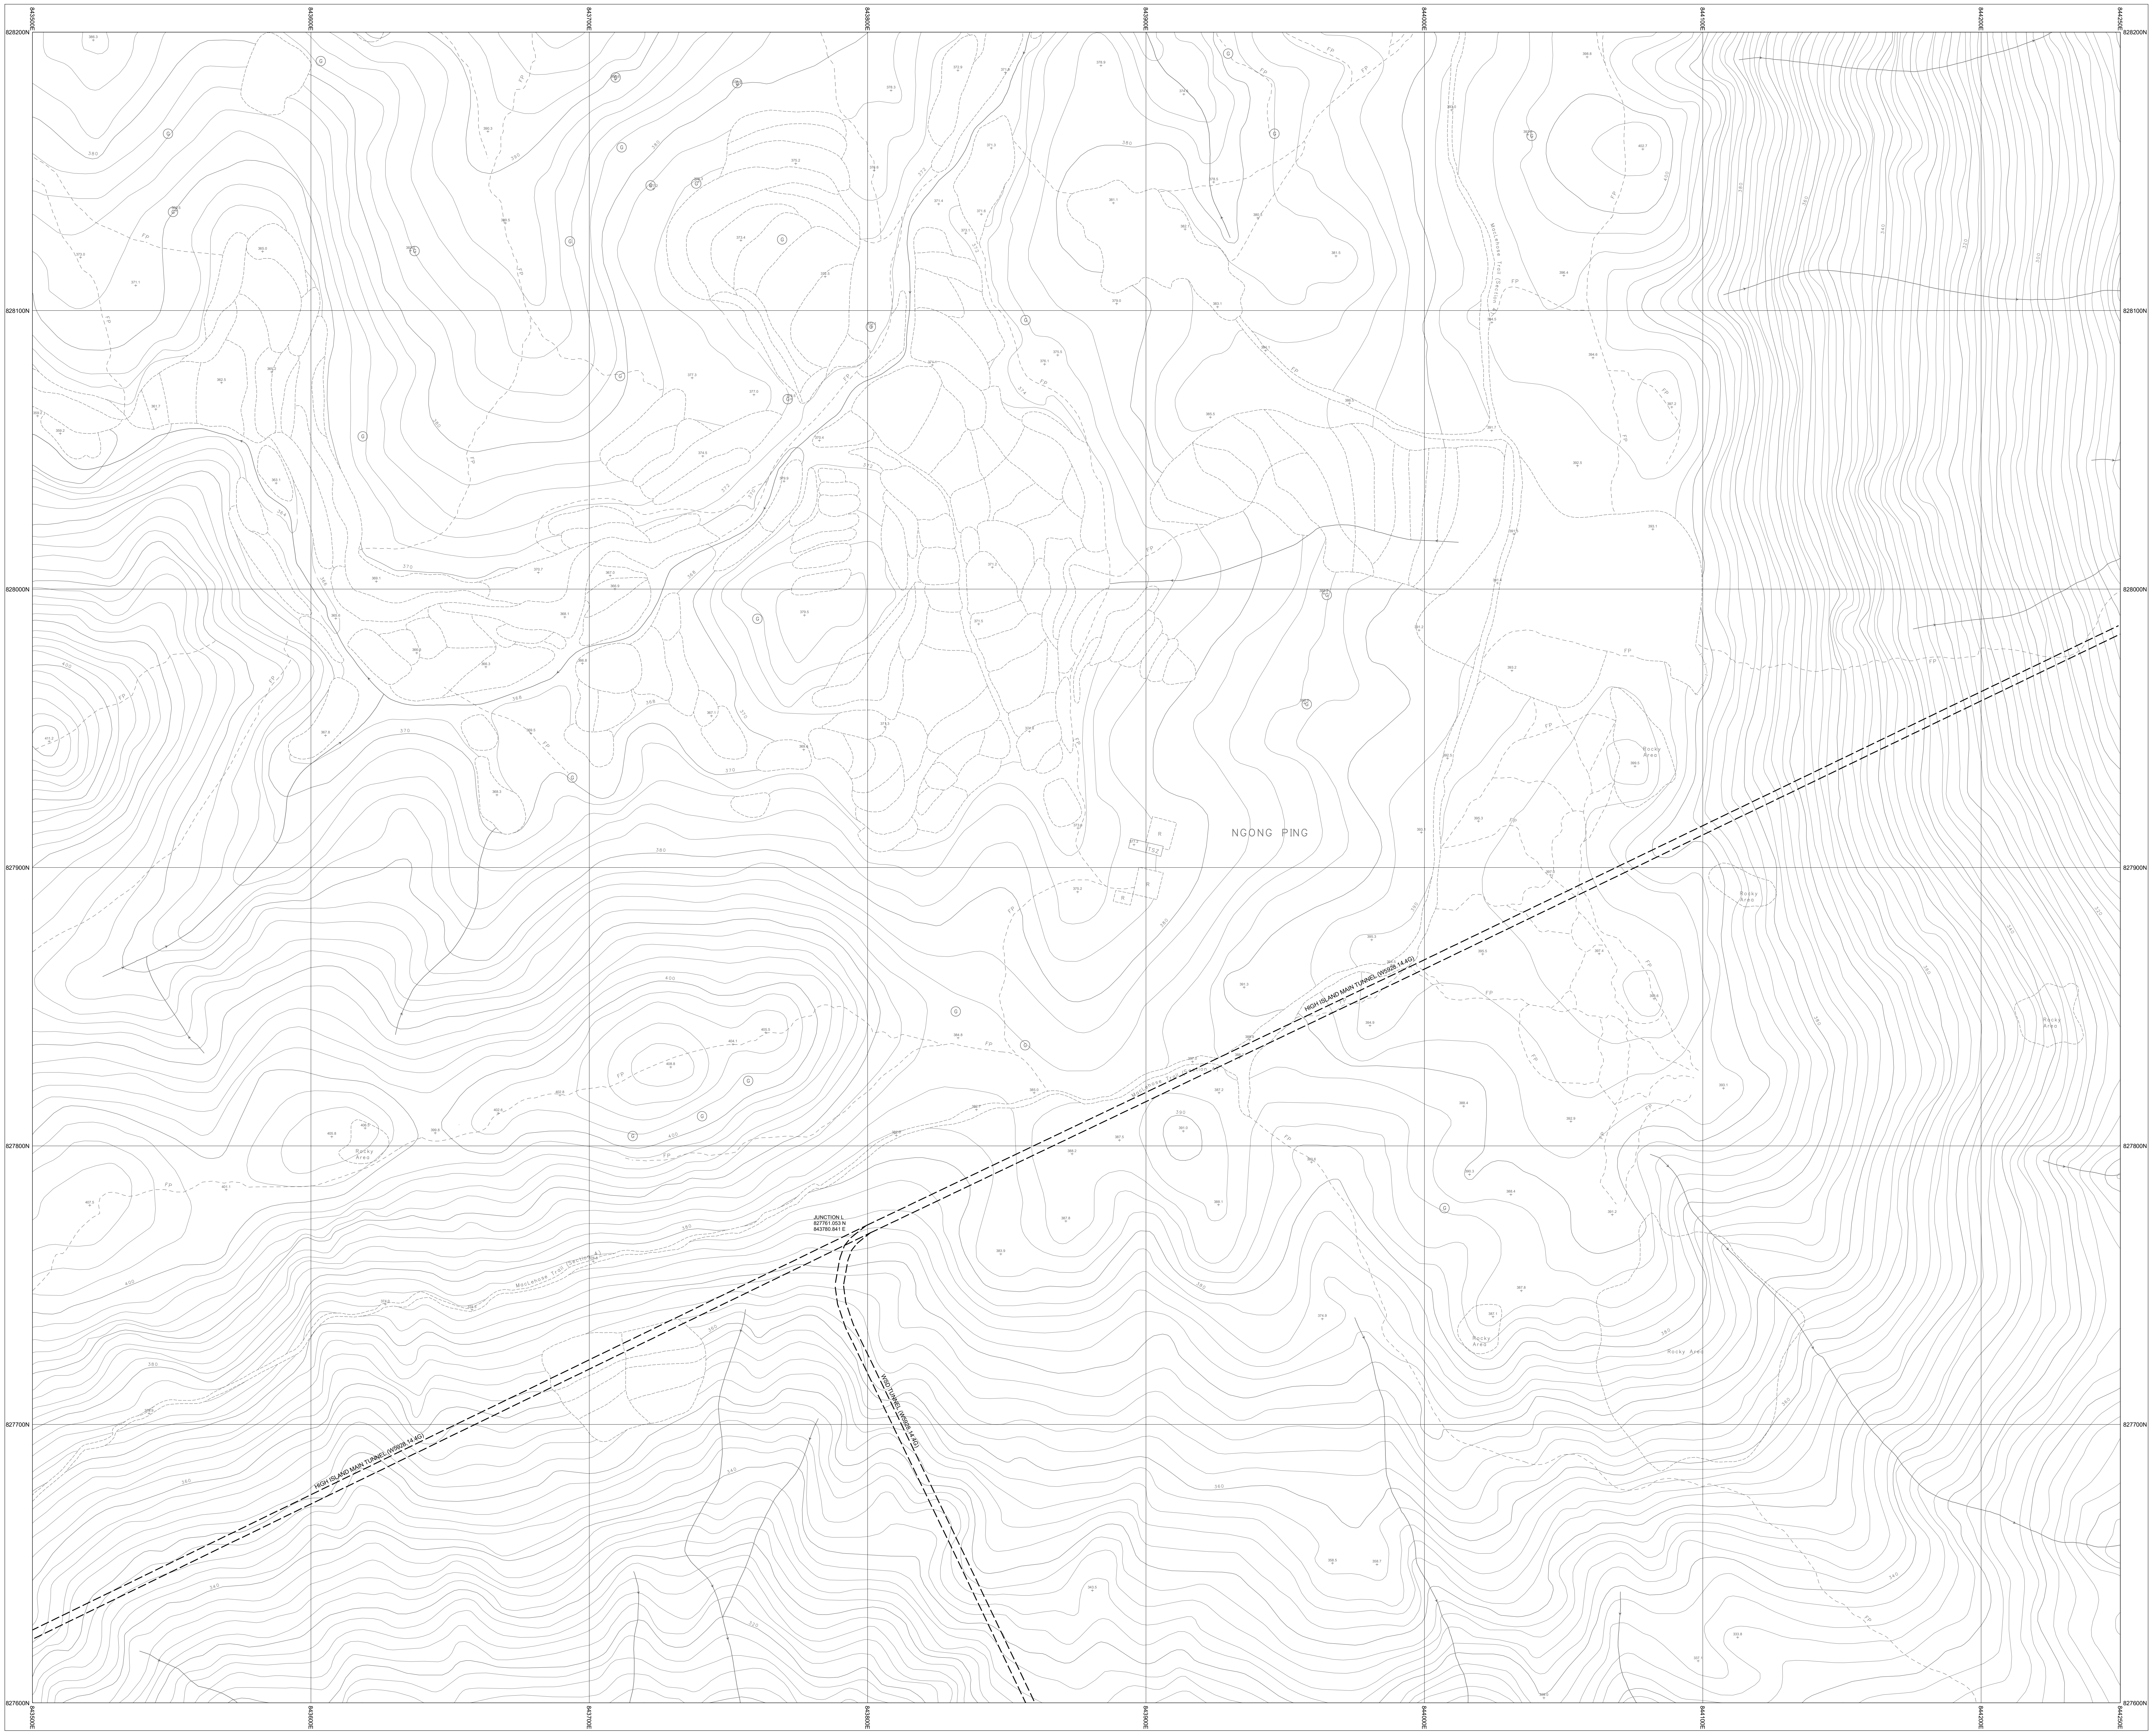

843500E
843600E
843700E
843800E
843900E
844000E
844100E
844200E
844250E
828200N
828100N
828000N
827900N
827800N
827700N
827600N
NGONG PING
HIGH ISLAND MAIN TUNNEL (W5928.14.4G)
JUNCTION L
827761.053 N
843780.841 E
WSD TUNNEL (W5928.14.4G)
FP

7-SE-10D

7-SE-15A

NOTES:

1. FOR MAINS RECORDS SIGN CONVENTIONS AND DESIGNATIONS SEE SKETCH NO.3988.
2. DIMENSIONS OF MAINS ARE IN MILLIMETRES UNLESS OTHERWISE SPECIFIED.
3. ALL LEVELS ARE IN METRES ABOVE PRINCIPAL DATUM.

Basemap Date Updated On: 23/12/2024

SCALE 1:1 000

METRES 20 10 0 20 40 60 80 100 METRES

FRESH WATER MAINS RECORD PLAN

NGONG PING, MA ON SHAN

THIS IS A COMPUTER PRINTOUT,
NO SIGNATURE IS REQUIRED.

COPYRIGHT RESERVED

DATE REVISED : 30/12/2024

DRAWING NO.
W67880/ 7-SE-10C

SIGNED
C.S. CHIN
CE/MNE
DATE: 23/04/1999

Water Supplies Department
HONG KONG

© The Government of the Hong Kong SAR, Map reproduced with permission of the Director of Lands