INSET 'A'	INSET 'B'	INSET 'C'	INSET 'D'	INSET 'E'	INSET 'F'

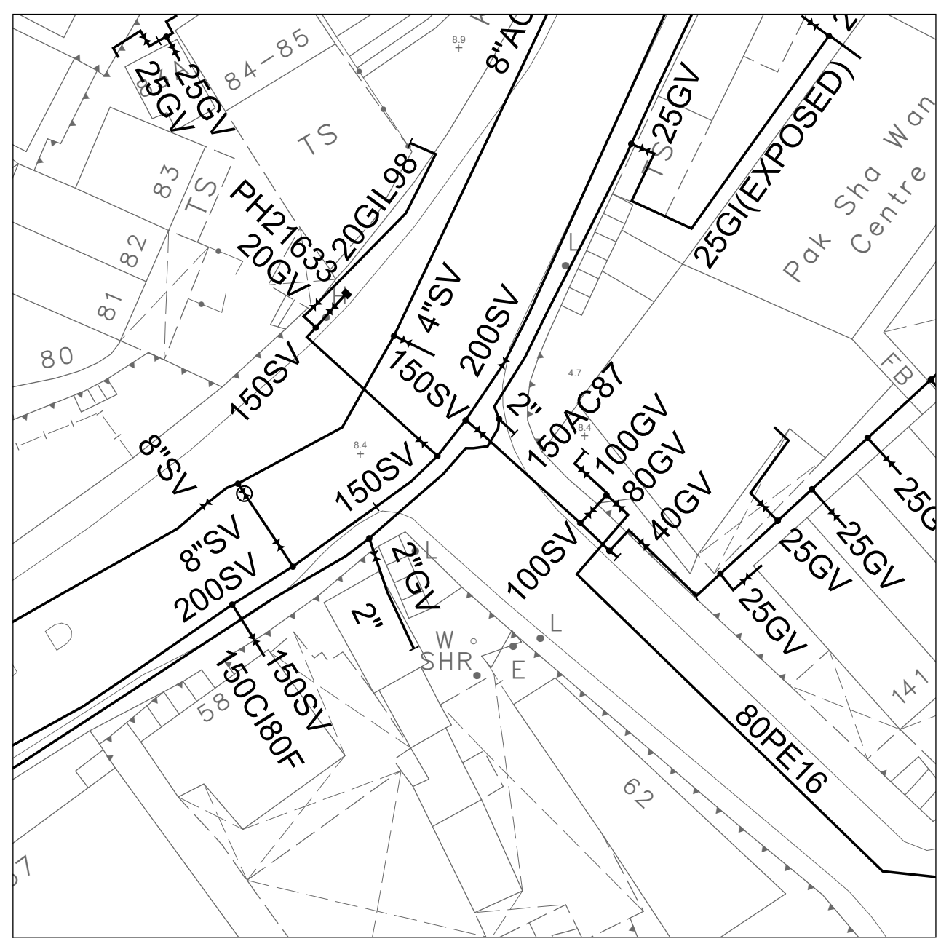
25GV
25GV
8"AC
TS
PH2163
20GIL98
20GV
4"SV
200SV
150SV
150SV
8"SV
150SV
150AC87
100GV
80GV
40GV
100SV
200SV
8"SV
2"GV
2"
150SV
150CI80F
25GV
25GI(EXPOSED)
Pak Sha Wan Centre
25GV
25GV
25GV
80PE16

Scale 1:500

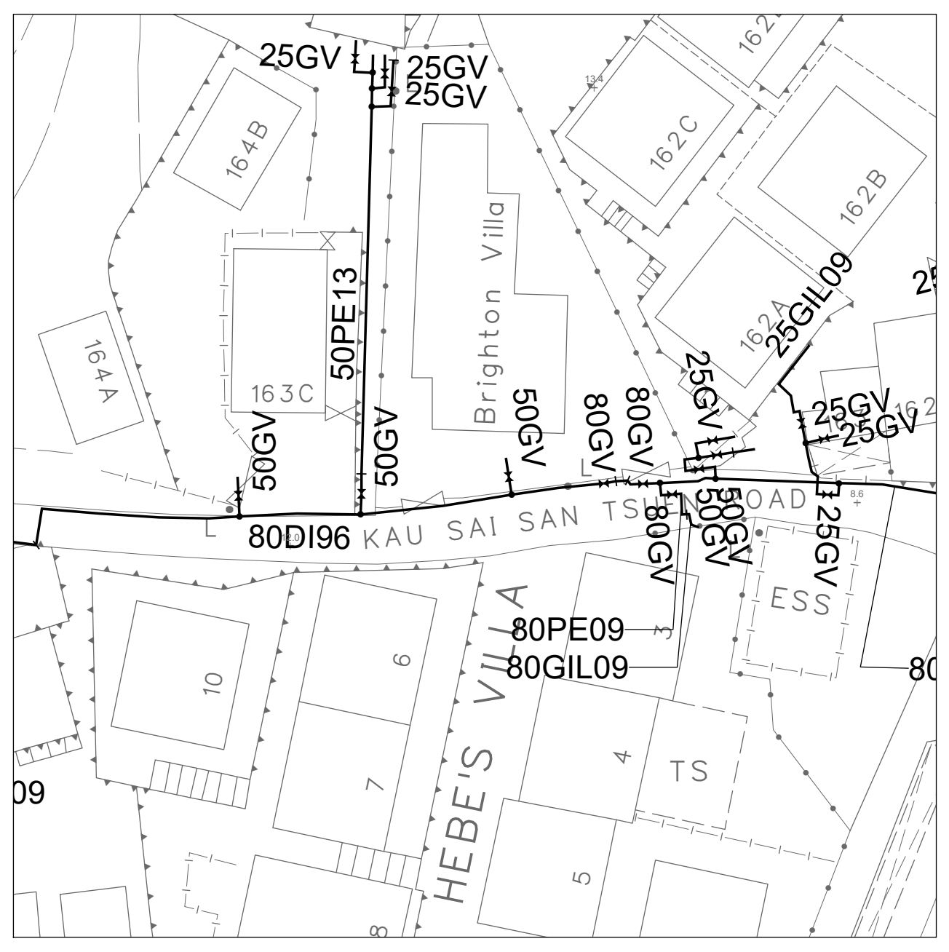
25GV
25GV
25GV
164B
164A
163C
50PE13
50GV
50GV
Brighton Villa
50GV
80GV
80GV
25GV
25GIL09
25GV
25GV
80DI96
KAU SAI SAN TSUEN ROAD
80PE09
80GIL09
HEBE'S VILLA
TS

Scale 1:500

7-SE-20D

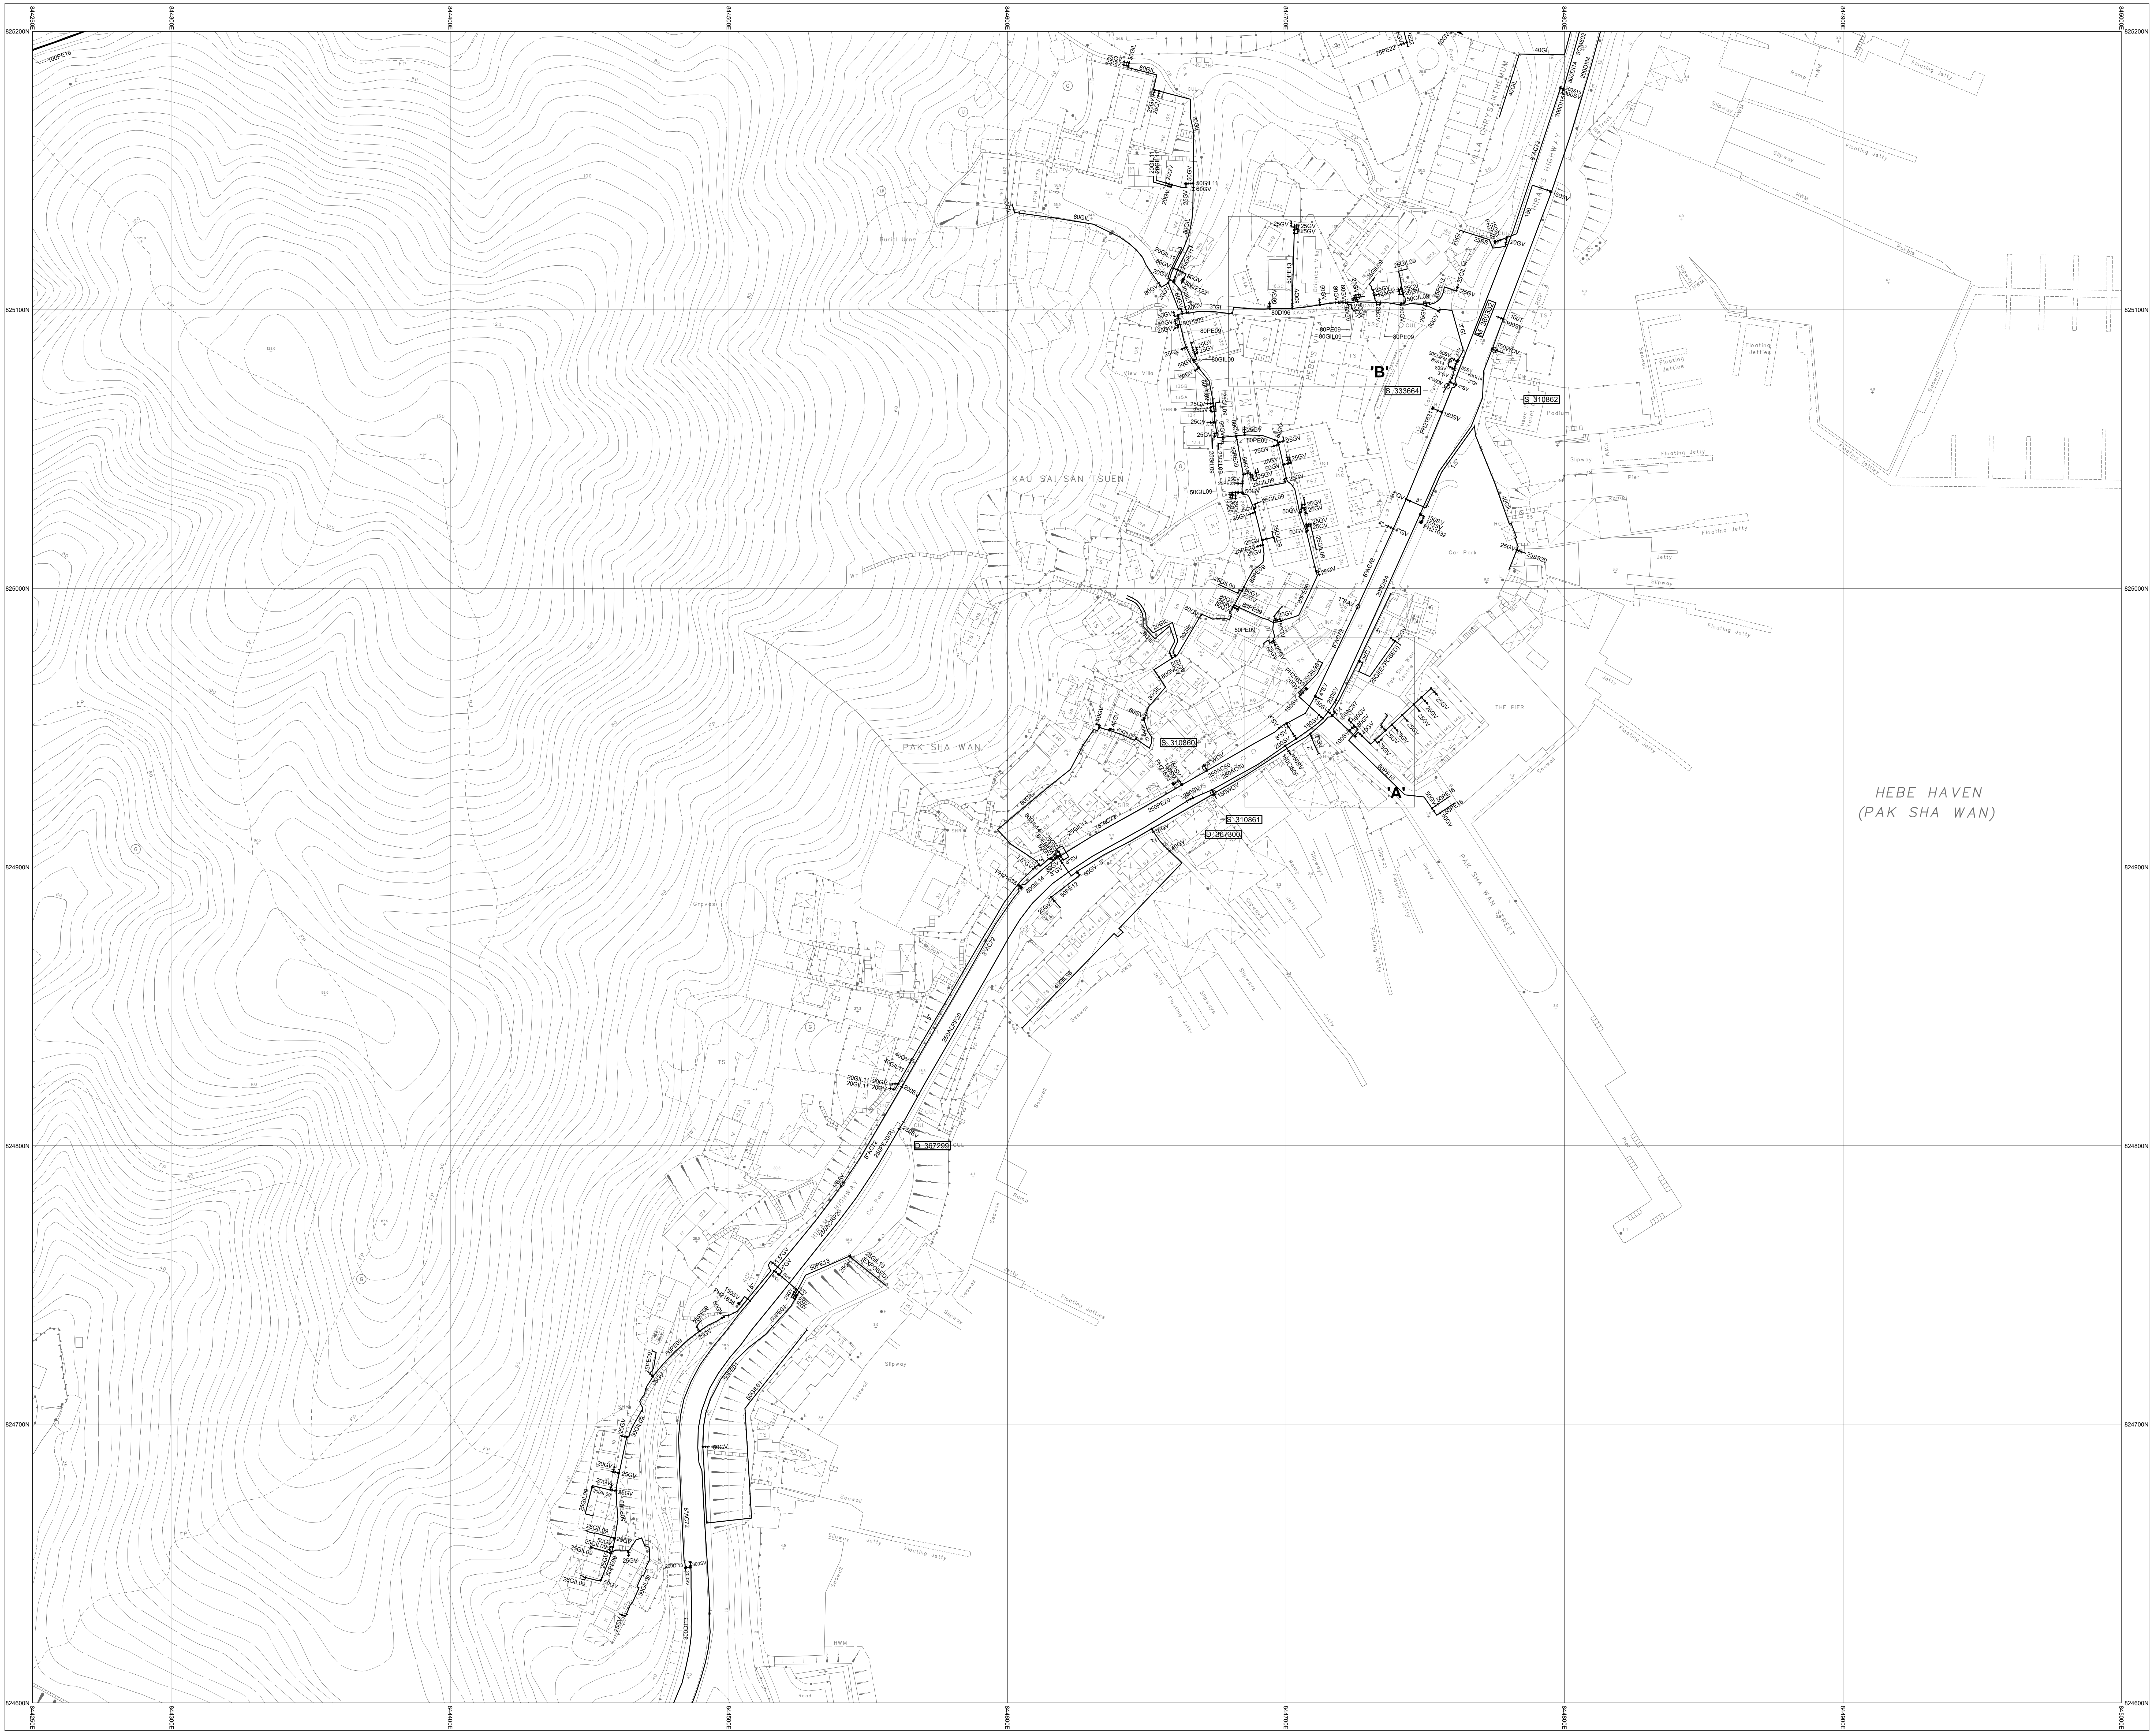
7-SE-25A
8-SW-21A
HEBE HAVEN
(PAK SHA WAN)
KAU SAI SAN TSUEN
PAK SHA WAN
'A'
'B'
S_310862
S_333664
S_310860
S_310861
D_367300
S_367299
825200N
825100N
825000N
824900N
824800N
824700N
824600N
844250E
844300E
844400E
844500E
844600E
844700E
844800E
844900E
845000E

7-SE-25D

NOTES:

1. FOR MAINS RECORDS SIGN CONVENTIONS AND DESIGNATIONS SEE SKETCH NO.3988.
2. DIMENSIONS OF MAINS ARE IN MILLIMETRES UNLESS OTHERWISE SPECIFIED.
3. ALL LEVELS ARE IN METRES ABOVE PRINCIPAL DATUM.

Basemap Date Updated On: 05/01/2026

SCALE 1:1 000

METRES 20 10 0 20 40 60 80 100 METRES

THIS IS A COMPUTER PRINTOUT,
NO SIGNATURE IS REQUIRED.

FRESH WATER MAINS RECORD PLAN

HIRAM'S HIGHWAY, KAU SAI SAN TSUEN

COPYRIGHT RESERVED

DATE REVISED : 04/06/2026

DRAWING NO.
W67880/ 7-SE-25B

SIGNED
C.H. NG
CE/MSE
DATE: 13/05/1999

Water Supplies Department
HONG KONG

© The Government of the Hong Kong SAR, Map reproduced with permission of the Director of Lands