INSET 'A'	INSET 'B'	INSET 'C'	INSET 'D'	INSET 'E'	INSET 'F'

3-SE-19B

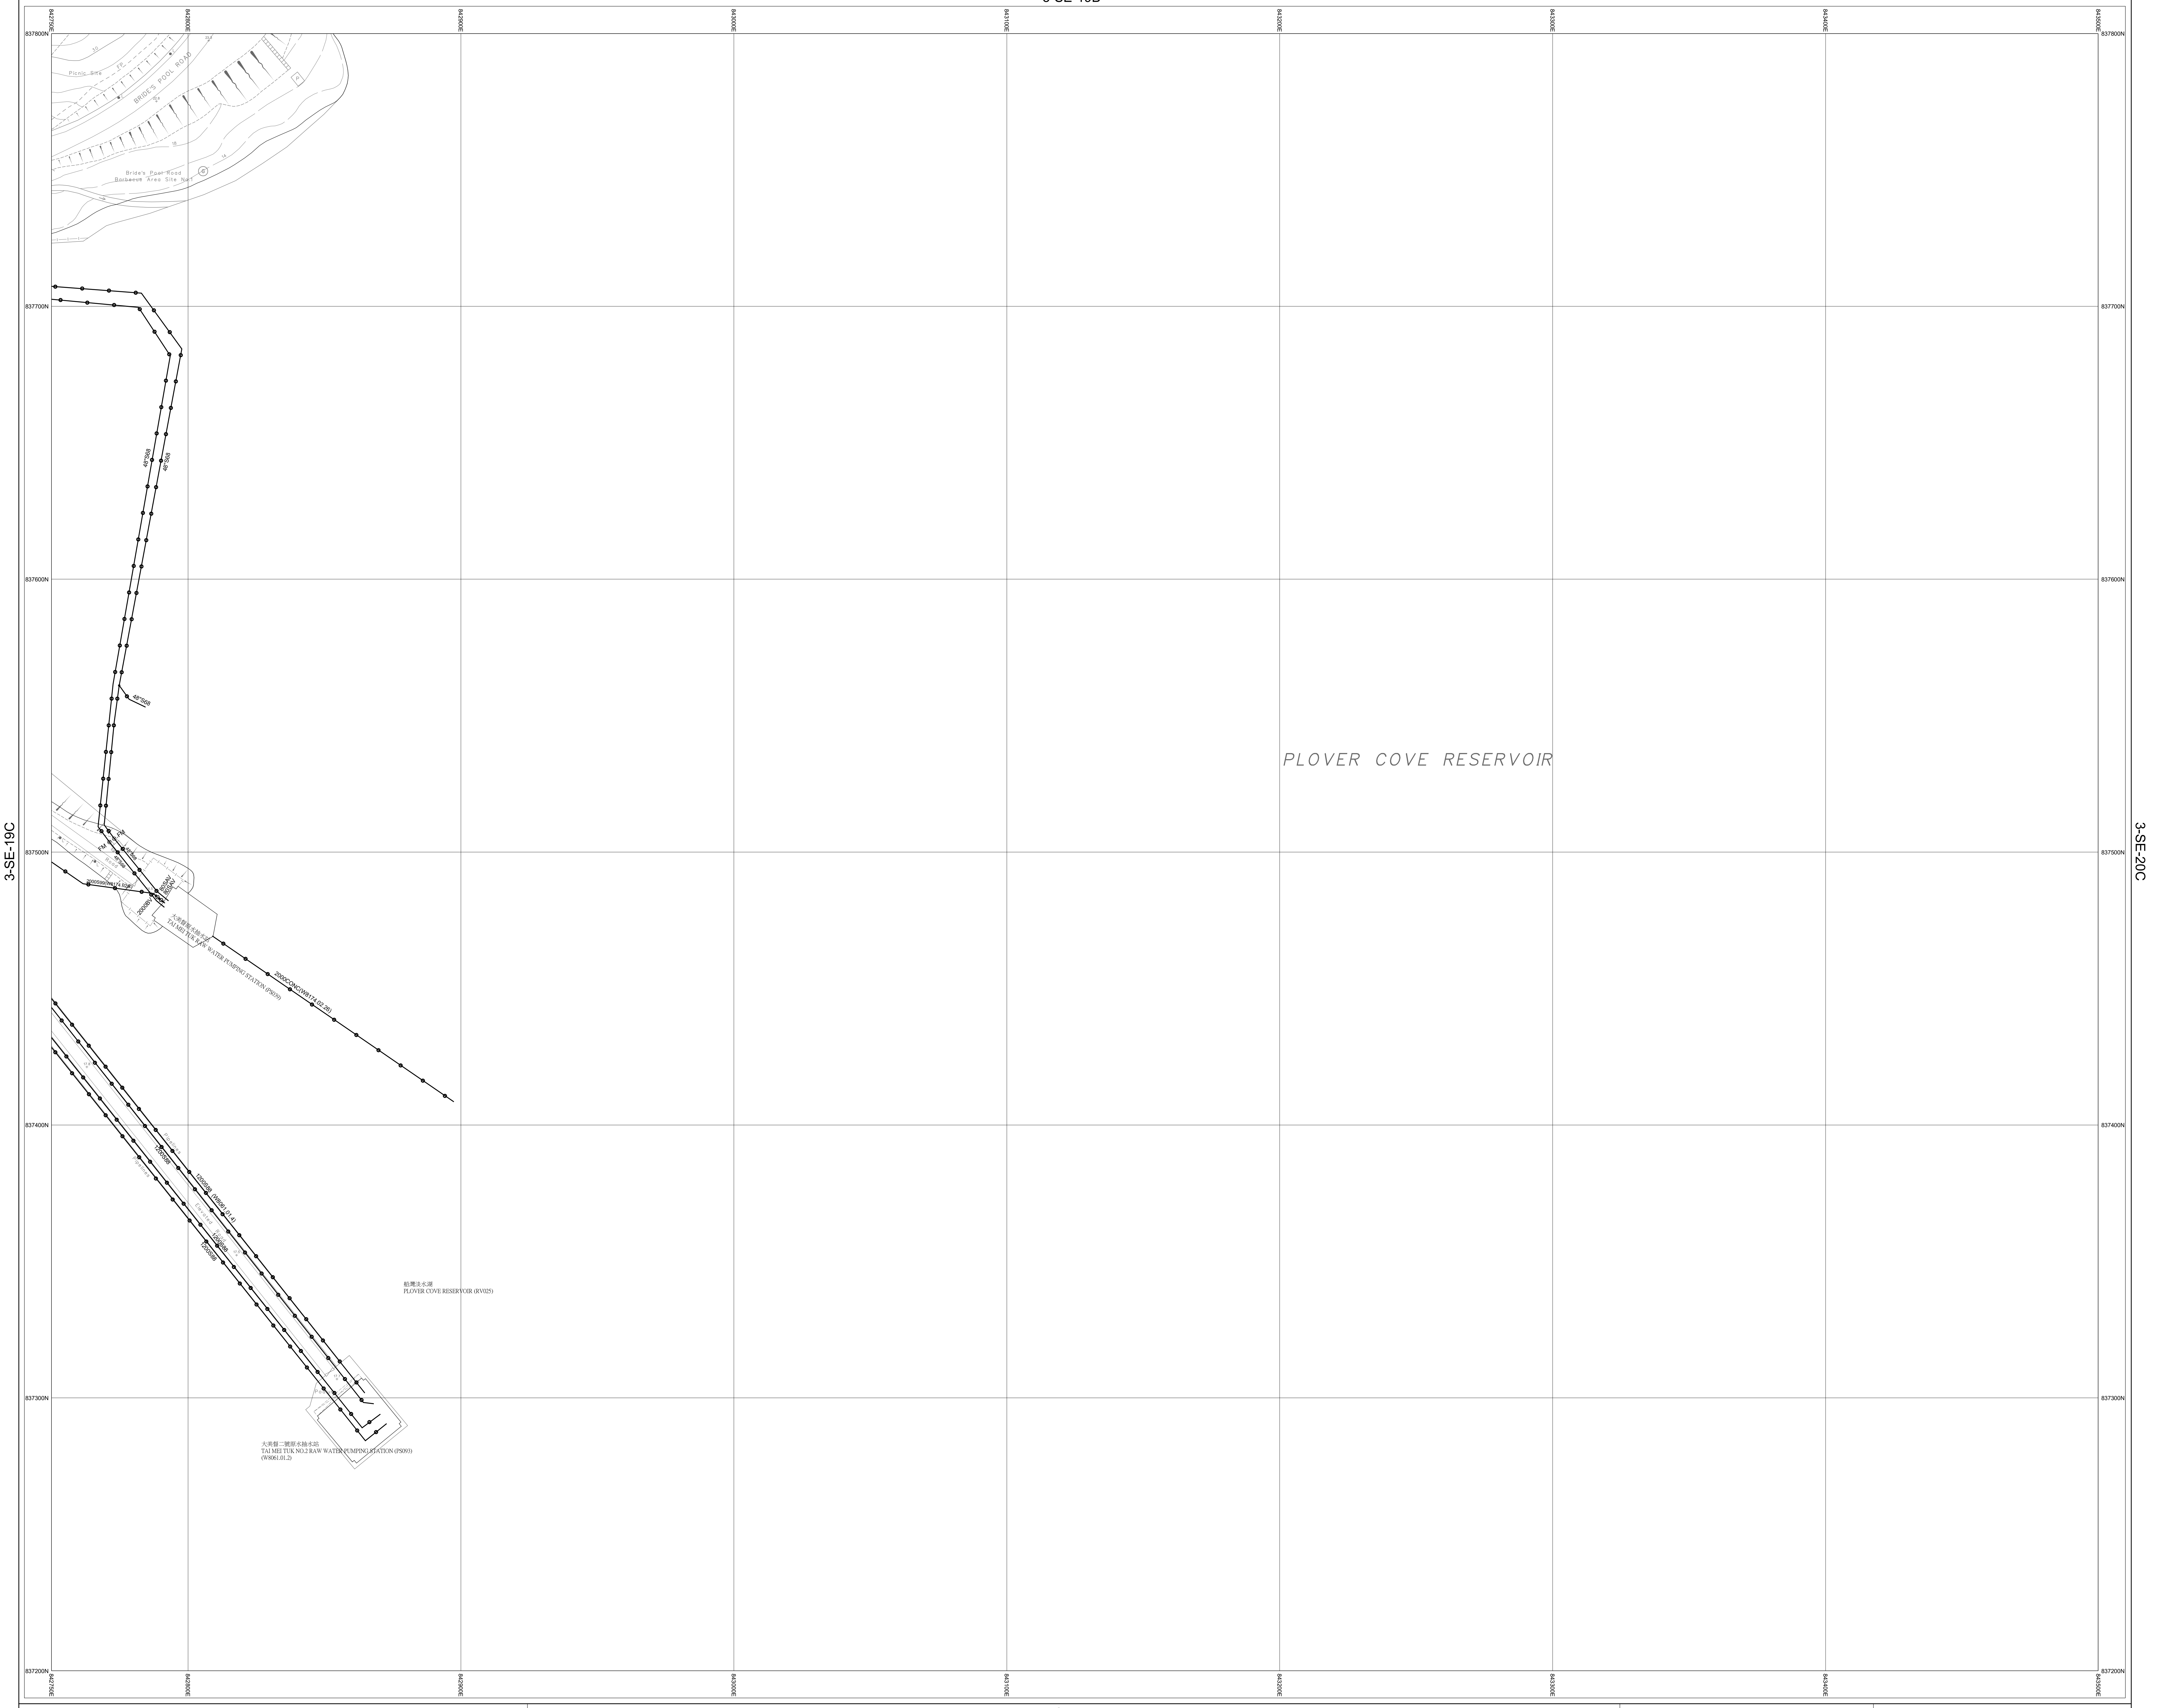
3-SE-19C
3-SE-20C
842750E
842800E
842900E
843000E
843100E
843200E
843300E
843400E
843500E
837800N
837700N
837600N
837500N
837400N
837300N
837200N
Picnic Site
FP
BRIDE'S POOL ROAD
Bride's Pool Road
Barbecue Area Site No.1
30
18
14
22.8
23.3
P
G
48"S68
48"S68
48"S68
FM
FM
48"S68
48"S68
Road
2000S99(W8174.02.2)
80SAV
80SAV
2000BV
大美督原水抽水站
TAI MEI TUK RAW WATER PUMPING STATION (PS039)
2000CONC(W8174.02.26)
17.8
Pipelines
1200S88
1200S88 (W8061.01.4)
Pipelines
Elevated Road
1200S88
1200S88
17.5
17.7
Podium
PLOVER COVE RESERVOIR
船灣淡水湖
PLOVER COVE RESERVOIR (RV025)
大美督二號原水抽水站
TAI MEI TUK NO.2 RAW WATER PUMPING STATION (PS093)
(W8061.01.2)

3-SE-24B

NOTES:

1. FOR MAINS RECORDS SIGN CONVENTIONS AND DESIGNATIONS SEE SKETCH NO.3988.
2. DIMENSIONS OF MAINS ARE IN MILLIMETRES UNLESS OTHERWISE SPECIFIED.
3. ALL LEVELS ARE IN METRES ABOVE PRINCIPAL DATUM.

Basemap Date Updated On: 23/12/2024

SCALE 1:1 000

METRES 20 10 0 20 40 60 80 100 METRES

THIS IS A COMPUTER PRINTOUT,
NO SIGNATURE IS REQUIRED.

FRESH WATER MAINS RECORD PLAN

TAI MEI TUK P/S

COPYRIGHT RESERVED

DATE REVISED : 30/12/2024

SIGNED
C.S. CHIN
CE/MNE
DATE: 09/11/1998

DRAWING NO.
W67880/ 3-SE-19D

Water Supplies Department
HONG KONG

© The Government of the Hong Kong SAR, Map reproduced with permission of the Director of Lands