INSET 'A'

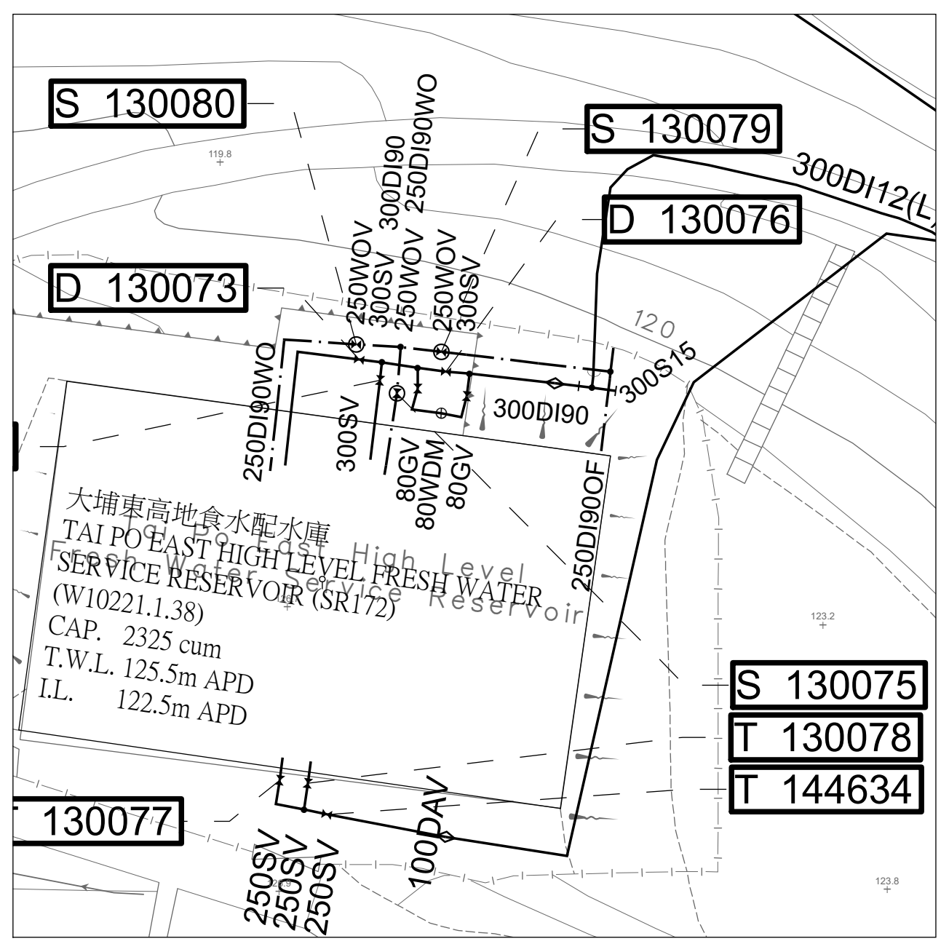
S 130080
S 130079
300DI12(L
D 130076
D 130073
250WOV
300SV
250WOV
250WOV
300SV
300DI90
250DI90WO
300S15
300DI90
250DI90WO
300SV
80GV
80WDM
80GV
250DI90OF
大埔東高地食水配水庫
TAI PO EAST HIGH LEVEL FRESH WATER
SERVICE RESERVOIR (SR172)
(W10221.1.38)
CAP. 2325 cum
T.W.L. 125.5m APD
I.L. 122.5m APD
Tai Po East High Level Fresh Water Service Reservoir
S 130075
T 130078
T 144634
130077
250SV
250SV
250SV
100DAV
120
119.8
123.2
123.8

Scale 1:500

INSET 'B'

INSET 'C'

INSET 'D'

INSET 'E'

INSET 'F'

3-SE-16C

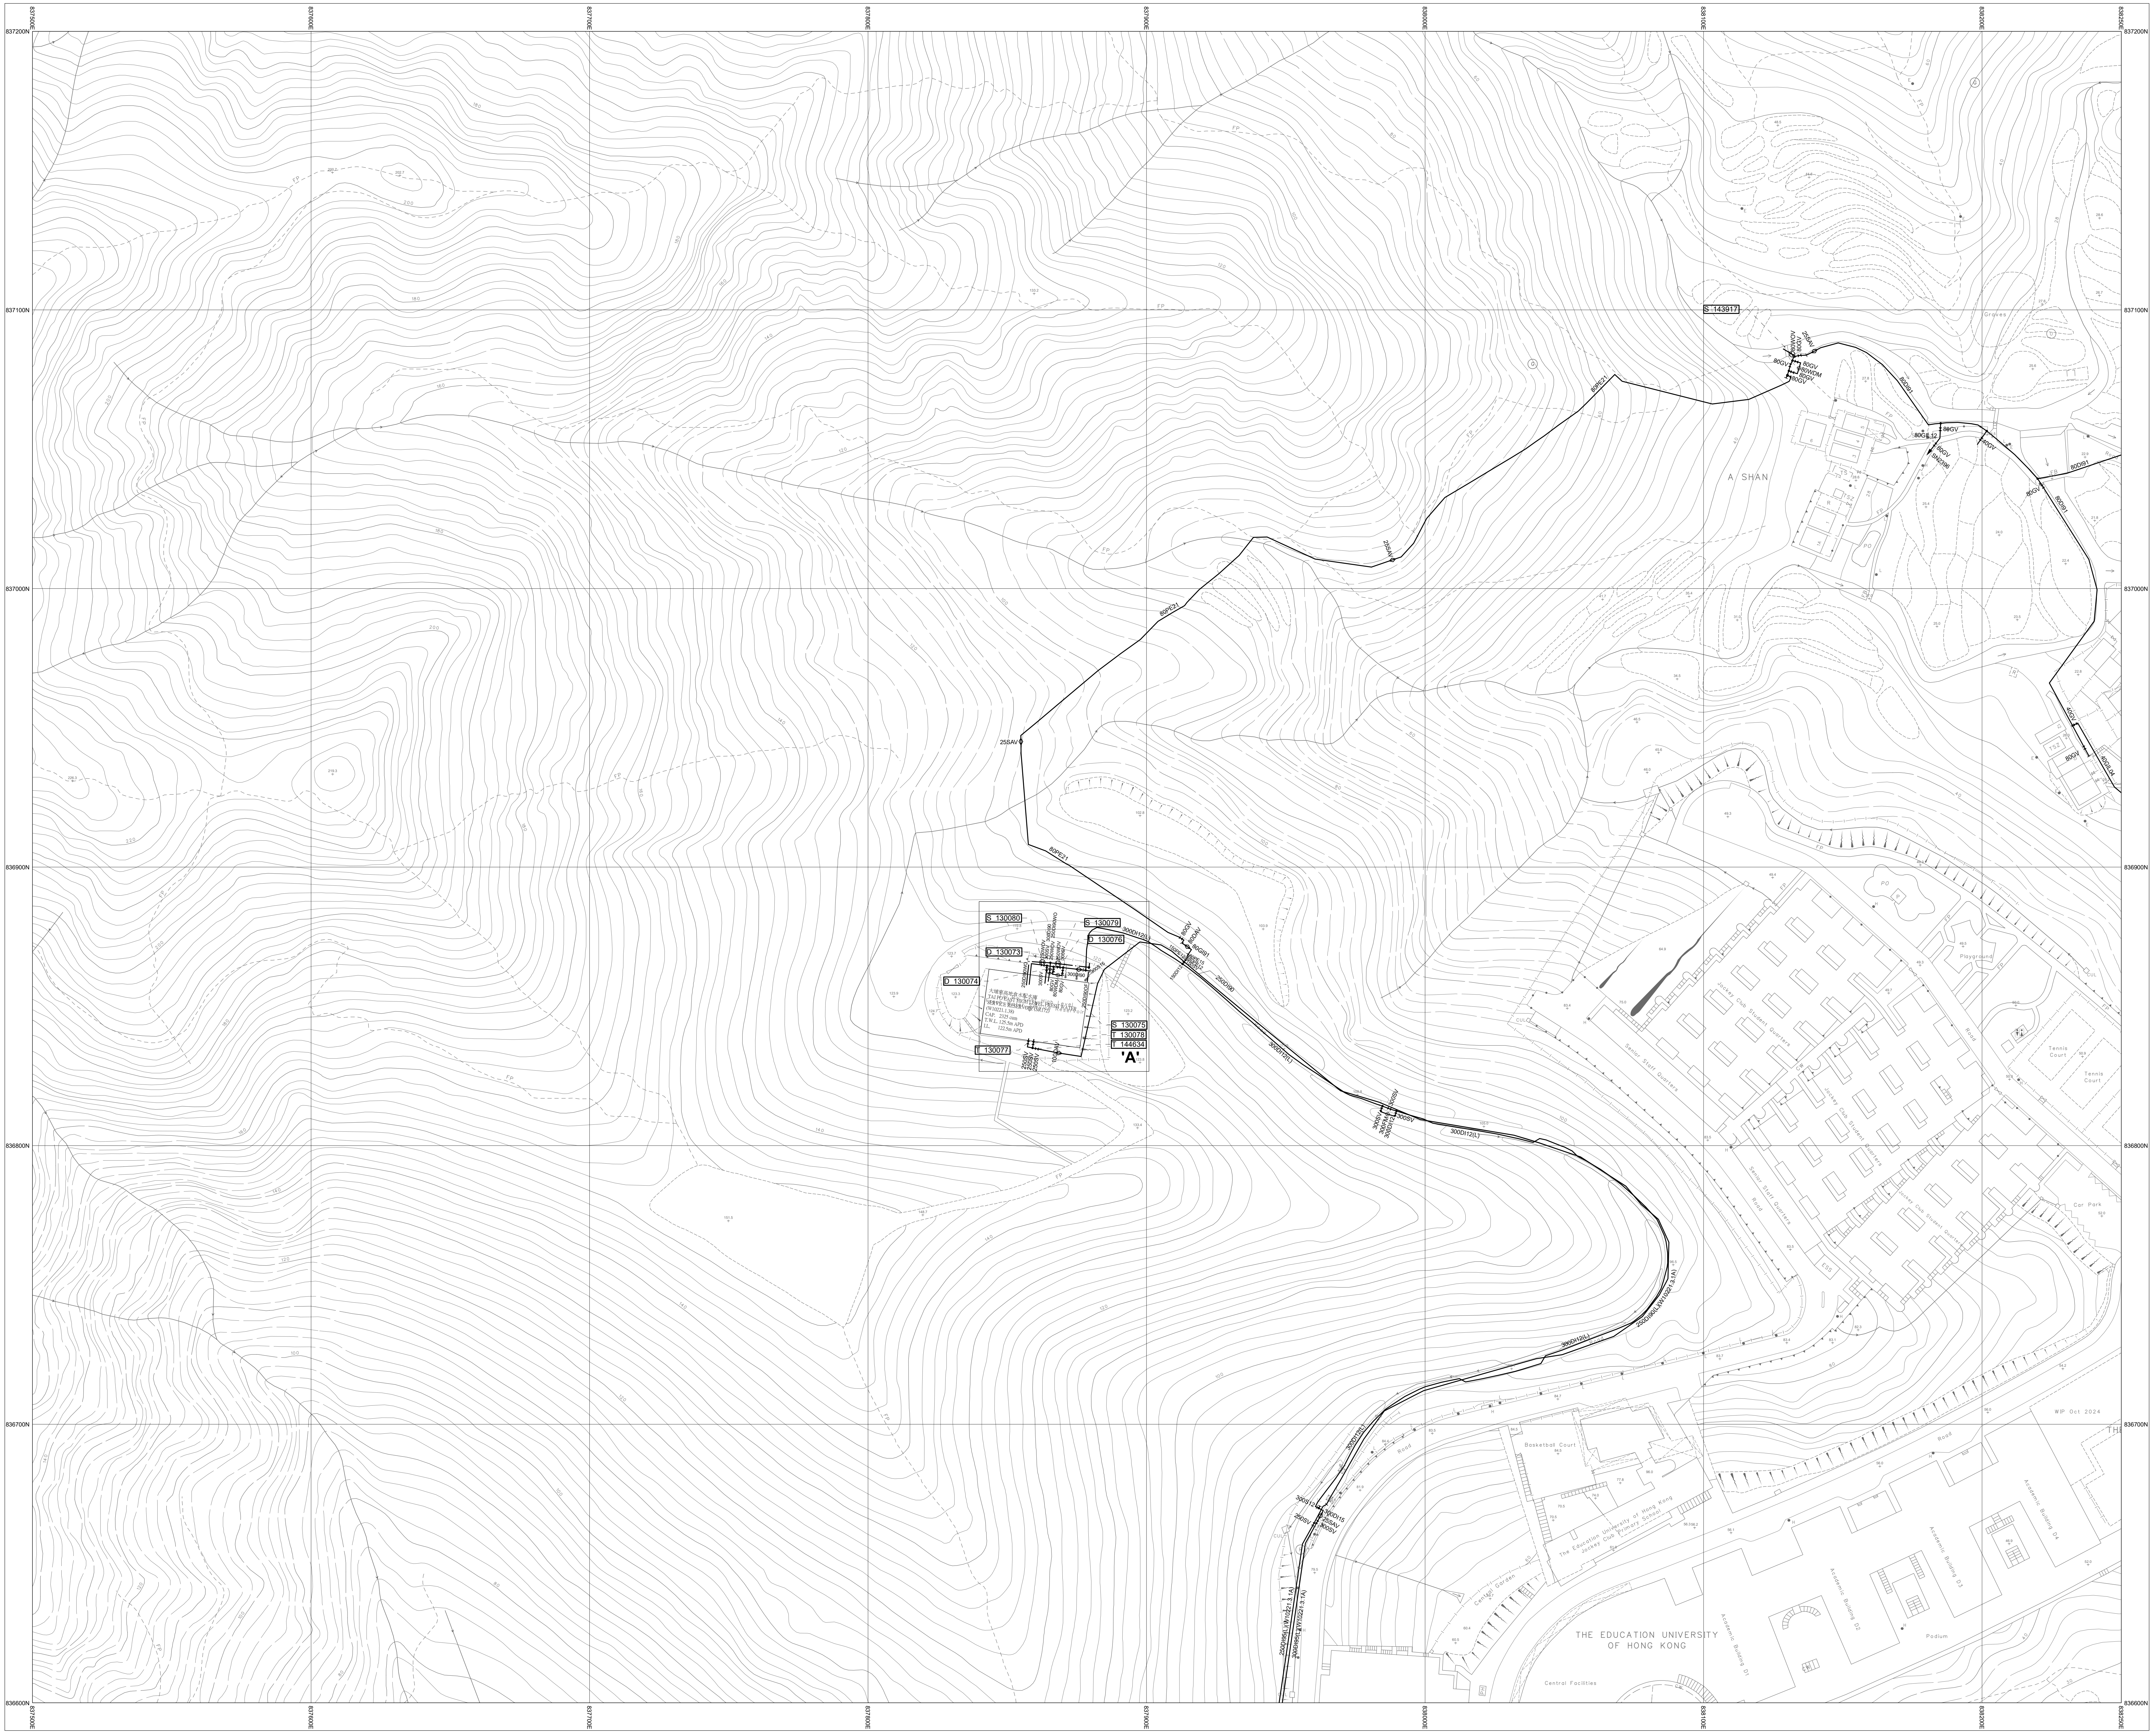
3-SW-25B
3-SE-21B
837500E
837600E
837700E
837800E
837900E
838000E
838100E
838200E
838250E
837200N
837100N
837000N
836900N
836800N
836700N
836600N
S 143917
A SHAN
255AV
'A'
S 130080
S 130079
D 130076
D 130073
D 130074
S 130075
T 130078
T 144634
T 130077
300DI12(L)
Basketball Court
Tennis Court
Car Park
Central Facilities
Podium
THE EDUCATION UNIVERSITY OF HONG KONG

3-SE-21C

NOTES:

1. FOR MAINS RECORDS SIGN CONVENTIONS AND DESIGNATIONS SEE SKETCH NO.3988.
2. DIMENSIONS OF MAINS ARE IN MILLIMETRES UNLESS OTHERWISE SPECIFIED.
3. ALL LEVELS ARE IN METRES ABOVE PRINCIPAL DATUM.

Basemap Date Updated On: 23/12/2024

SCALE 1:1 000

METRES 20 10 0 20 40 60 80 100 METRES

FRESH WATER MAINS RECORD PLAN

TSIU LAM, A SHAN

THIS IS A COMPUTER PRINTOUT,
NO SIGNATURE IS REQUIRED.

COPYRIGHT RESERVED

DATE REVISED : 04/03/2025

SIGNED C.S. CHIN
CE/MNE
DATE: 09/11/1998

DRAWING NO.
W67880/ 3-SE-21A

Water Supplies Department
HONG KONG

© The Government of the Hong Kong SAR, Map reproduced with permission of the Director of Lands