INSET 'A'

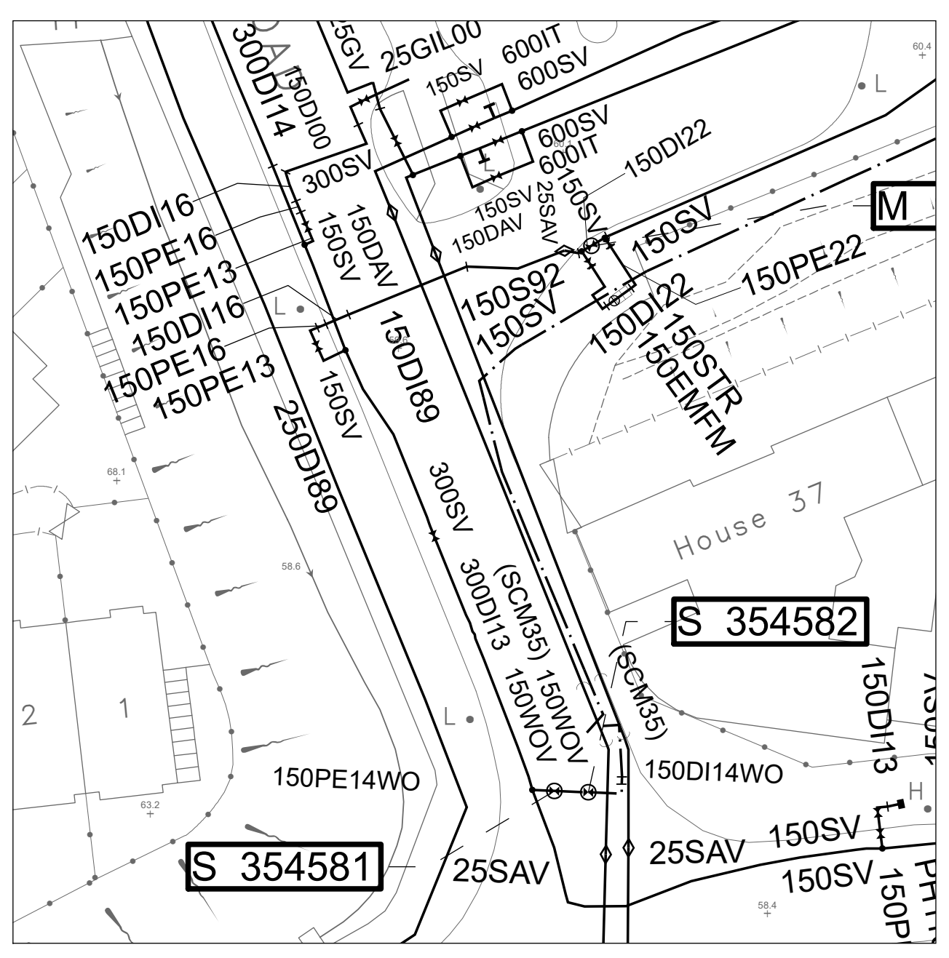

S 354582
S 354581
M
House 37
150PE14WO
150DI14WO
25SAV
150SV
150PE22
150DI22
150DI89
250DI89
150PE16
150PE13
150DI16
300SV
300DI13
150WOV
600SV
600IT
25GIL00

Scale 1:500

INSET 'B'

INSET 'C'

INSET 'D'

INSET 'E'

INSET 'F'

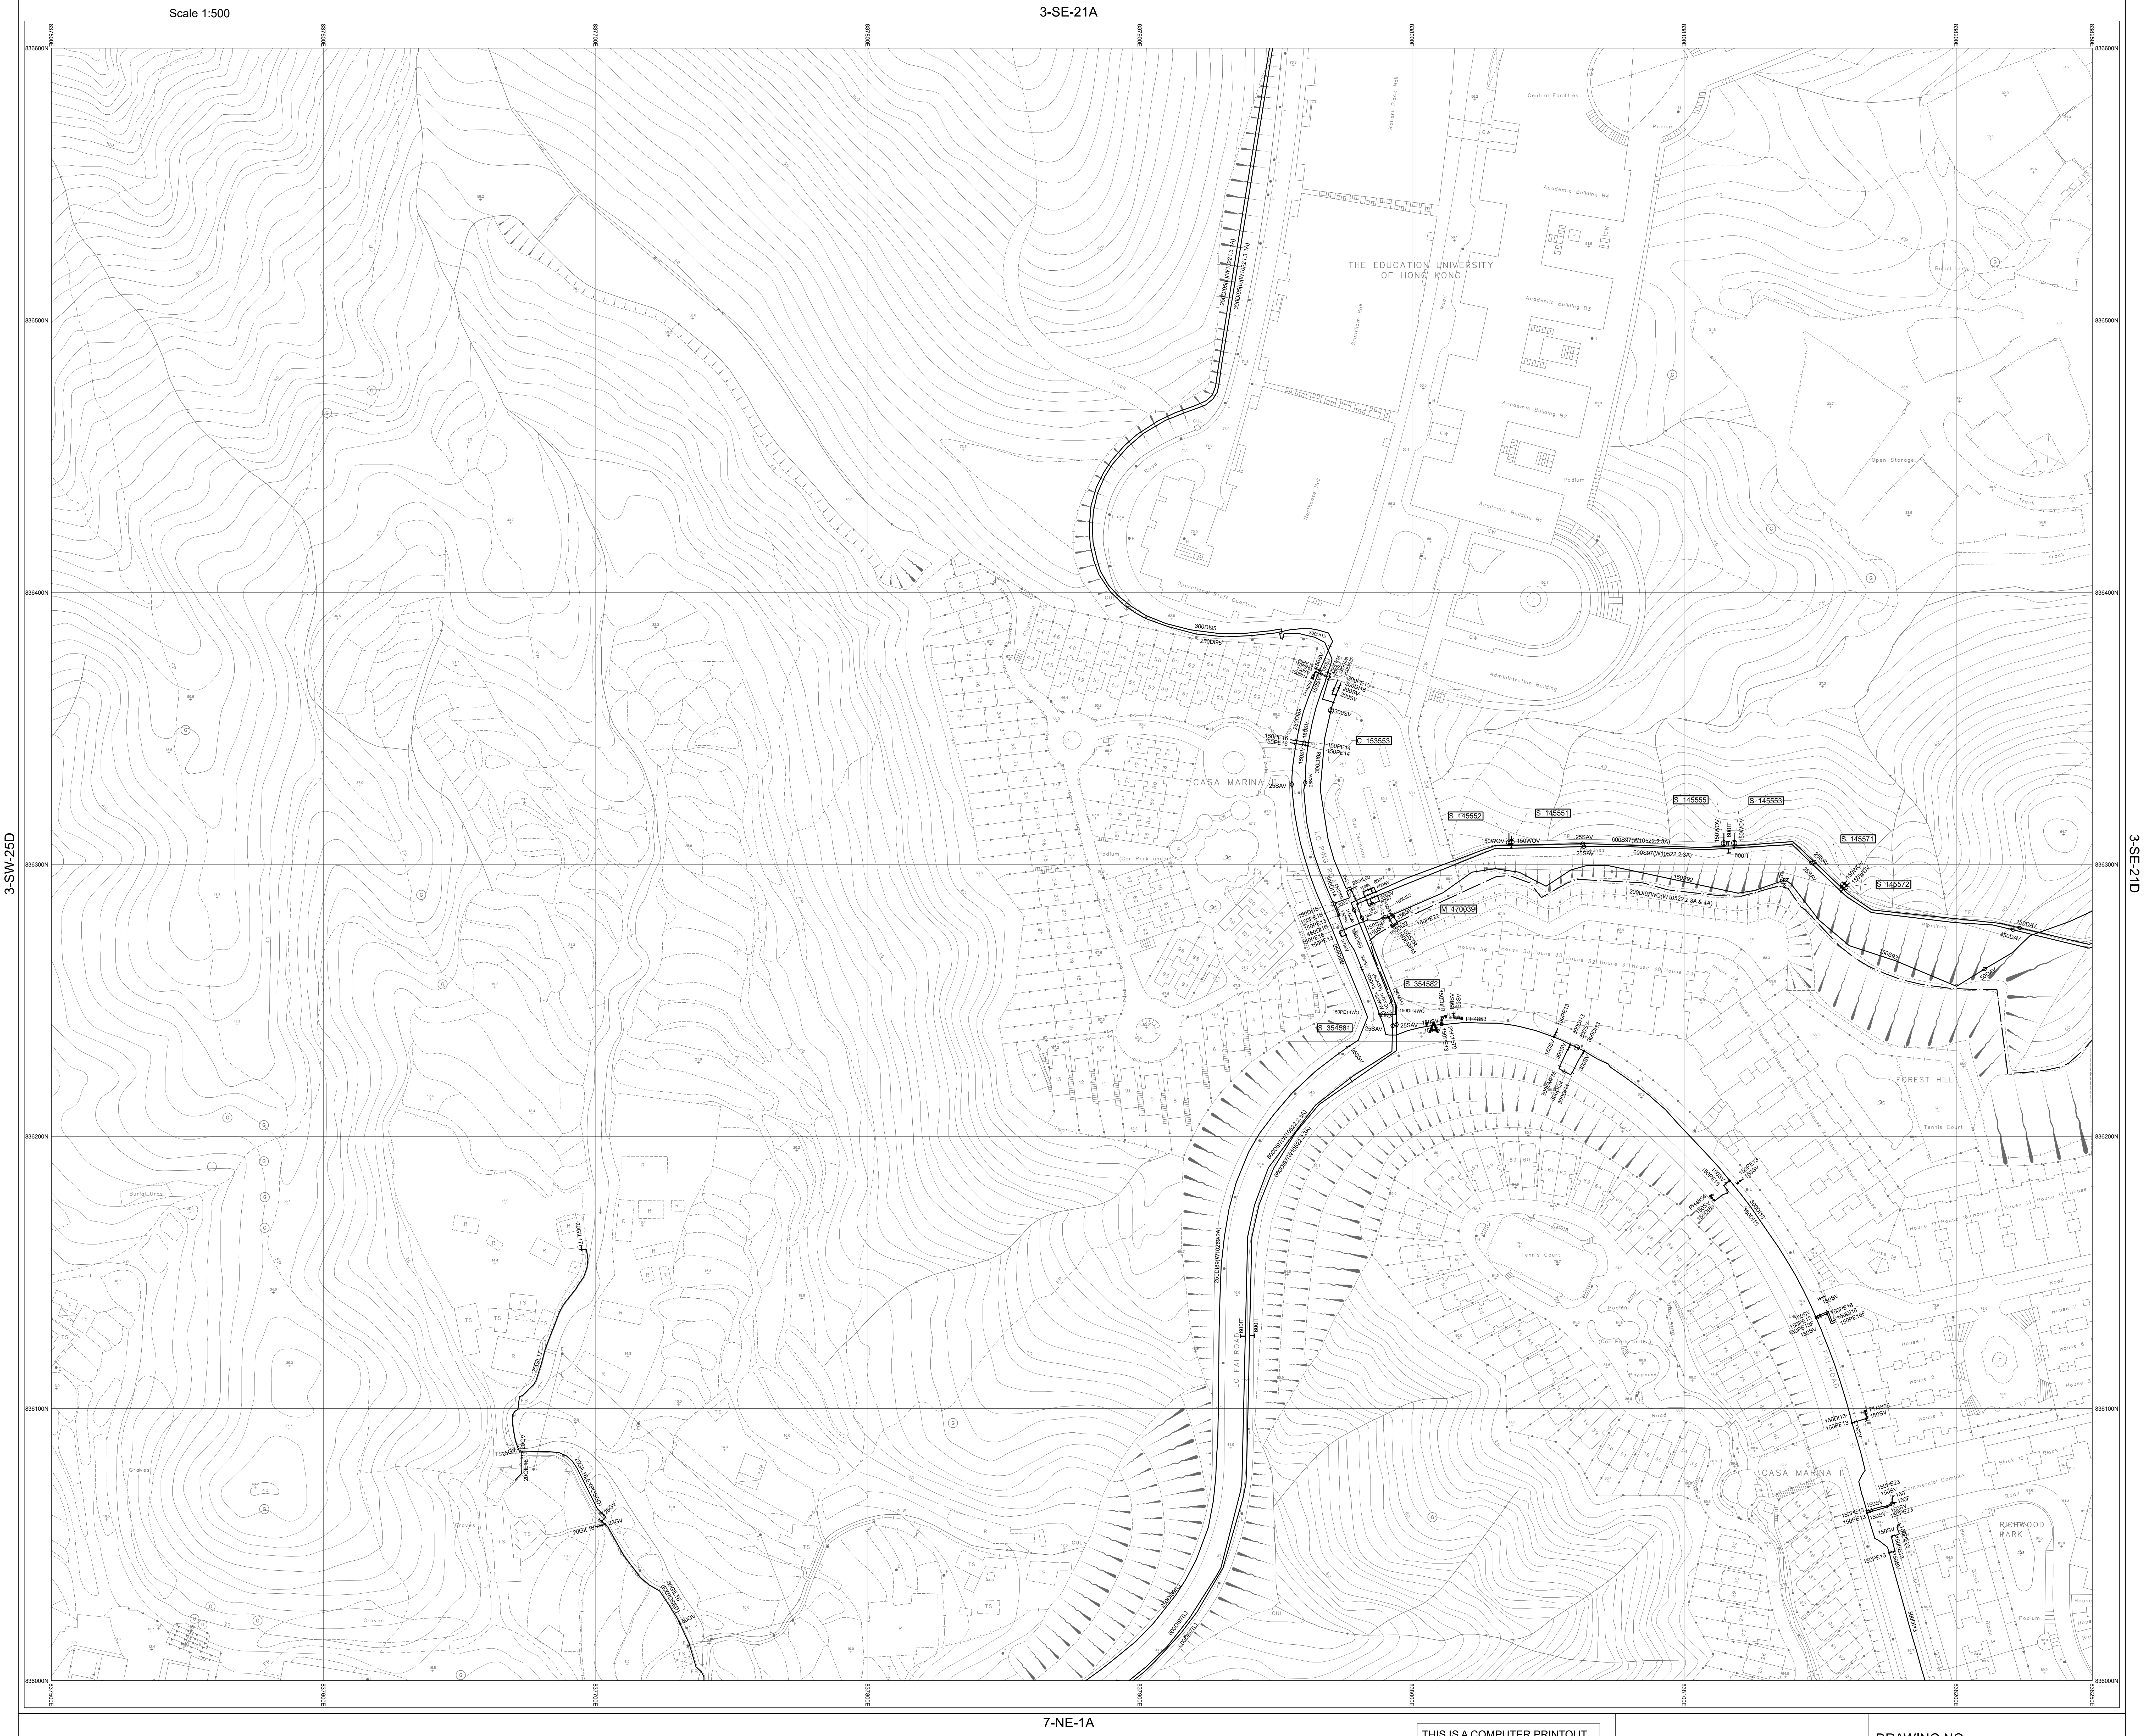

3-SE-21A
3-SW-25D
3-SE-21D
7-NE-1A
THE EDUCATION UNIVERSITY OF HONG KONG
CASA MARINA
FOREST HILL
RICHWOOD PARK
LO FAI ROAD
S 145552
S 145551
S 145550
S 145553
S 145571
S 145572
C 153553
M 370089
S 354582
S 354581
836600N
836500N
836400N
836300N
836200N
836100N
836000N

NOTES:

1. FOR MAINS RECORDS SIGN CONVENTIONS AND DESIGNATIONS SEE SKETCH NO.3988.
2. DIMENSIONS OF MAINS ARE IN MILLIMETRES UNLESS OTHERWISE SPECIFIED.
3. ALL LEVELS ARE IN METRES ABOVE PRINCIPAL DATUM.

Basemap Date Updated On: 05/01/2026

SCALE 1:1 000

METRES 20 10 0 20 40 60 80 100 METRES

THIS IS A COMPUTER PRINTOUT, NO SIGNATURE IS REQUIRED.

## FRESH WATER MAINS RECORD PLAN

HA HANG, TAI PO

COPYRIGHT RESERVED

DATE REVISED : 02/03/2026

SIGNED C.S. CHIN
CE/MNE
DATE: 09/11/1998

DRAWING NO.
W67880/ 3-SE-21C

Water Supplies Department
HONG KONG

© The Government of the Hong Kong SAR, Map reproduced with permission of the Director of Lands