INSET 'A'

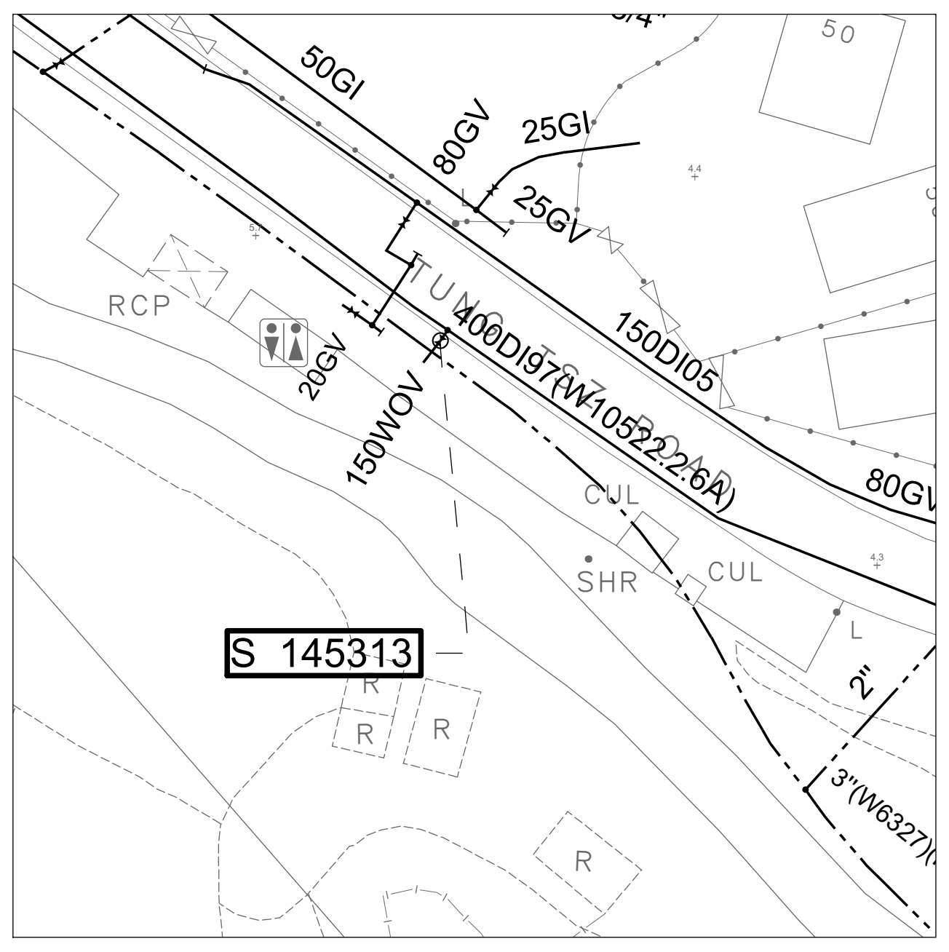
50GI
80GV
25GI
25GV
150DI05
400DI97(W10522.2.6A)
80GV
20GV
150WOV
RCP
SHR
CUL
S 145313
3"(W6327)

Scale 1:500

INSET 'B'

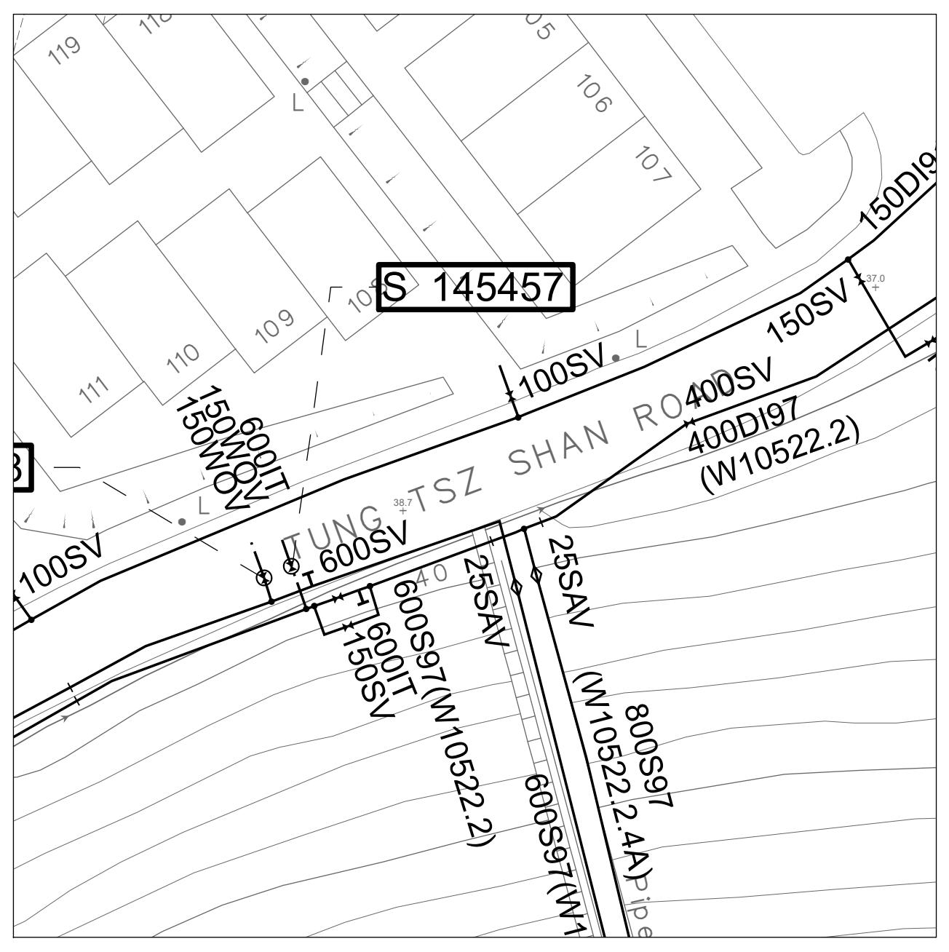
S 145457
150DI
150SV
100SV
400SV
400DI97
(W10522.2)
TUNG TSZ SHAN RO
100SV
600SV
600S97(W10522.2)
600IT
150SV
25SAV
25SAV
(W10522.2.4A)
800S97
600S97(W1

Scale 1:500

INSET 'C'

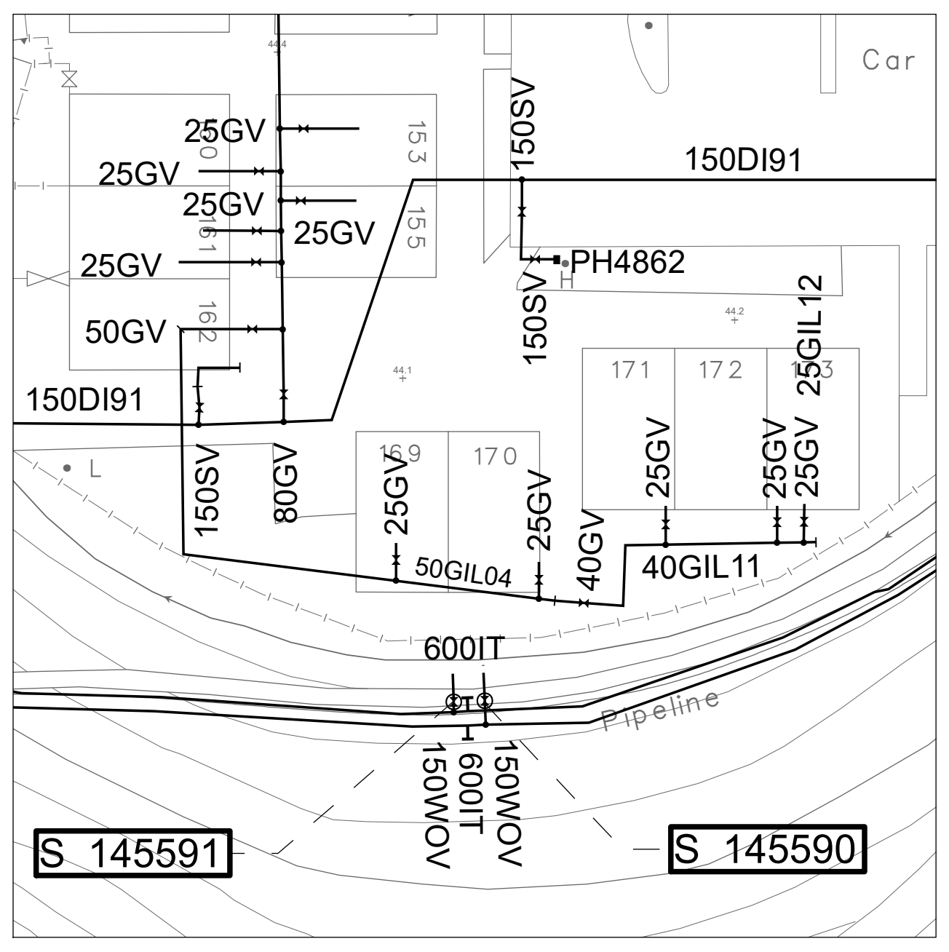
Car
25GV
25GV
25GV
25GV
25GV
50GV
150DI91
150SV
150DI91
PH4862
150SV
25GIL12
150SV
80GV
25GV
50GIL04
25GV
40GV
25GV
25GV
25GV
40GIL11
600IT
150WOV
600IT
150WOV
Pipeline
S 145591
S 145590

Scale 1:500

INSET 'D'

INSET 'E'

INSET 'F'

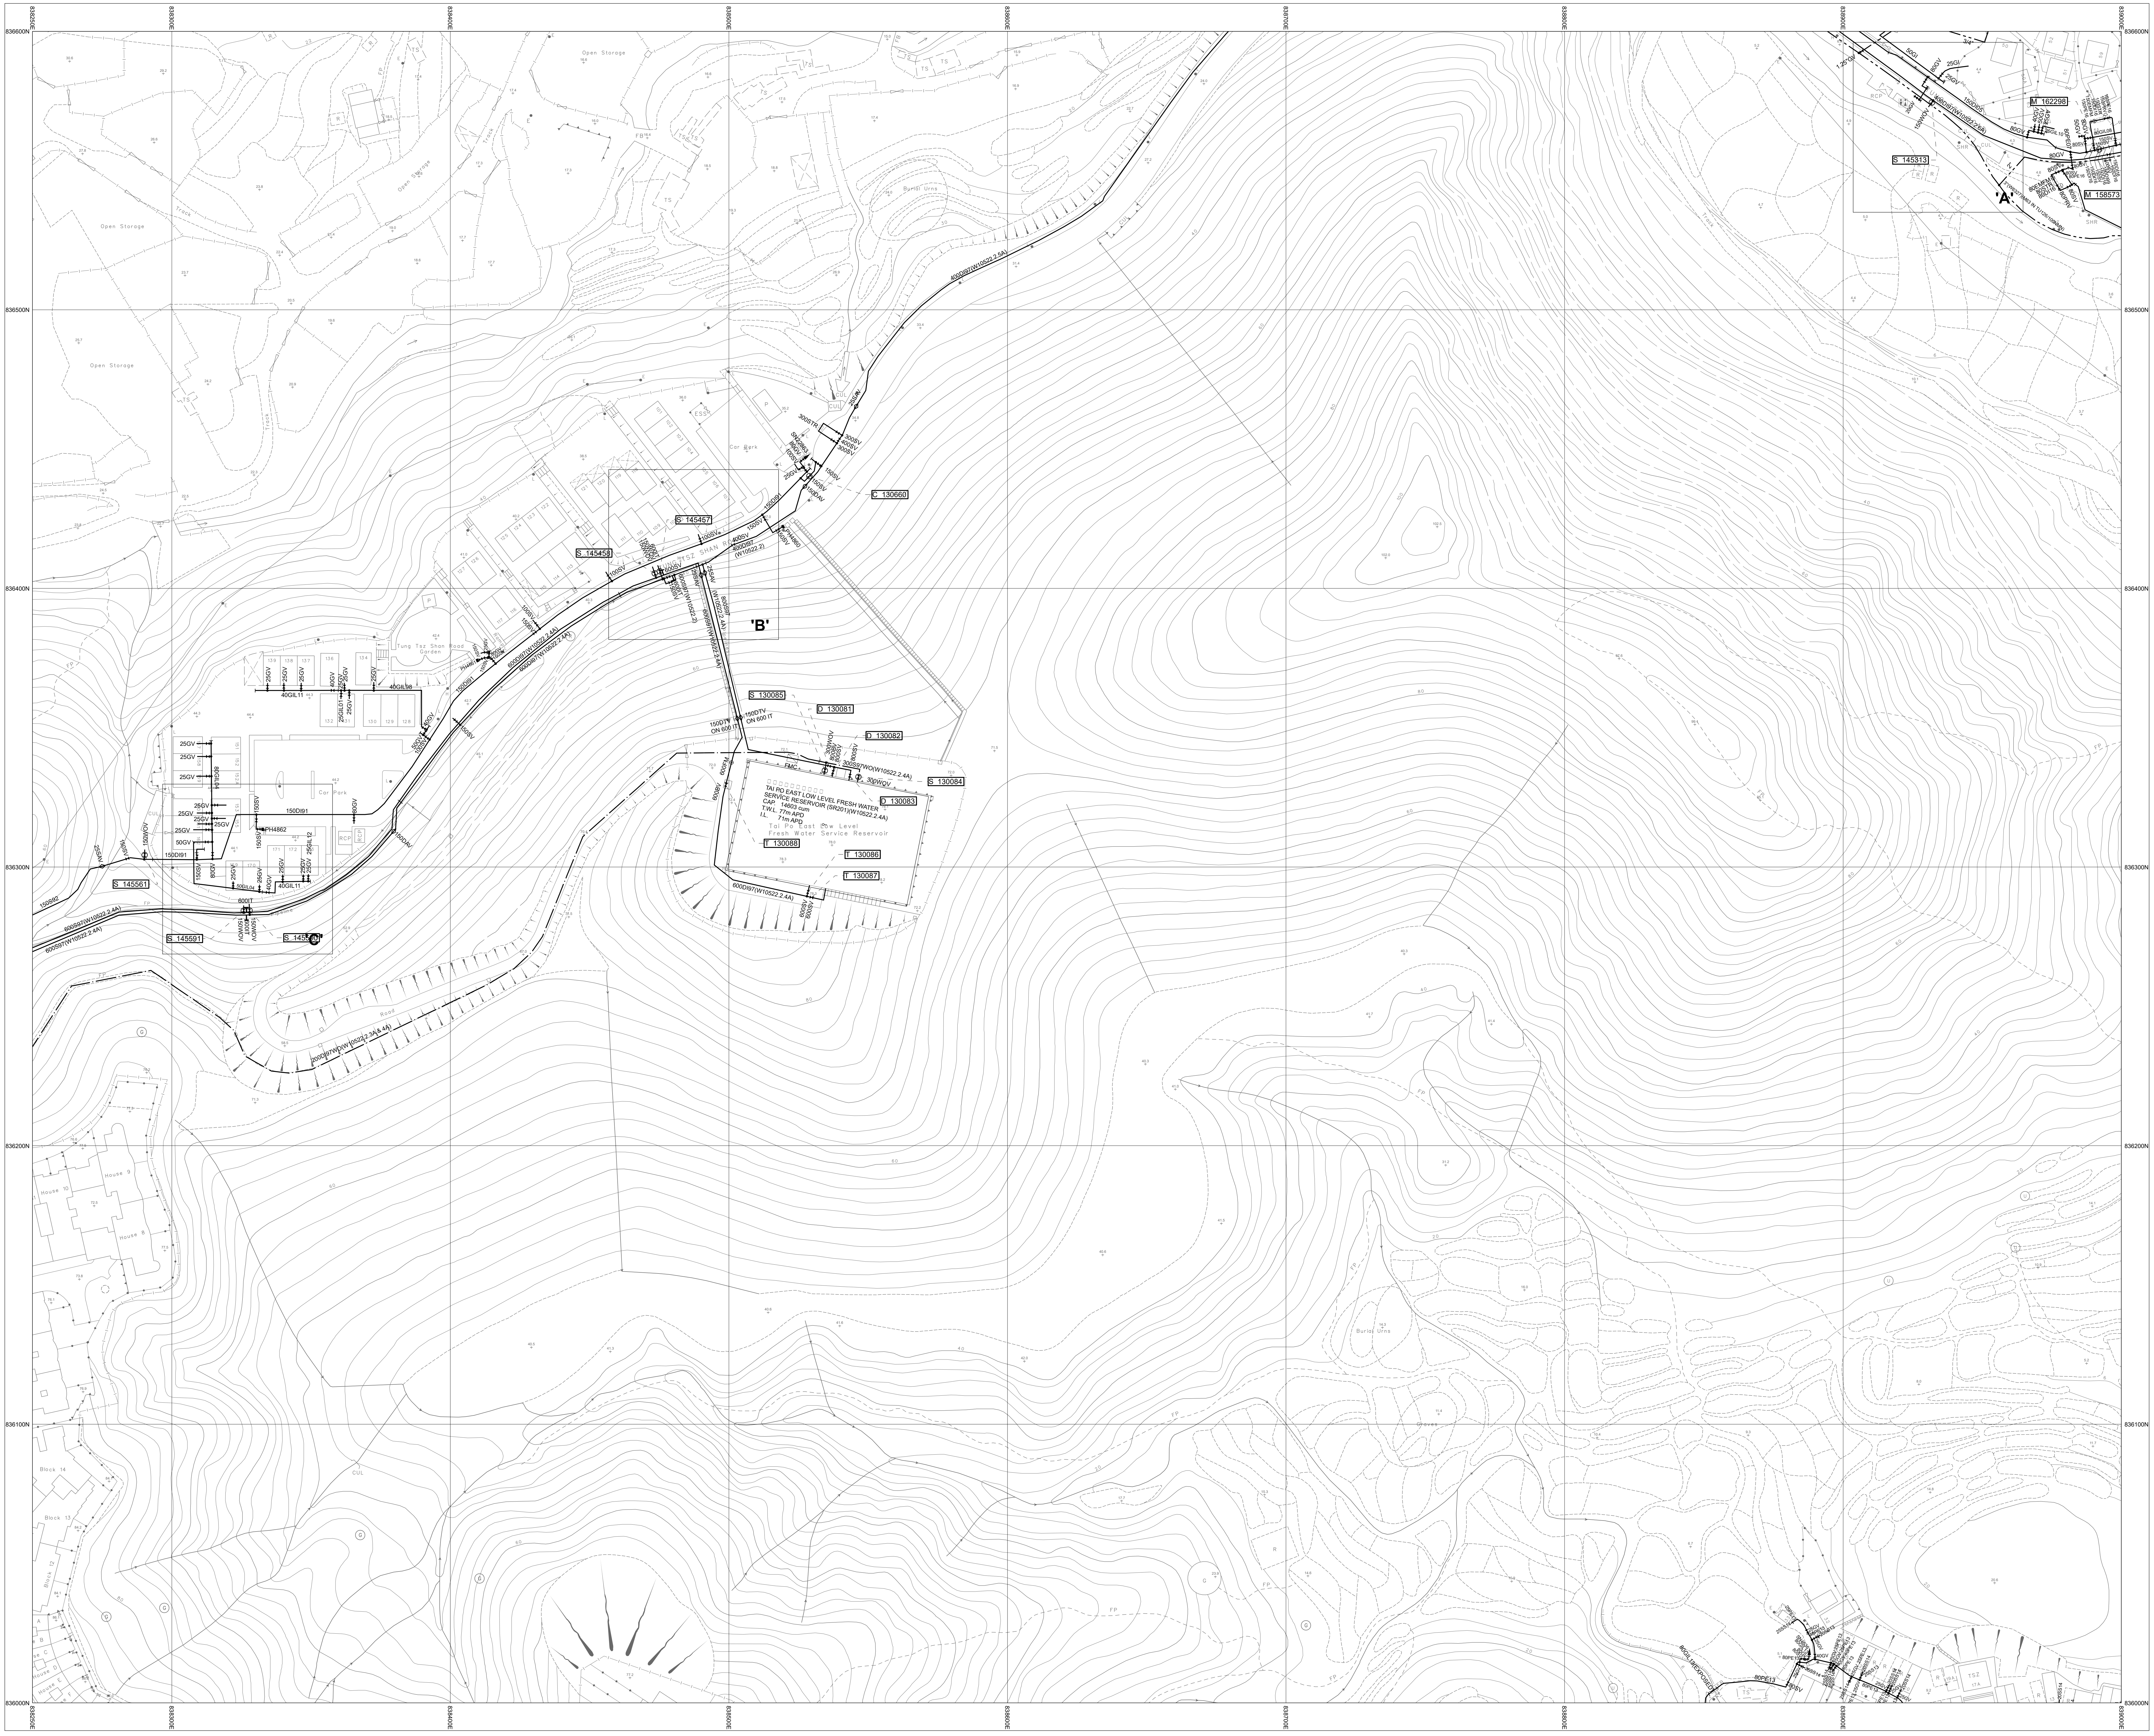
3-SE-21B
3-SE-21C
3-SE-22C
7-NE-1B
836600N
836500N
836400N
836300N
836200N
836100N
836000N
838250E
838300E
838400E
Open Storage
S 145313
M 162298
M 158673
'A'
C 130060
S 145457
S 145458
'B'
S 130085
D 130081
D 130082
S 130084
D 130083
150DTV ON 600 IT
150DTV ON 600 IT
300WOV
800BV
800SV
800SV
300S97WO(W10522.2.4A)
300WOV
FMC
600FM
600BV
TAI PO EAST LOW LEVEL FRESH WATER SERVICE RESERVOIR (SR201)(W10522.2.4A)
CAP. 14603 cum
T.W.L. 77m APD
I.L. 71m APD
Tai Po East Low Level Fresh Water Service Reservoir
T 130088
T 130086
T 130087
600DI97(W10522.2.4A)
600SV
600SV
Tung Tsz Shan Road
150DI91
PH4862
40GIL11
S 145591
S 145590
600IT
Burial Urns

7-NE-1B

NOTES:

1. FOR MAINS RECORDS SIGN CONVENTIONS AND DESIGNATIONS SEE SKETCH NO.3988.
2. DIMENSIONS OF MAINS ARE IN MILLIMETRES UNLESS OTHERWISE SPECIFIED.
3. ALL LEVELS ARE IN METRES ABOVE PRINCIPAL DATUM.

Basemap Date Updated On: 05/01/2026

SCALE 1:1 000

METRES 20 10 0 20 40 60 80 100 METRES

FRESH WATER MAINS RECORD PLAN

TUNG TSZ ROAD, WAI HA

THIS IS A COMPUTER PRINTOUT,
NO SIGNATURE IS REQUIRED.

COPYRIGHT RESERVED

DATE REVISED : 09/04/2026

SIGNED
C.S. CHIN
CE/MNE
DATE: 09/11/1998

DRAWING NO.
W67880/ 3-SE-21D

Water Supplies Department
HONG KONG

© The Government of the Hong Kong SAR, Map reproduced with permission of the Director of Lands