INSET 'A'	INSET 'B'	INSET 'C'	INSET 'D'	INSET 'E'	INSET 'F'

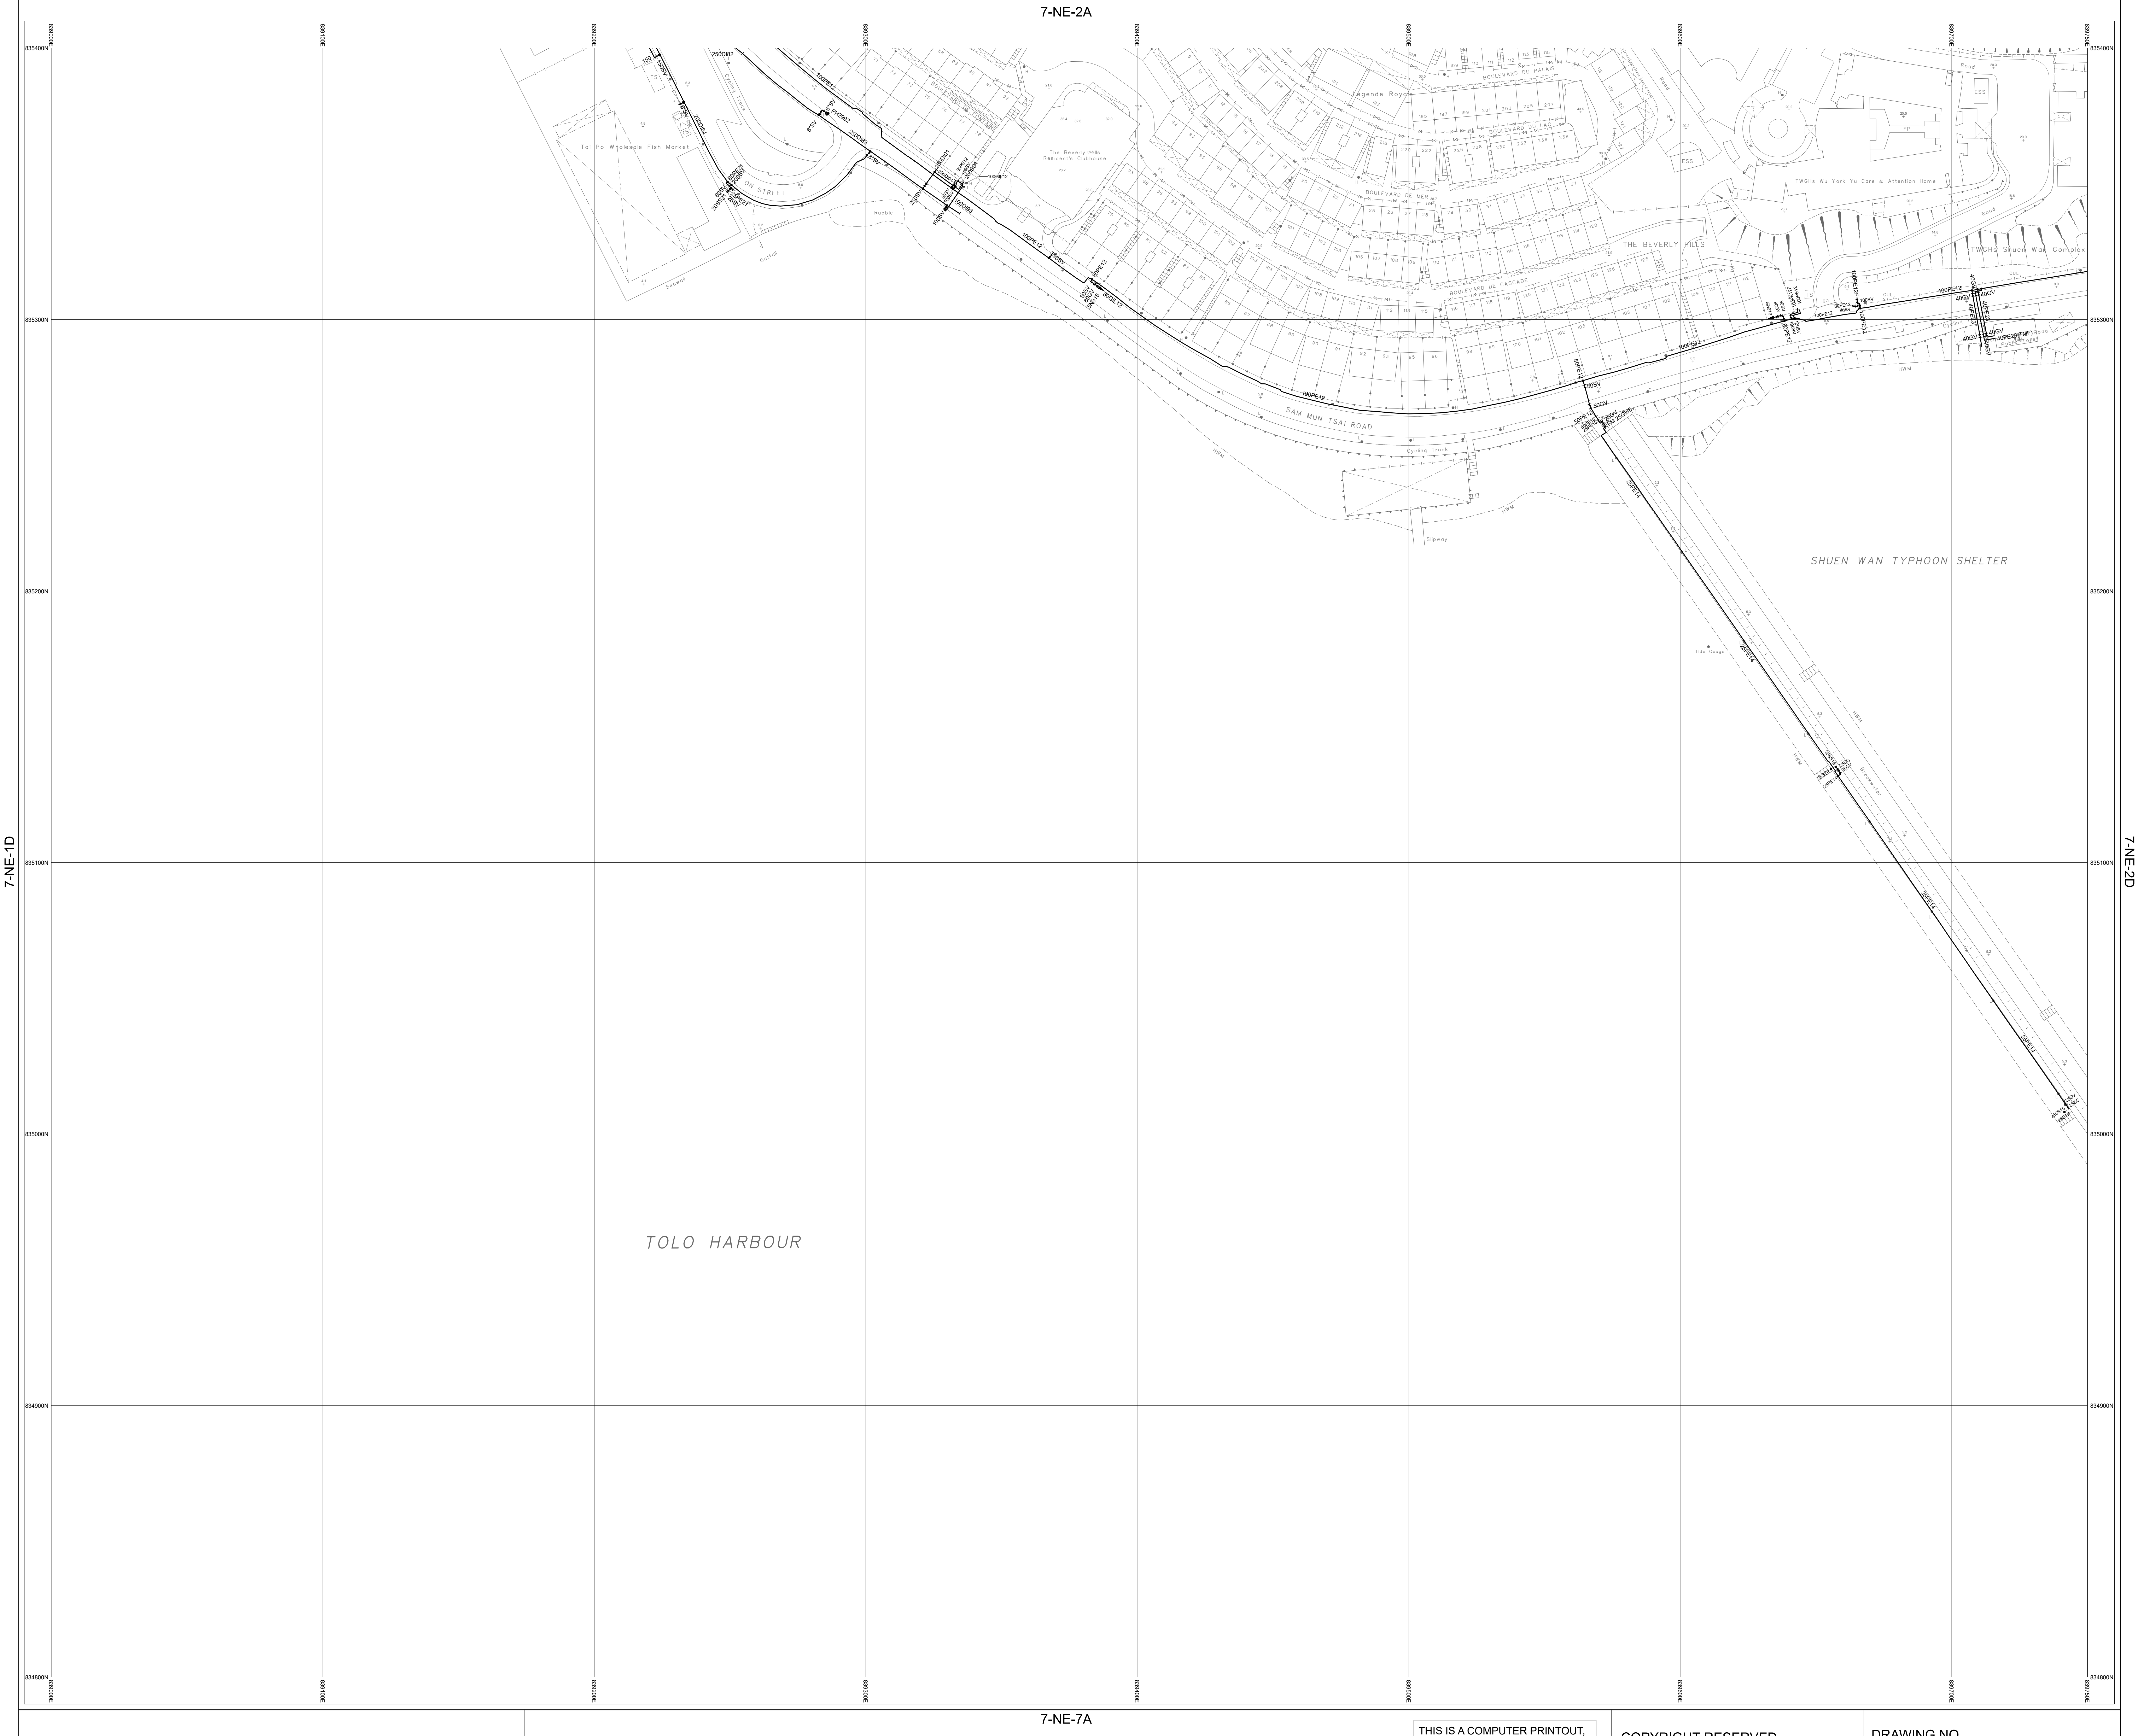
7-NE-2A
7-NE-7A
7-NE-1D
7-NE-2D
839200E
839300E
839400E
839500E
839600E
839700E
839750E
835400N
835300N
835200N
835100N
835000N
834900N
834800N
Tai Po Wholesale Fish Market
Seawall
Outfall
Rubble
Cycling Track
The Beverly Hills Resident's Clubhouse
BOULEVARD DE FONTAINE
BOULEVARD DU PALAIS
BOULEVARD DU LAC
BOULEVARD DE MER
BOULEVARD DE CASCADE
Legende Royale
THE BEVERLY HILLS
TWGHs Wu York Yu Care & Attention Home
TWGHs Shuen Wan Complex
Public Toilet
SAM MUN TSAI ROAD
Slipway
Tide Gauge
HWM
SHUEN WAN TYPHOON SHELTER
TOLO HARBOUR
250DI82
150SV
200DI84
6"SV
PH2992
250DI83
8"SV
250DI01
200DI01
100GIL12
250SV
100DI93
100SV
100PE12
80SV
80PE12
80GV
SN918
80GIL12
80PE21
200SV
20SS21
25PE21
25SV
50GV
50PE12
25GV
FM 25GI86
25PE14
SN919
100PE12F
40GV
40PE23
40PE23(TMF)

NOTES:

1. FOR MAINS RECORDS SIGN CONVENTIONS AND DESIGNATIONS SEE SKETCH NO.3988.
2. DIMENSIONS OF MAINS ARE IN MILLIMETRES UNLESS OTHERWISE SPECIFIED.
3. ALL LEVELS ARE IN METRES ABOVE PRINCIPAL DATUM.

Basemap Date Updated On: 23/12/2024

SCALE 1:1 000

METRES 20 10 0 20 40 60 80 100 METRES

THIS IS A COMPUTER PRINTOUT,
NO SIGNATURE IS REQUIRED.

FRESH WATER MAINS RECORD PLAN

SAM MUN TSAI ROAD

COPYRIGHT RESERVED

DATE REVISED : 30/12/2024

SIGNED

C.S. CHIN
CE/MNE

DATE: 23/04/1999

DRAWING NO.

W67880/ 7-NE-2C

Water Supplies Department
HONG KONG

© The Government of the Hong Kong SAR, Map reproduced with permission of the Director of Lands