INSET 'A'	INSET 'B'	INSET 'C'	INSET 'D'	INSET 'E'	INSET 'F'

7-NE-12A

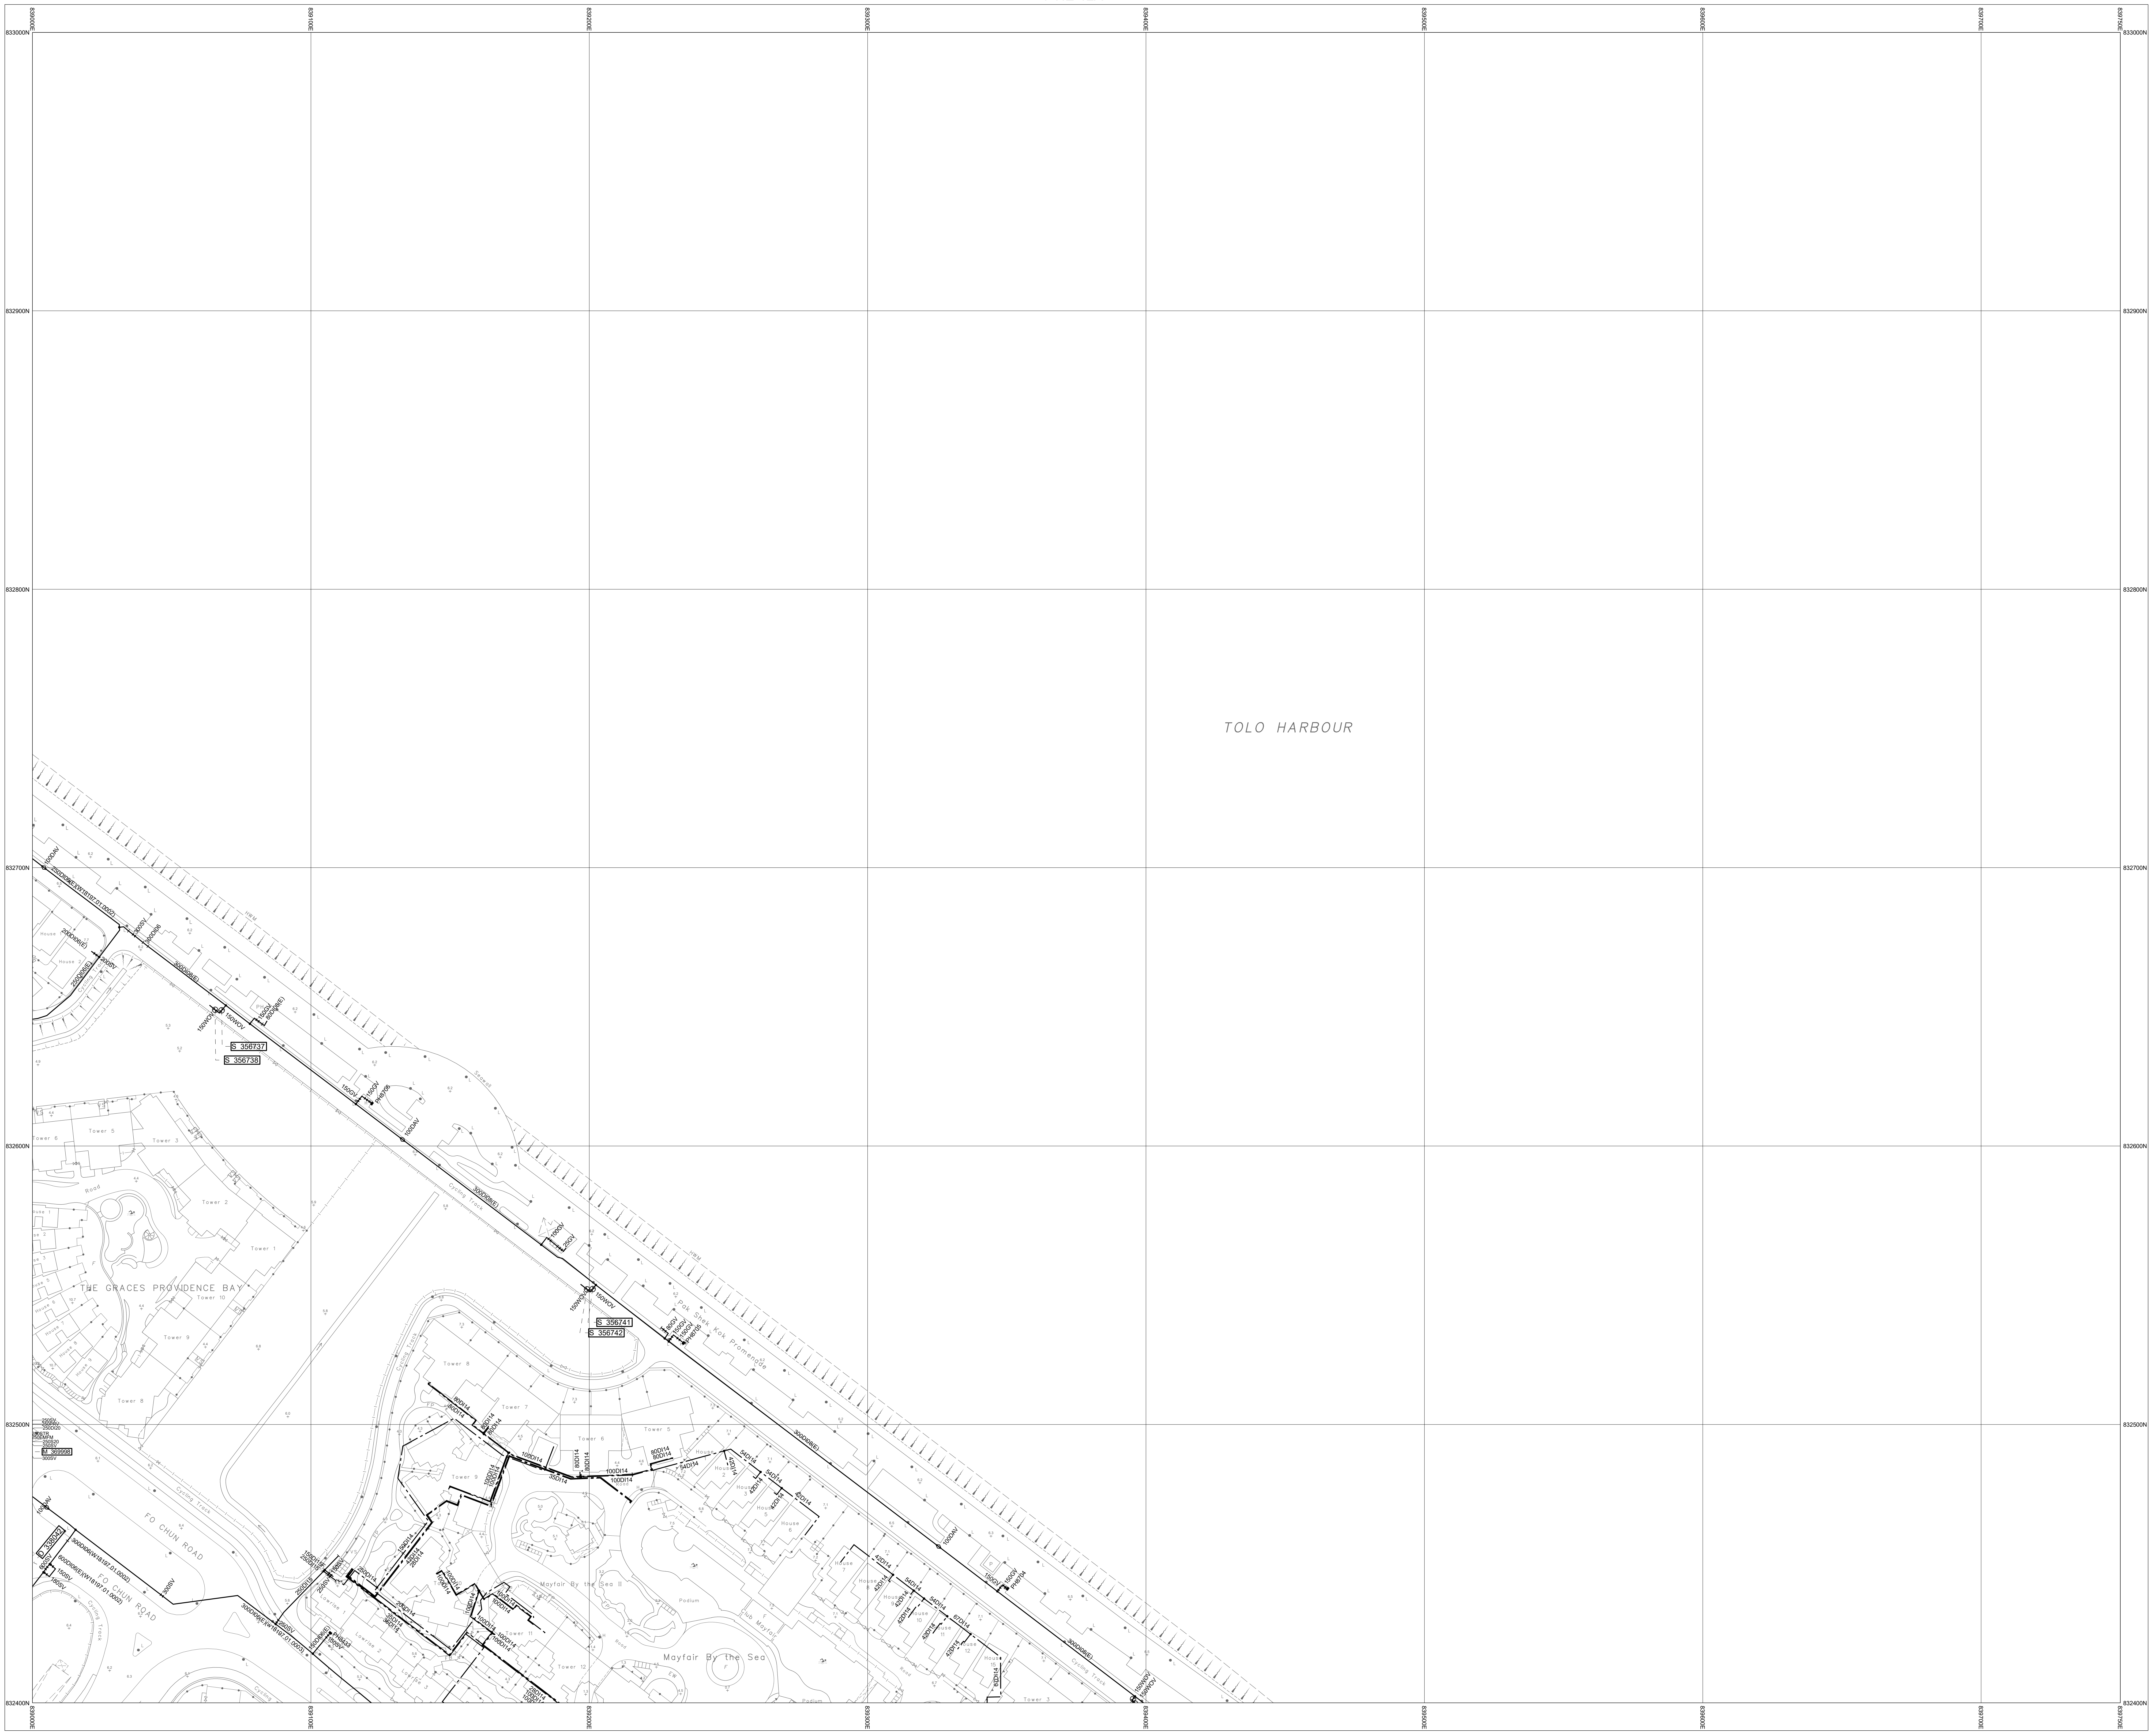
839000E
839100E
839200E
839300E
839400E
839500E
839600E
839700E
833000N
832900N
832800N
832700N
832600N
832500N
832400N
TOLO HARBOUR
THE GRACES PROVIDENCE BAY
Tower 1
Tower 2
Tower 3
Tower 5
Tower 6
Tower 8
Tower 9
Tower 10
Seawall
Cycling Track
Pak Shek Kok Promenade
FO CHUN ROAD
Mayfair By the Sea
Mayfair By the Sea II
Club Mayfair
Podium
Tower 7
Tower 11
Tower 12
Lowrise 1
Lowrise 2
Lowrise 3
300DI08(E)
300DI06
300SV
200DI06(E)
250DI06(E)
200SV
150WOV
150GV
80DI08(E)
150GV
PH8706
100DAV
100GV
25GV
S 356737
S 356738
S 356741
S 356742
80GV
PH8705
150GV
PH8704
150WOV
250SV
250PRV
250DI20
250STR
250EMFM
250S20
M 369998
D 338042
300DI06(W18197.01.0002)
600DI06(E)(W18197.01.0002)
600SV
150SV
250DI15
150DI06(E)
PH8433
80DI14
100DI14
35DI14
42DI14
54DI14
67DI14
150DI14
28DI14
250DI14
200DI14
7-NE-11D

7-NE-12D

7-NE-17A

NOTES:

1. FOR MAINS RECORDS SIGN CONVENTIONS AND DESIGNATIONS SEE SKETCH NO.3988.
2. DIMENSIONS OF MAINS ARE IN MILLIMETRES UNLESS OTHERWISE SPECIFIED.
3. ALL LEVELS ARE IN METRES ABOVE PRINCIPAL DATUM.

Basemap Date Updated On: 23/12/2024

SCALE 1:1 000

METRES 20 10 0 20 40 60 80 100 METRES

THIS IS A COMPUTER PRINTOUT,
NO SIGNATURE IS REQUIRED.

FRESH WATER MAINS RECORD PLAN

HONG KONG SCIENCE PARK

COPYRIGHT RESERVED

DATE REVISED : 30/12/2024

DRAWING NO.

W67880/ 7-NE-12C

SIGNED
C.T. WONG
CE/NTE
DATE: 16/01/2008

Water Supplies Department
HONG KONG

© The Government of the Hong Kong SAR, Map reproduced with permission of the Director of Lands