INSET 'A'	INSET 'B'	INSET 'C'	INSET 'D'	INSET 'E'	INSET 'F'

7-NE-14A

7-NE-13D

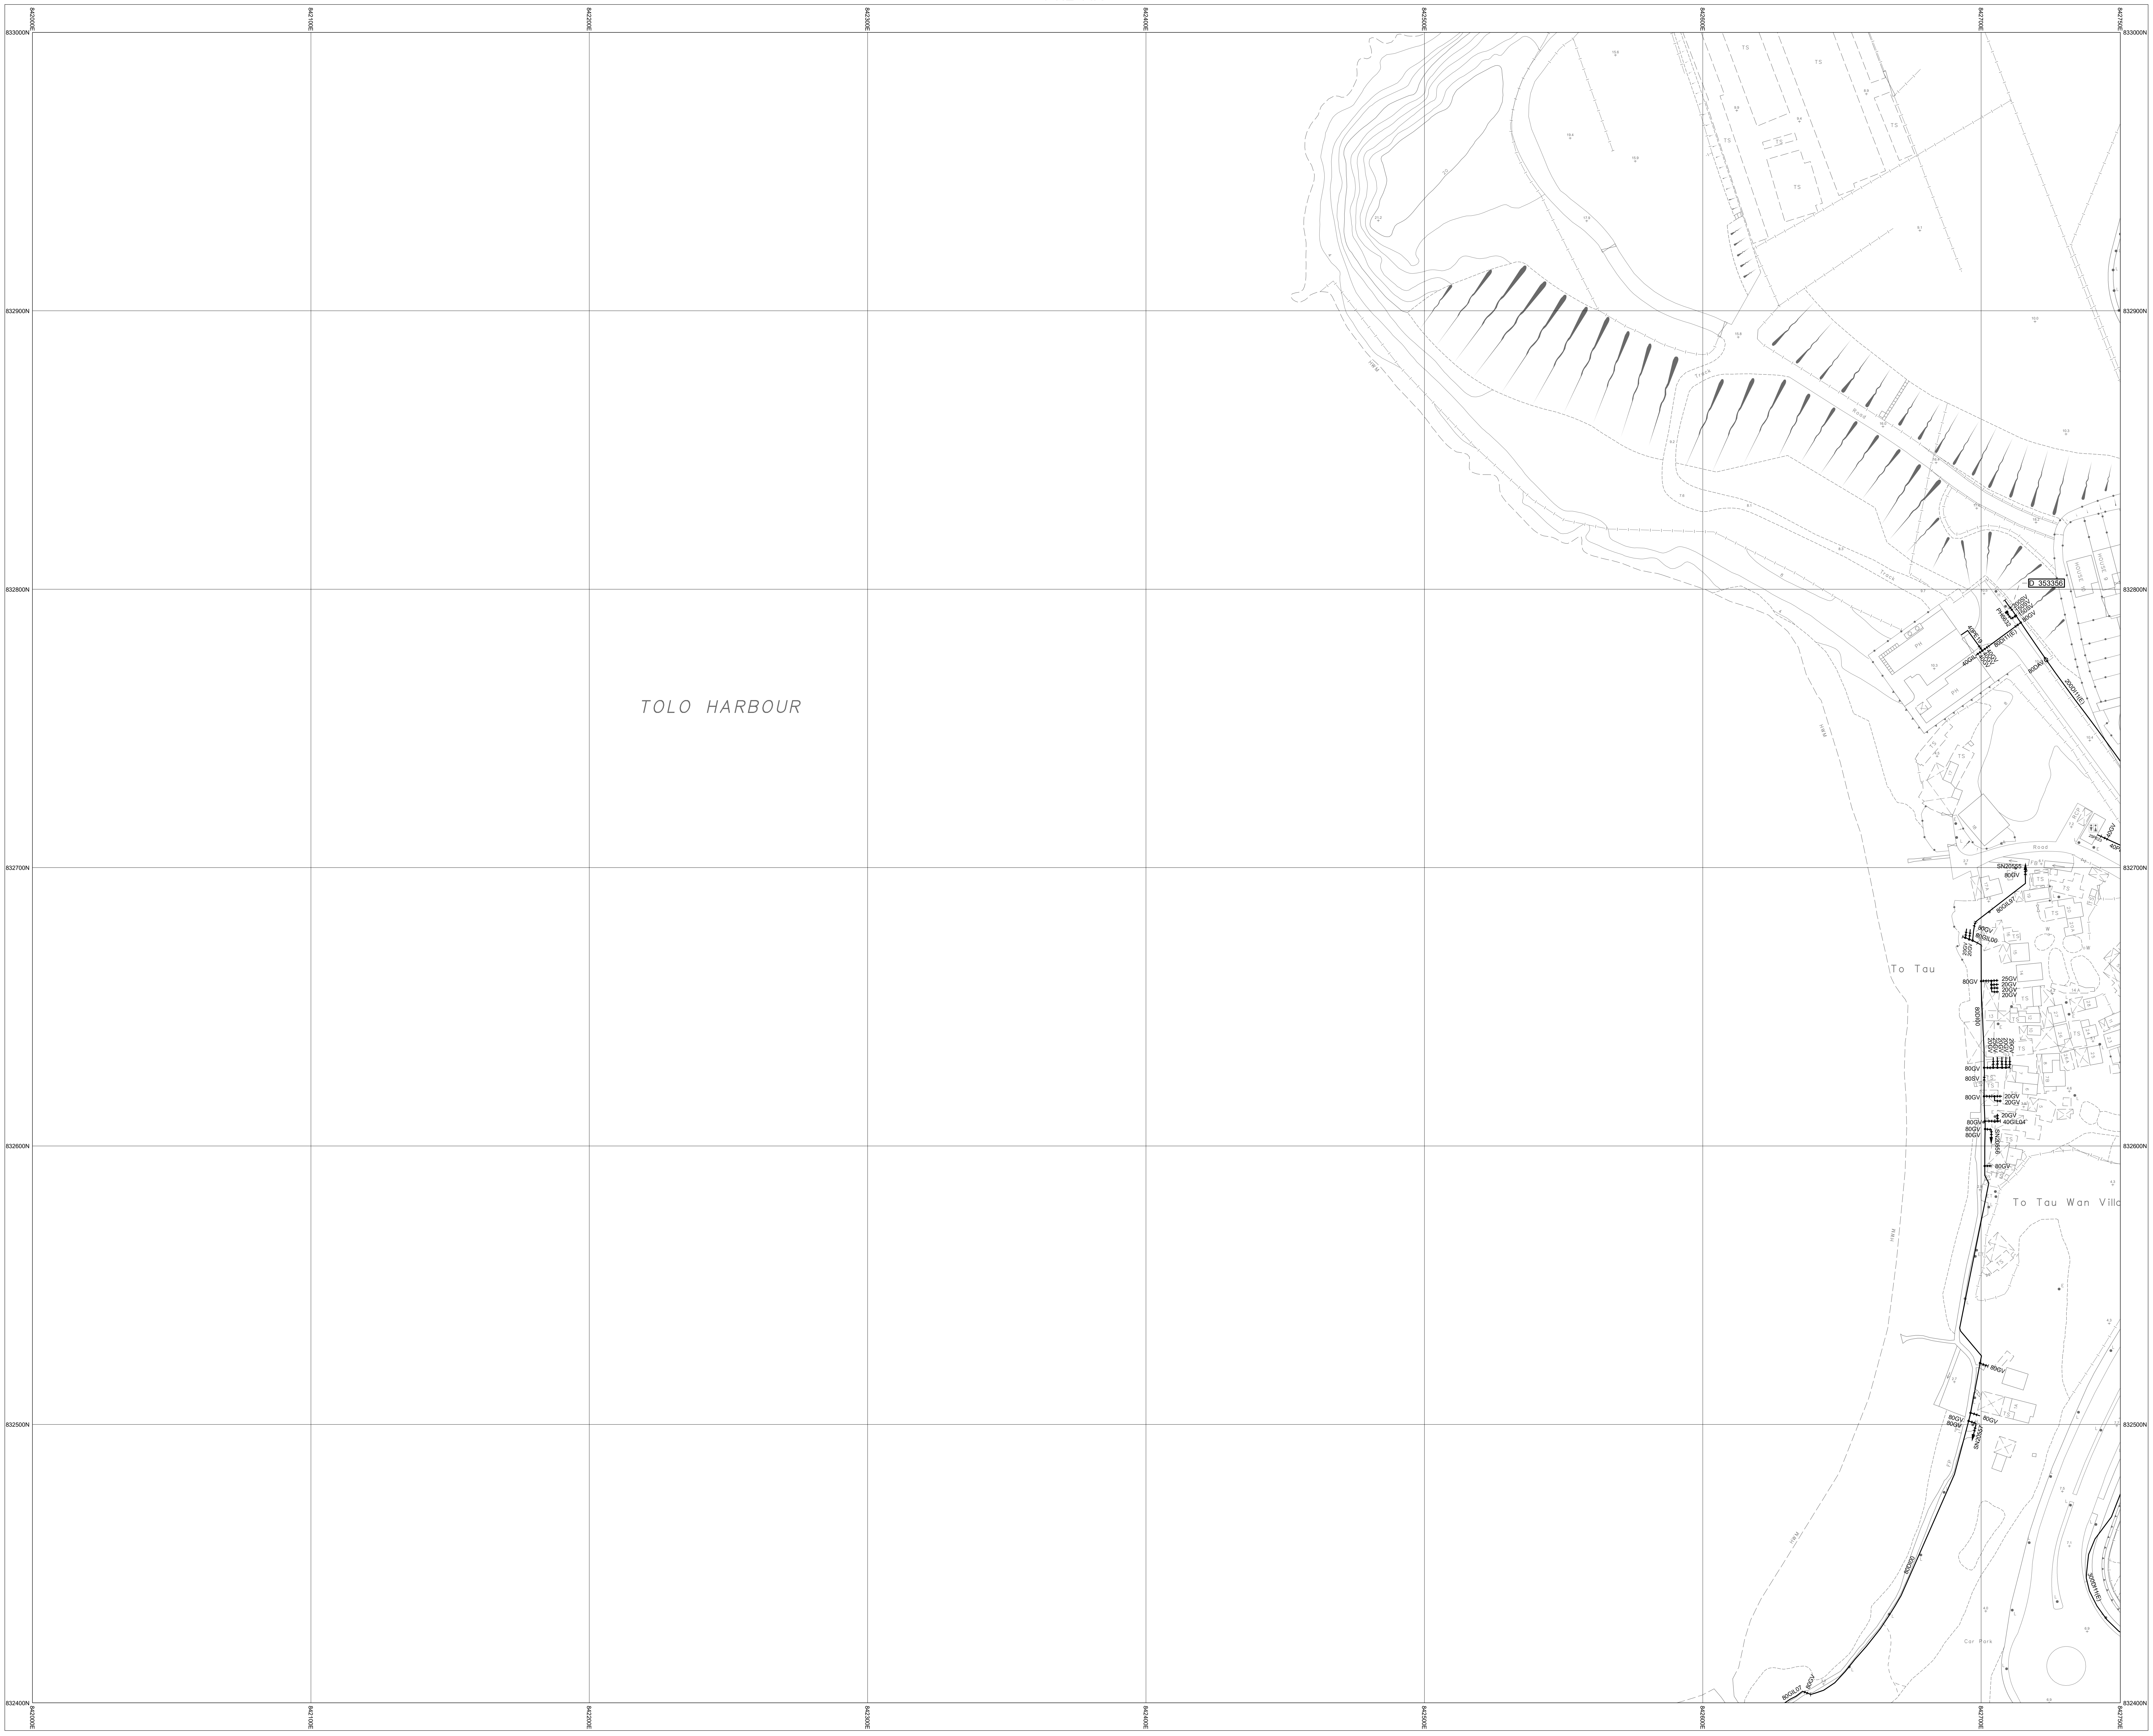
842000E
842100E
842200E
842300E
842400E
842500E
842600E
842700E
842750E
833000N
832900N
832800N
832700N
832600N
832500N
832400N
TOLO HARBOUR
HWM
Track
D 353356
200SV
150SV
150SV
80GV
PH6632
40PE19
80DI11(E)
40GV
40GIL
40GV
80DAV
200DI11(E)
PH
TS
Road
RCP
25PE23
40GV
SN20555
80GV
80GIL97
80GV
80GIL00
20GV
20GV
To Tau
80GV
25GV
20GV
20GV
20GV
80DI00
20GV
25GV
20GV
20GV
20GV
80GV
80SV
80GV
20GV
20GV
20GV
80GV
40GIL04
80GV
80GV
SN20556
80GV
To Tau Wan Villa
80GV
80GV
80GV
SN20557
FP
80DI00
300DI11(E)
Car Park
80GIL07
80GV

7-NE-14D

7-NE-19A

NOTES:

1. FOR MAINS RECORDS SIGN CONVENTIONS AND DESIGNATIONS SEE SKETCH NO.3988.
2. DIMENSIONS OF MAINS ARE IN MILLIMETRES UNLESS OTHERWISE SPECIFIED.
3. ALL LEVELS ARE IN METRES ABOVE PRINCIPAL DATUM.

Basemap Date Updated On: 05/01/2026

SCALE 1:1 000

METRES 20 10 0 20 40 60 80 100 METRES

FRESH WATER MAINS RECORD PLAN

TO TAU, TAI PO HOI

THIS IS A COMPUTER PRINTOUT,
NO SIGNATURE IS REQUIRED.

COPYRIGHT RESERVED

DATE REVISED : 02/03/2026

SIGNED
C.S. CHIN
CE/MNE
DATE: 23/04/1999

DRAWING NO.
W67880/ 7-NE-14C

Water Supplies Department
HONG KONG

© The Government of the Hong Kong SAR, Map reproduced with permission of the Director of Lands