INSET 'A'	INSET 'B'	INSET 'C'	INSET 'D'	INSET 'E'	INSET 'F'

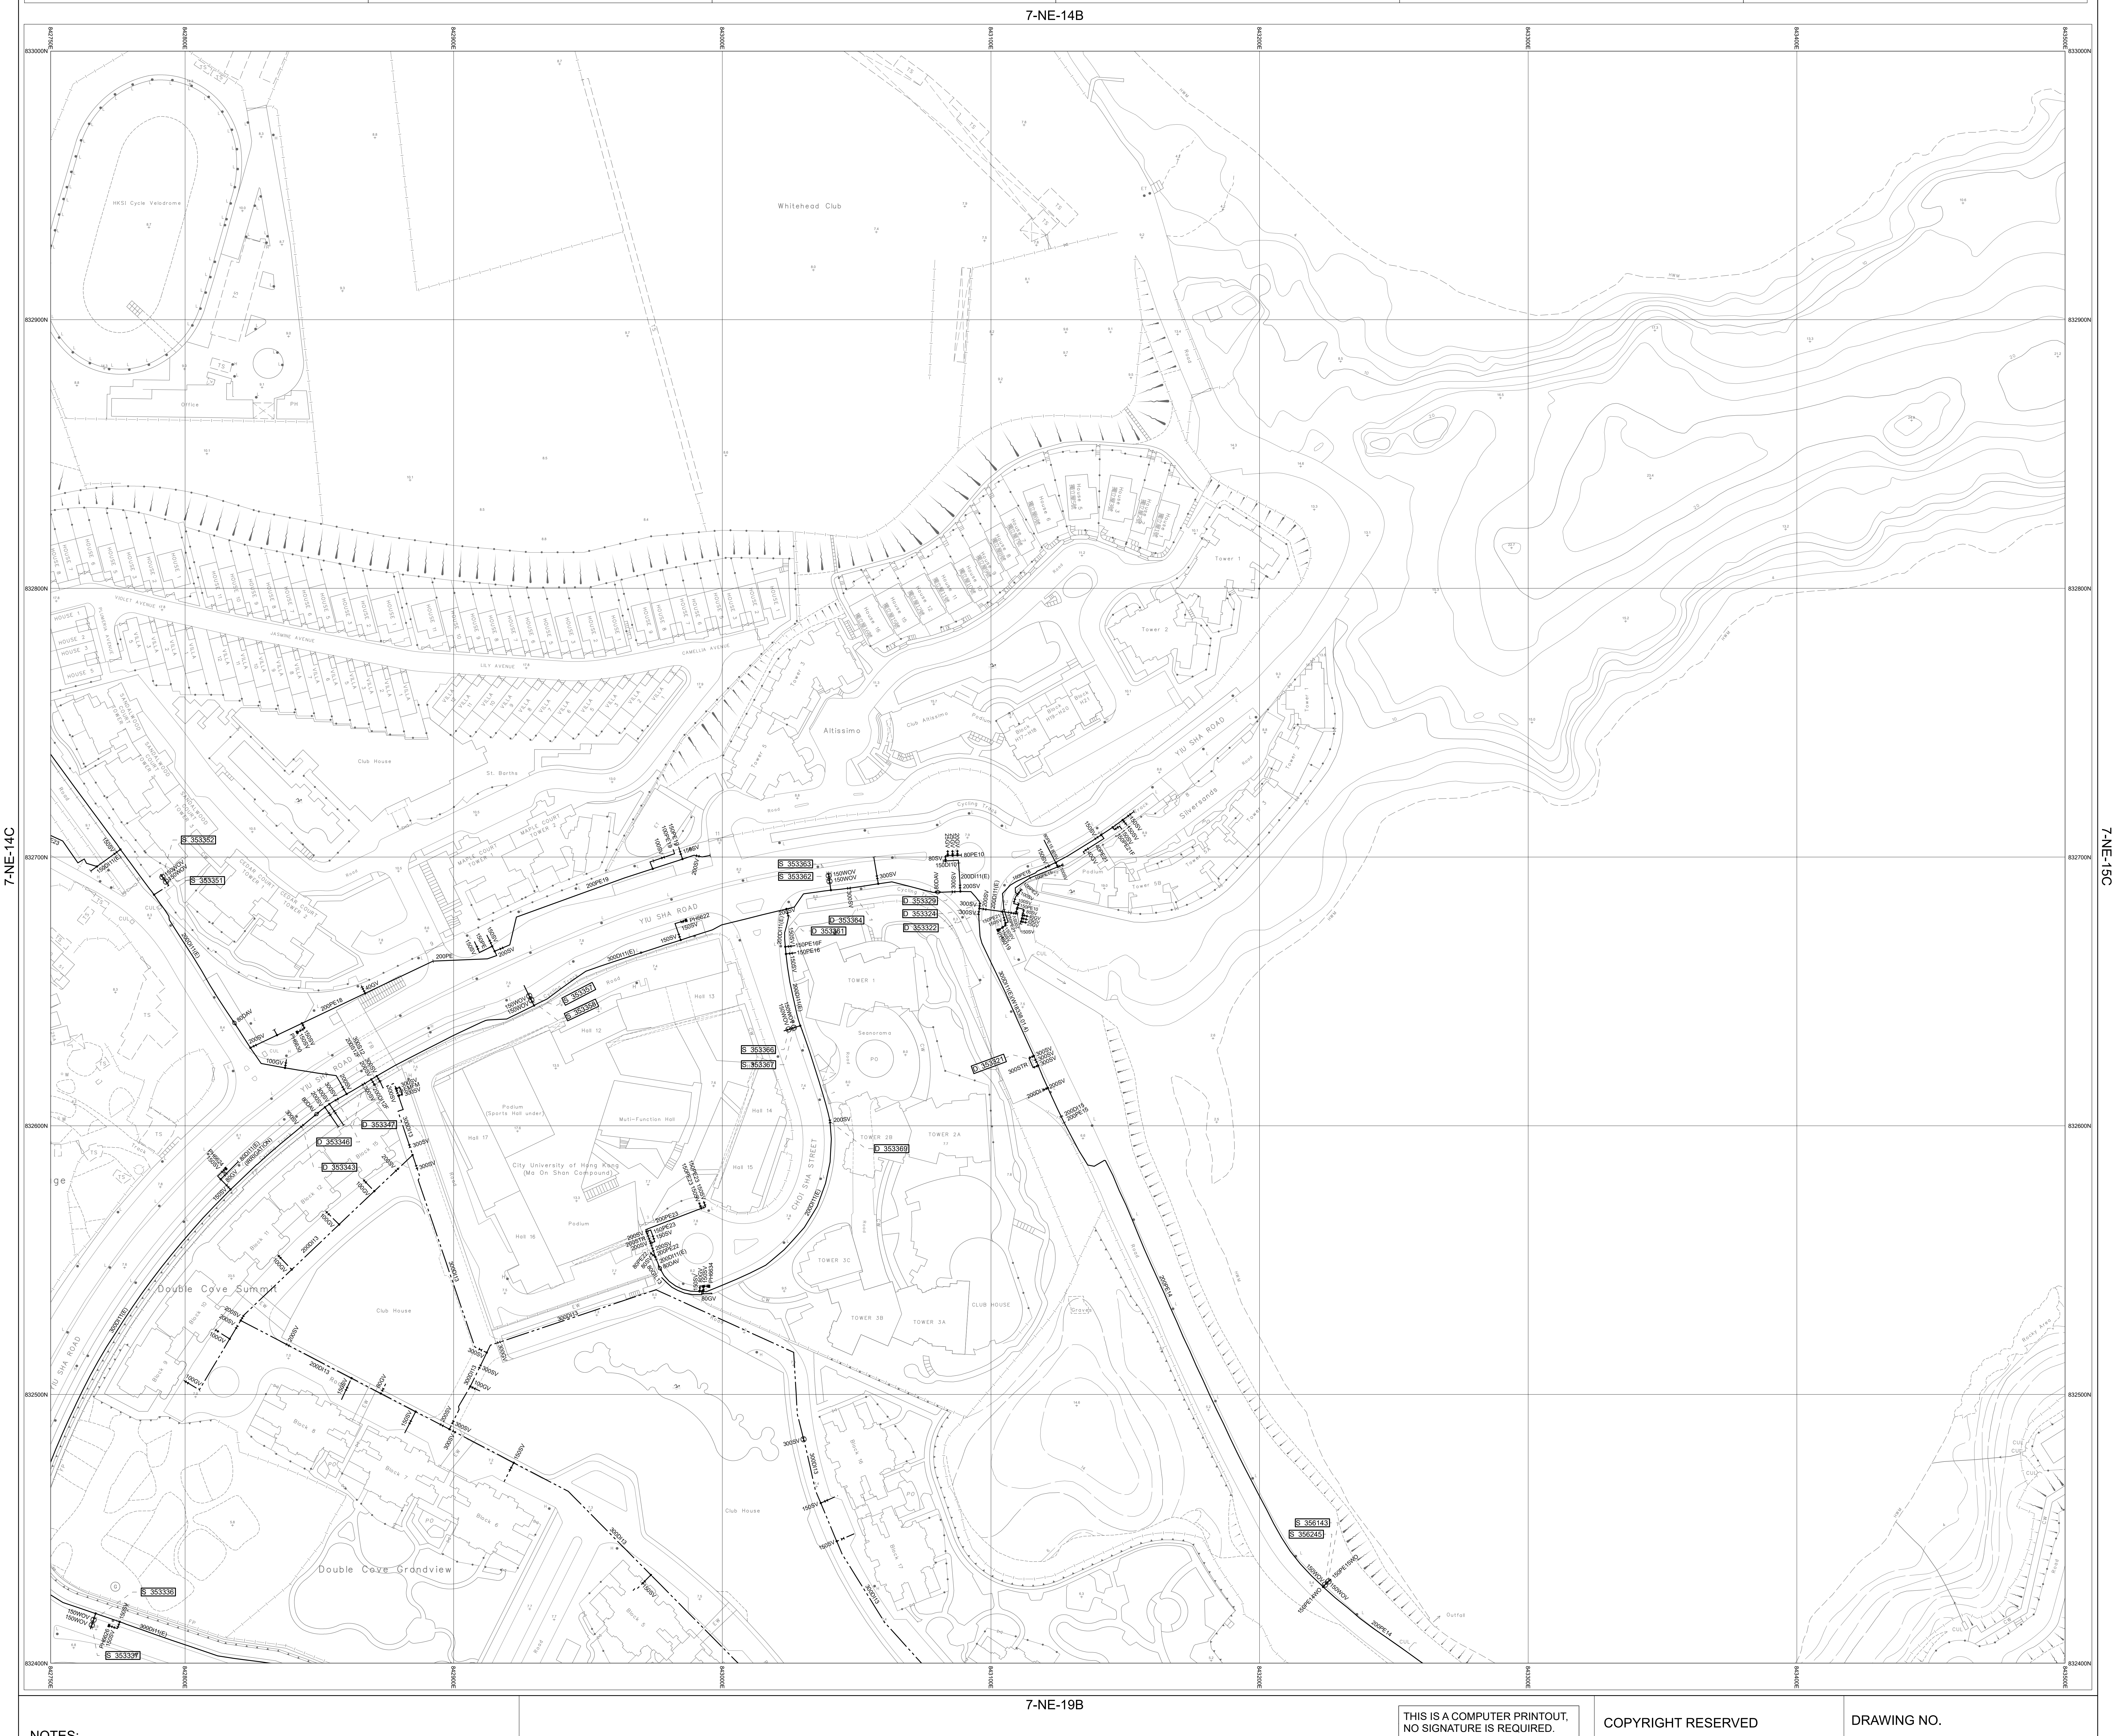
7-NE-14B
7-NE-14C
7-NE-15C
7-NE-19B
HKSI Cycle Velodrome
Whitehead Club
Altissimo
Club Altissimo
Silversands
YIU SHA ROAD
CHOI SHA STREET
Cycling Track
Seanorama
TOWER 1
TOWER 2A
TOWER 2B
TOWER 3A
TOWER 3B
TOWER 3C
CLUB HOUSE
City University of Hong Kong (Ma On Shan Compound)
Muti-Function Hall
Hall 13
Hall 14
Hall 15
Double Cove Summit
Double Cove Grandview
Club House
S 353363
S 353362
D 353364
D 353361
D 353329
D 353324
D 353322
D 353321
S 353366
S 353367
D 353369
S 356143
S 356245
S 353336

NOTES:

1. FOR MAINS RECORDS SIGN CONVENTIONS AND DESIGNATIONS SEE SKETCH NO.3988.
2. DIMENSIONS OF MAINS ARE IN MILLIMETRES UNLESS OTHERWISE SPECIFIED.
3. ALL LEVELS ARE IN METRES ABOVE PRINCIPAL DATUM.

Basemap Date Updated On: 23/12/2024

SCALE 1:1 000

METRES 20 10 0 20 40 60 80 100 METRES

THIS IS A COMPUTER PRINTOUT,
NO SIGNATURE IS REQUIRED.

FRESH WATER MAINS RECORD PLAN

TO TAU, TAI PO HOI

COPYRIGHT RESERVED

DATE REVISED : 05/03/2025

SIGNED
C.S. CHIN
CE/MNE
DATE: 23/04/1999

DRAWING NO.
W67880/ 7-NE-14D

Water Supplies Department
HONG KONG

© The Government of the Hong Kong SAR, Map reproduced with permission of the Director of Lands